HEREBY CERTIFY THAT I HAVE PREPARED THIS SITE PLAN, AND THAT THE BEARINGS, STANCES, LOCATION OF PROPERTY PINS, AND OTHER PARTICULARS SHOWN ARE CORRECT.

TE: 4/17/78

ROBERT J. ALBAN, P.E.
REGISTERED CIVIL ENGINEER AND LAND SURVEYOR

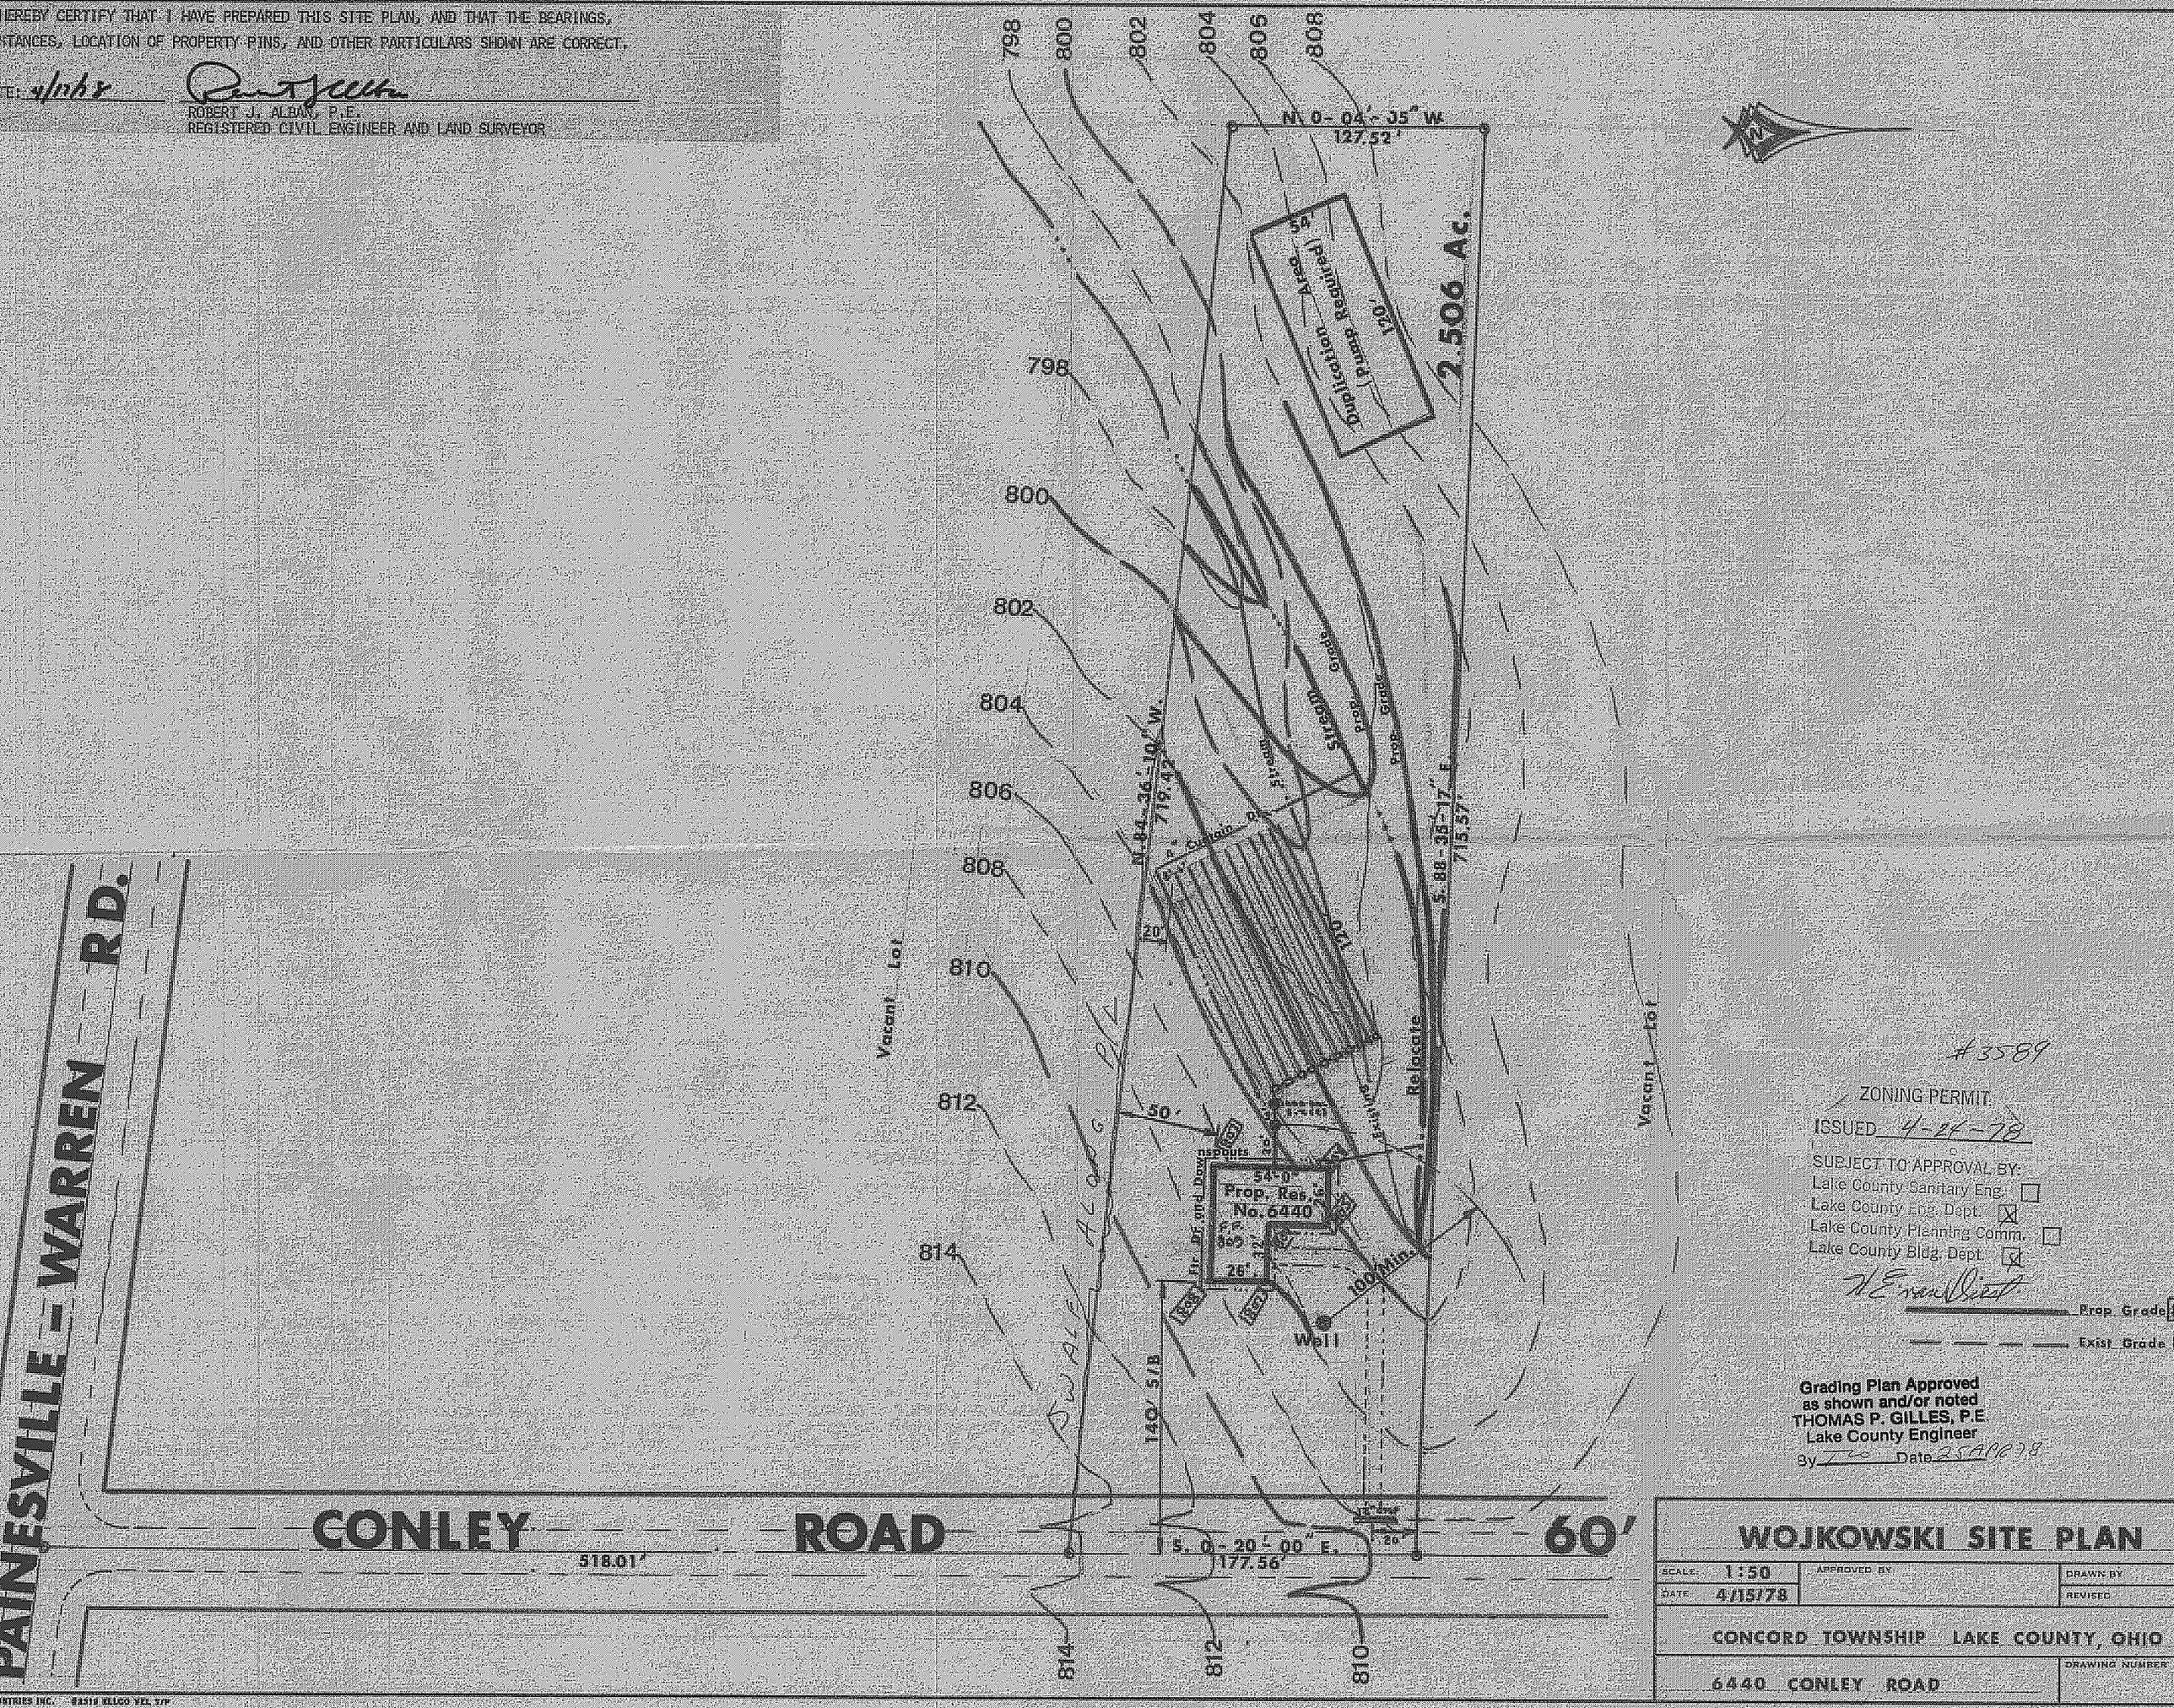

#3589

ZONING PERMIT
ISSUED 4-24-78
SUBJECT TO APPROVAL BY:
Lake County Sanitary Eng. ☐
Lake County Eng. Dept. ☒
Lake County Planning Comm. ☐
Lake County Bldg. Dept. ☒

Prop Grade
Exist Grade

Grading Plan Approved as shown and/or noted
THOMAS P. GILLES, P.E.
Lake County Engineer
By [illegible] Date 25 APR 78

WOJKOWSKI SITE PLAN

SCALE 1:50	APPROVED BY	DRAWN BY
DATE 4/15/78		REVISED

CONCORD TOWNSHIP LAKE COUNTY, OHIO

6440 CONLEY ROAD

DRAWING NUMBER

STRIES INC. 82510 ELLCO VEL 7/P