SITE PLAN FOR:

RYAN HOMES
23600 MERCANTILE RD.
BEACHWOOD, OHIO.

BEING SUBLOT NO 43 IN THE MORLEY HILLS ESTATES SUBDIVISION NO 2. LOCATED IN CONCORD TWP., OHIO.

PREPARED BY:

WM. R. GRAY ASSOC. INC.
7547 MENTOR AVENUE
MENTOR, OHIO. 44060

DATE: APRIL 5, 1976 SCALE 1" = 20'

CERTIFICATION:

I HEREBY CERTIFY THAT THIS PLAT IS CORRECT TO THE BEST OF MY KNOWLEDGE.

BY Wm. R. Gray
WM. R. GRAY REG. SURV. 2752

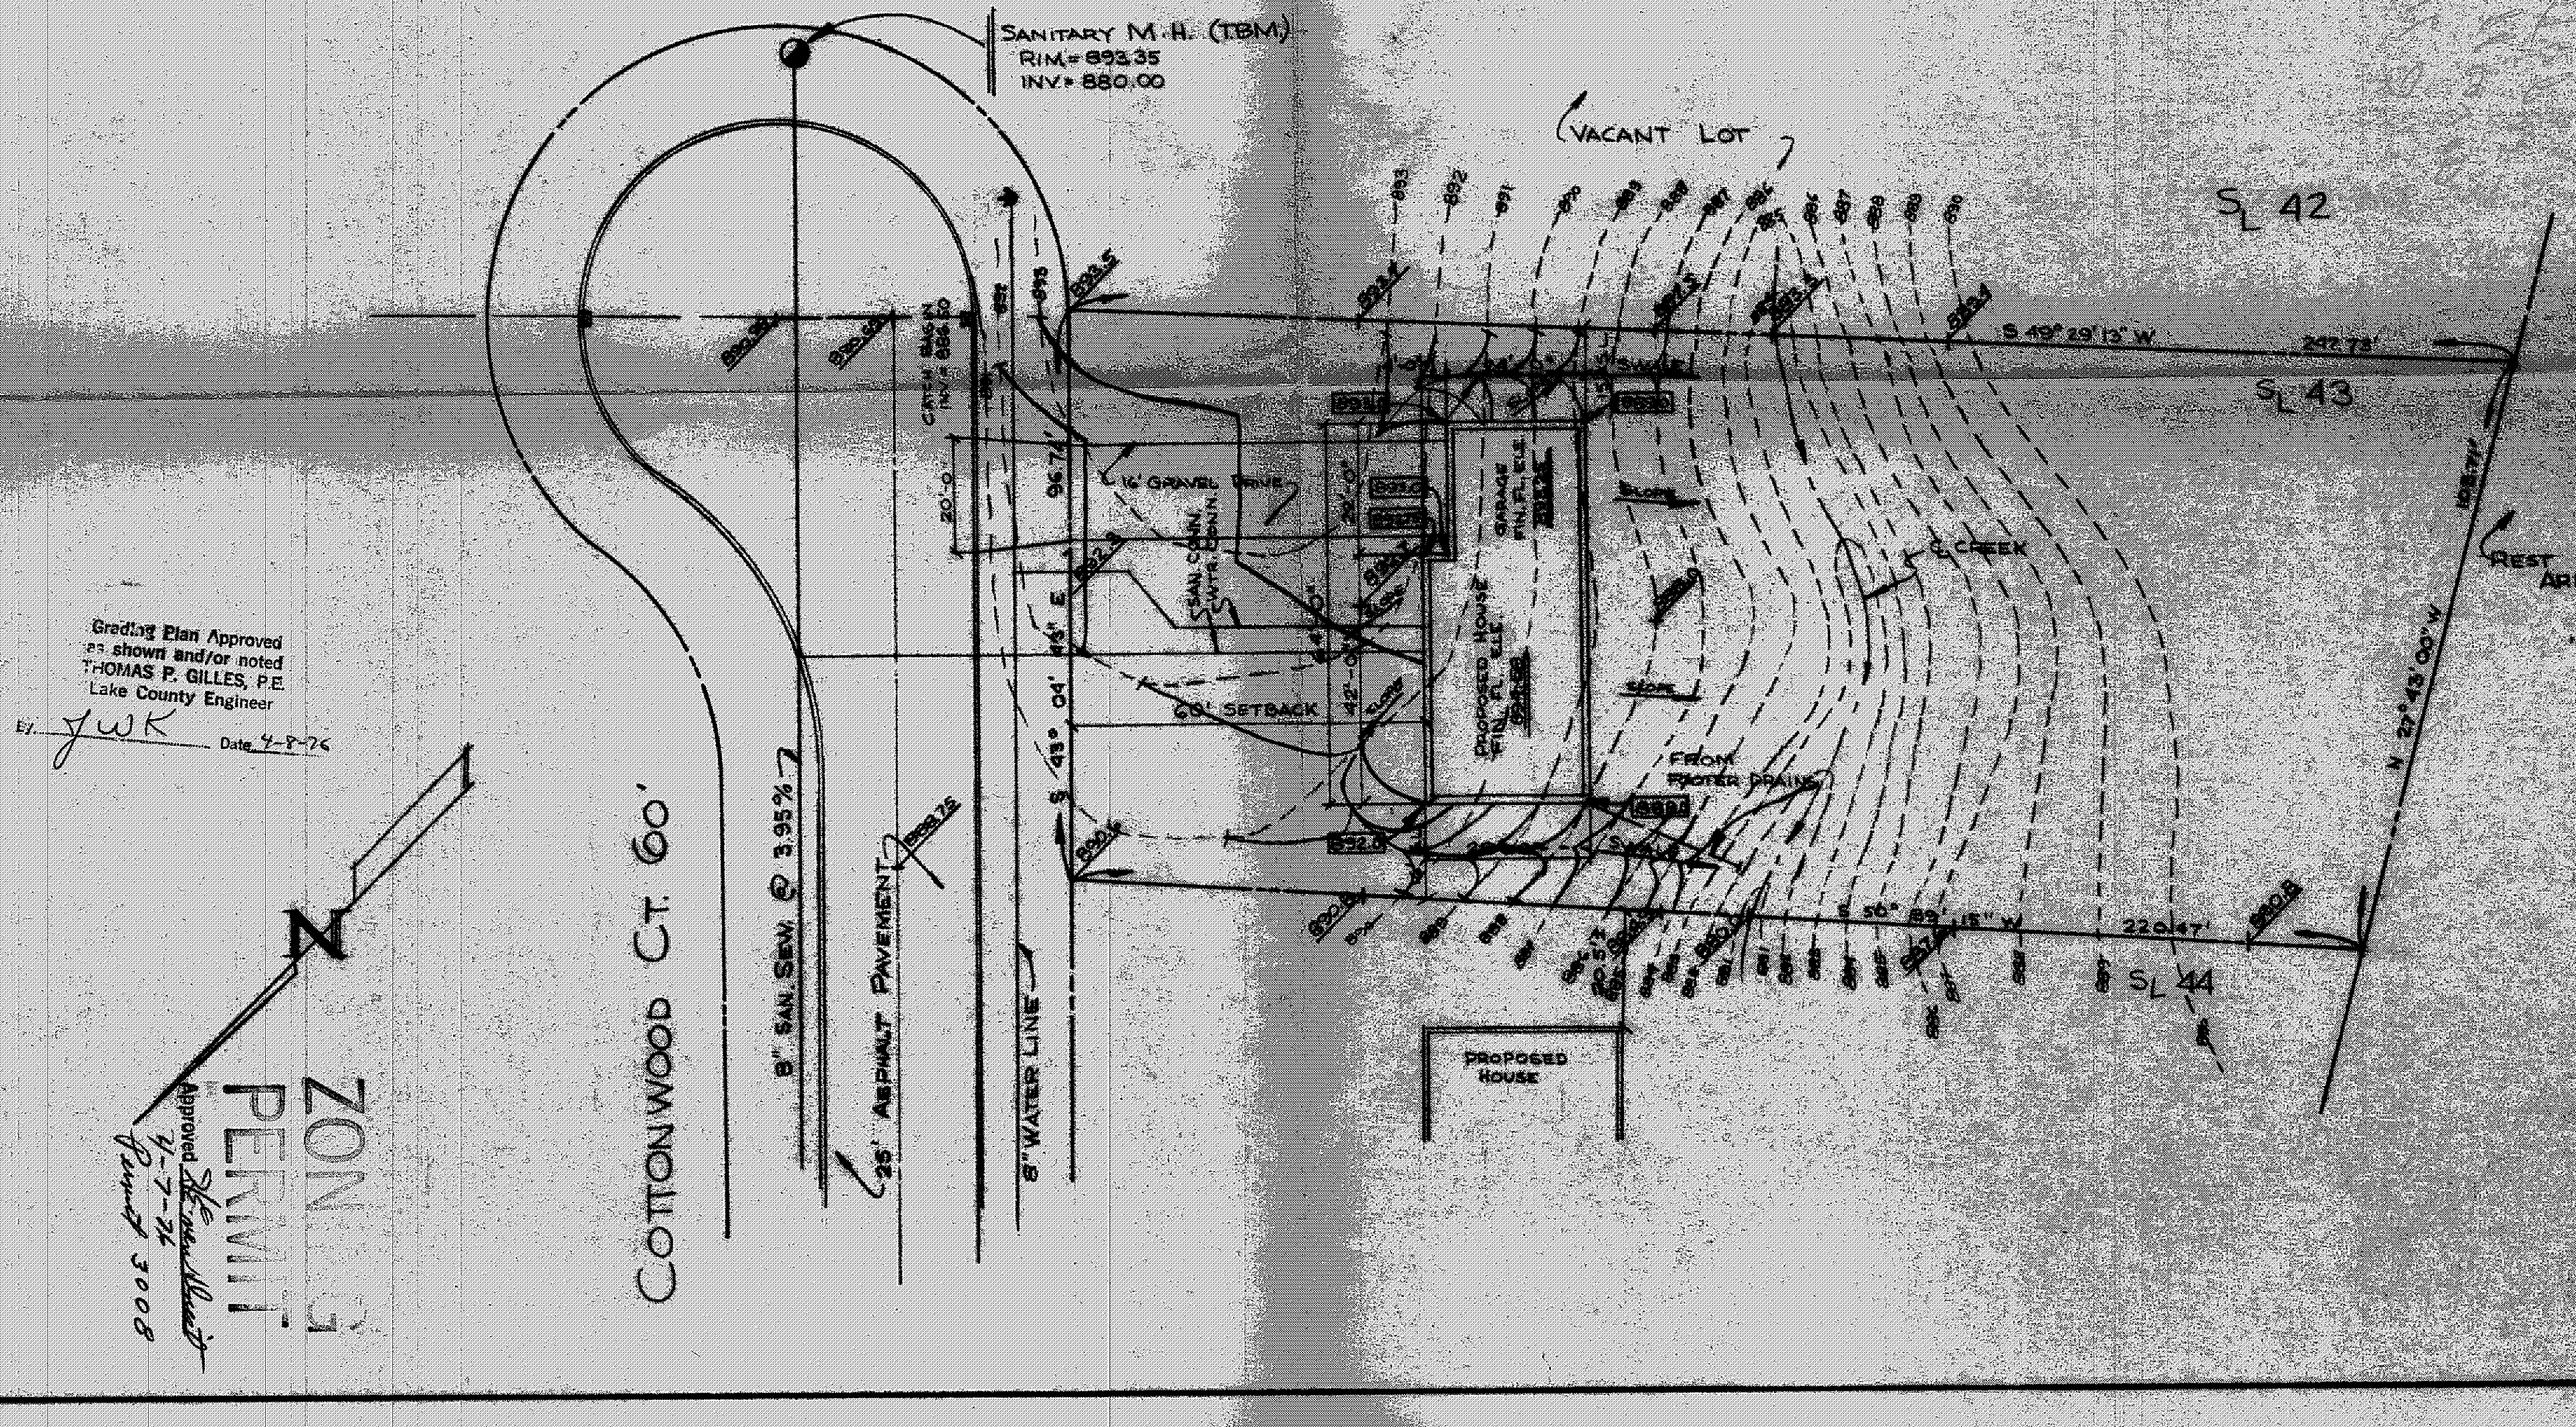

Grading Plan Approved as shown and/or noted
THOMAS P. GILLES, P.E.
Lake County Engineer
By JWK Date 4-8-76