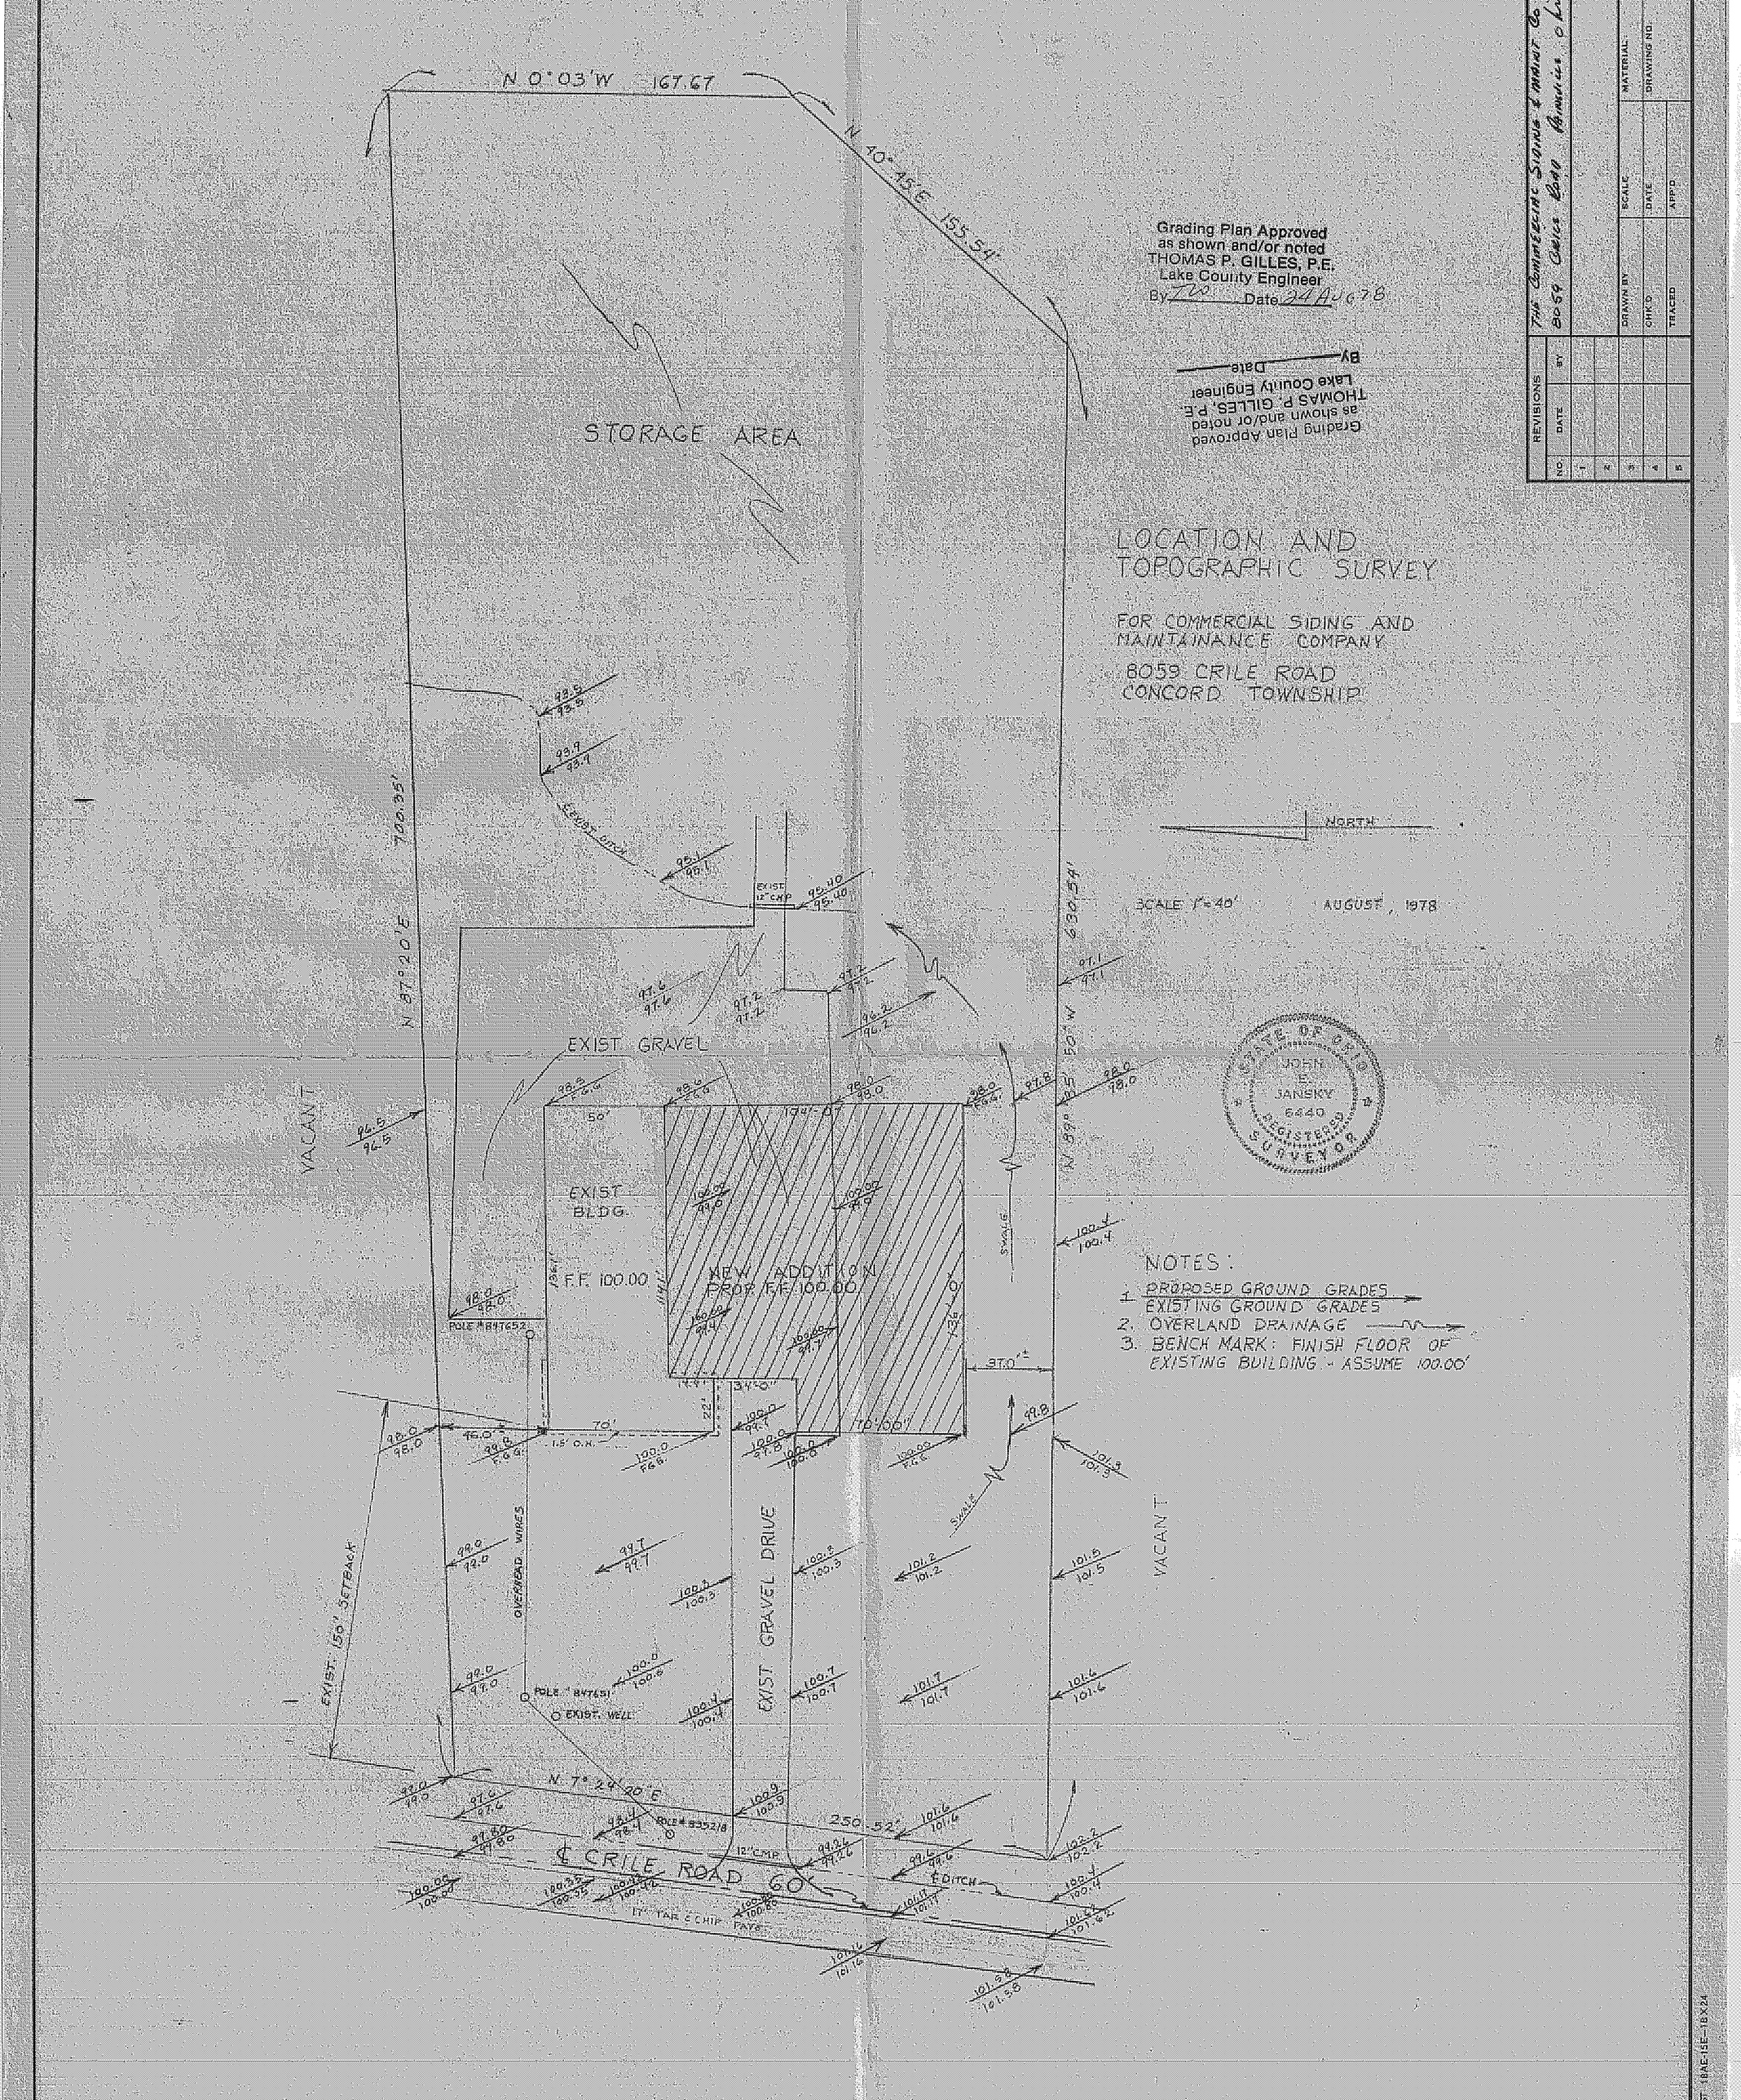

Grading Plan Approved
as shown and/or noted
THOMAS P. GILLES, P.E.
Lake County Engineer
By TPG Date 24 Aug 78

Grading Plan Approved
as shown and/or noted
THOMAS P. GILLES, P.E.
Lake County Engineer
By Date

LOCATION AND TOPOGRAPHIC SURVEY

FOR COMMERCIAL SIDING AND MAINTAINANCE COMPANY

8059 CRILE ROAD
CONCORD TOWNSHIP

STATE OF OHIO
JOHN E. JANSKY
6440
REGISTERED SURVEYOR

NOTES:

1. PROPOSED GROUND GRADES
   EXISTING GROUND GRADES
2. OVERLAND DRAINAGE
3. BENCH MARK: FINISH FLOOR OF EXISTING BUILDING - ASSUME 100.00'

REVISIONS		
NO.	DATE	BY
1		
2		
3		
4		
5		

THE COMMERCIAL SIDING & MAINT. CO.
8059 CRILE ROAD PAINSVILLE, OHIO

DRAWN BY
CHK'D
TRACED
SCALE
DATE
APP'D
MATERIAL
DRAWING NO.