DIVISION OF BUILDING INSPECTION

This [illegible] object

Charles Fitzpatrick

sh

Grading Plan Approved as shown and/or noted
THOMAS P. GILLES, P.E.
Lake County Engineer
By [signature] Date 5-17-79

T.B.M = NAIL IN TREE AT 846.27

X0.00 EXIST ELEV.
0.00 PROP ELEV

SITE PLAN FOR

SHANDLE CONSTRUCTION
8353 MENTOR AVE
MENTOR, OHIO
BEING A PART OF MORLEY HILLS ESTATES SUBDIVISION NO. 3. AND BEING SUB LOT NO. 129, IN CONCORD TOWNSHIP OHIO

HOUSE PLAN REVERSED 5-16-79

PREPARED BY

WM. R GRAY ASSOC. INC.
7597 MENTOR AVE
MENTOR, OHIO

DATE: APRIL 28, 1978
SCALE: 1" = 30'
REVISED: MAY 16, 1979

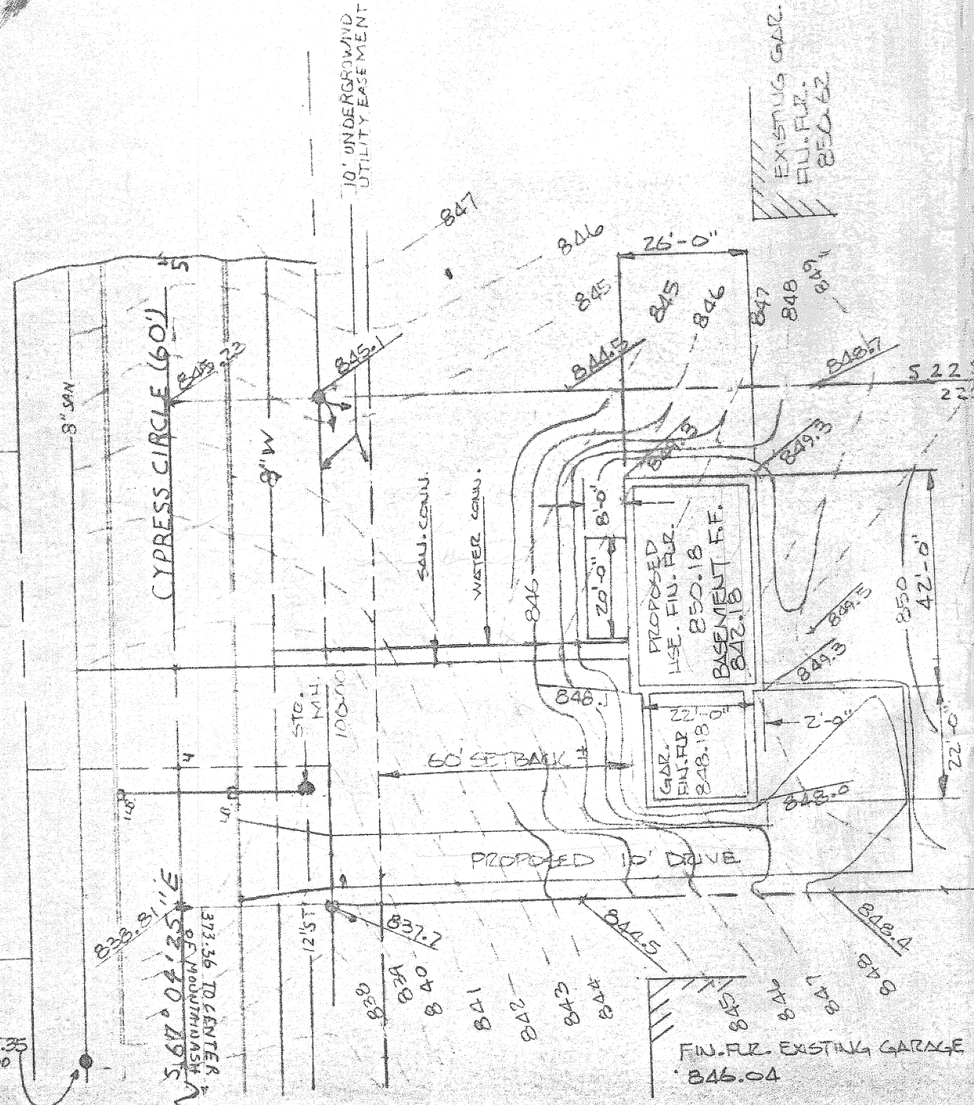

ZONING PERMIT
3897
ISSUED 4-16-79
[signature]
SUBJECT TO APPROVAL BY:
Lake County Sanitary Eng. ☐
Lake County Eng. Dept. ☒
Lake County Planning Comm. ☐
Lake County Bldg. Dept. ☒

CERTIFICATION

I HEREBY CERTIFY THAT THIS PLAT IS CORRECT TO THE BEST OF MY KNOWLEDGE

BY Wm. R. Gray
WM R GRAY REG. SURV. # 2752

STATE OF OHIO
WM. R. GRAY
2752
REGISTERED PROFESSIONAL SURVEYOR