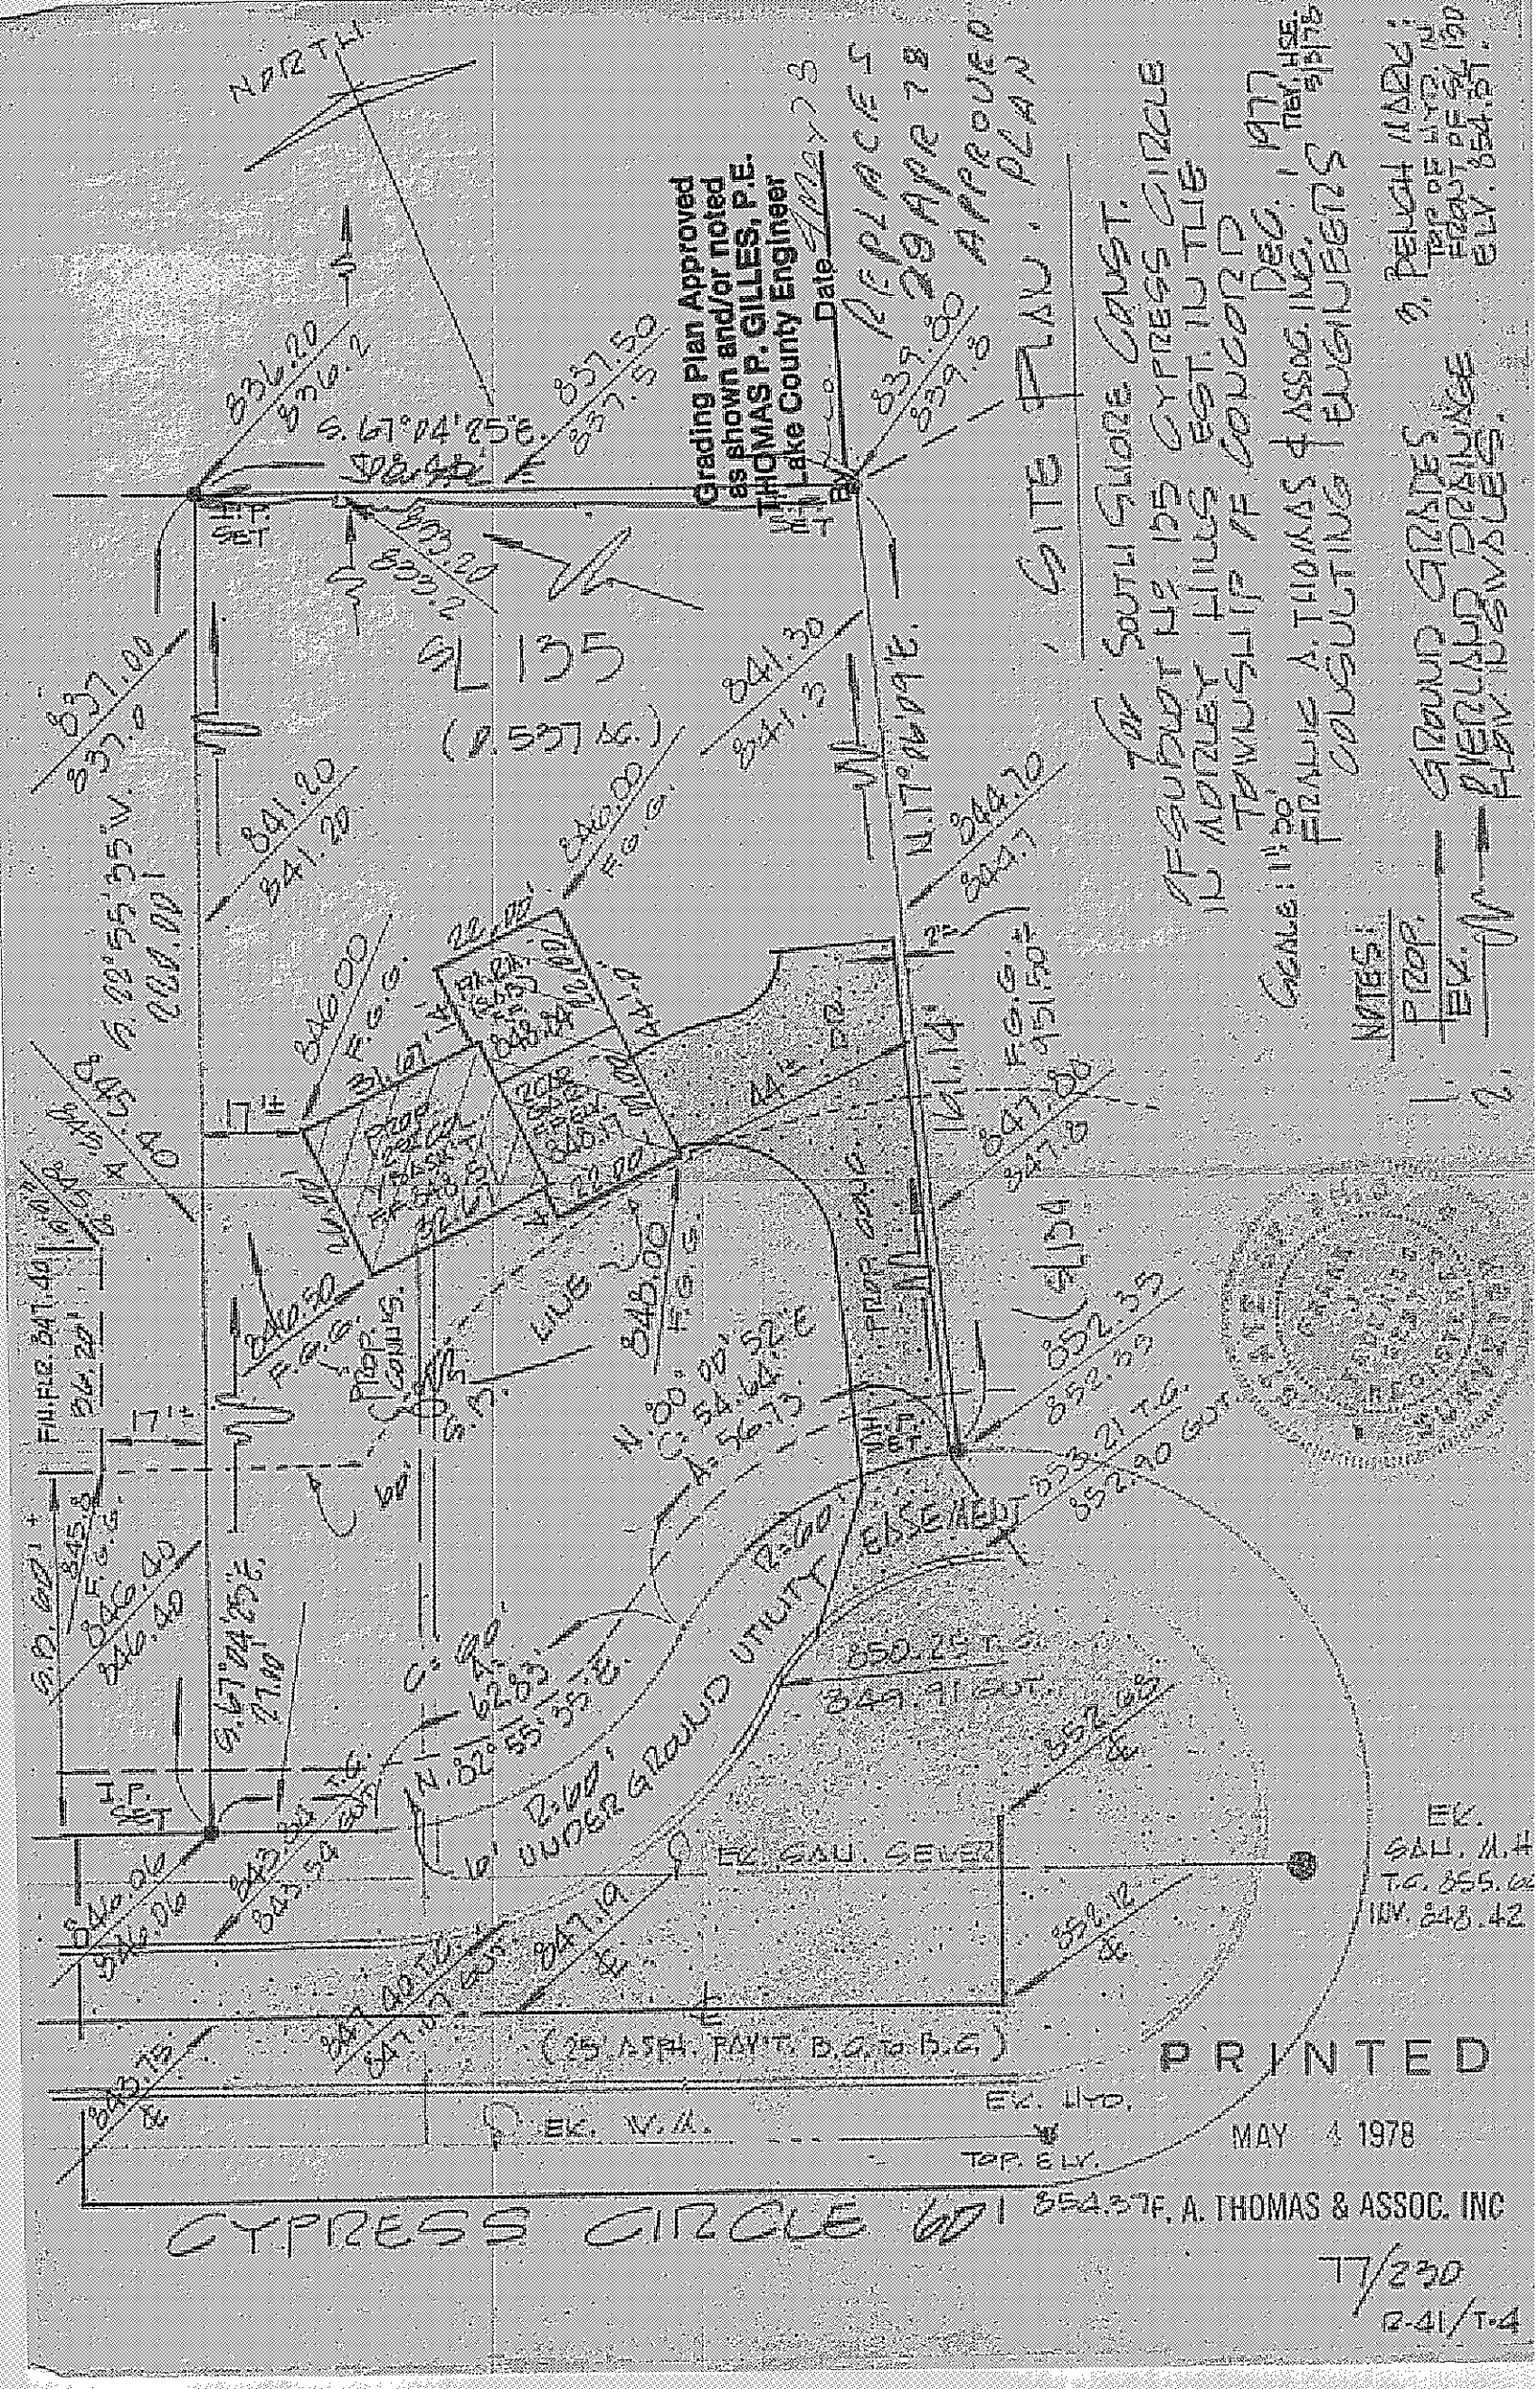

NORTH
Grading Plan Approved as shown and/or noted
THOMAS P. GILLES, P.E.
Lake County Engineer
Date
REPLACES 29 APR 78 APPROVED PLAN
SITE PLAN
SOUTH SHORE CONST.
OF SUBLOT NO. 135 CYPRESS CIRCLE
IN MORLEY HILLS EST. IN THE
TOWNSHIP OF CONCORD
DEC. 1977
FRANK A. THOMAS & ASSOC. INC.
CONSULTING ENGINEERS
GRADES
GROUND
OVERLAND
FLOW IN SWALES.
NOTES:
PROP.
EK.
SL 135
(0.537 AC.)
EASEMENT
UNDER GROUND UTILITY
EK. SAN. SEWER
(25' ASPH. PAV'T. B.G. to B.G.)
EK. W.M.
EK. HYD.
TOP. ELV.
EK. SAN. M.H.
T.G. 855.6
INV. 848.42
PRINTED
MAY 4 1978
F. A. THOMAS & ASSOC. INC
CYPRESS CIRCLE 60'
77/230
R-41/T-4