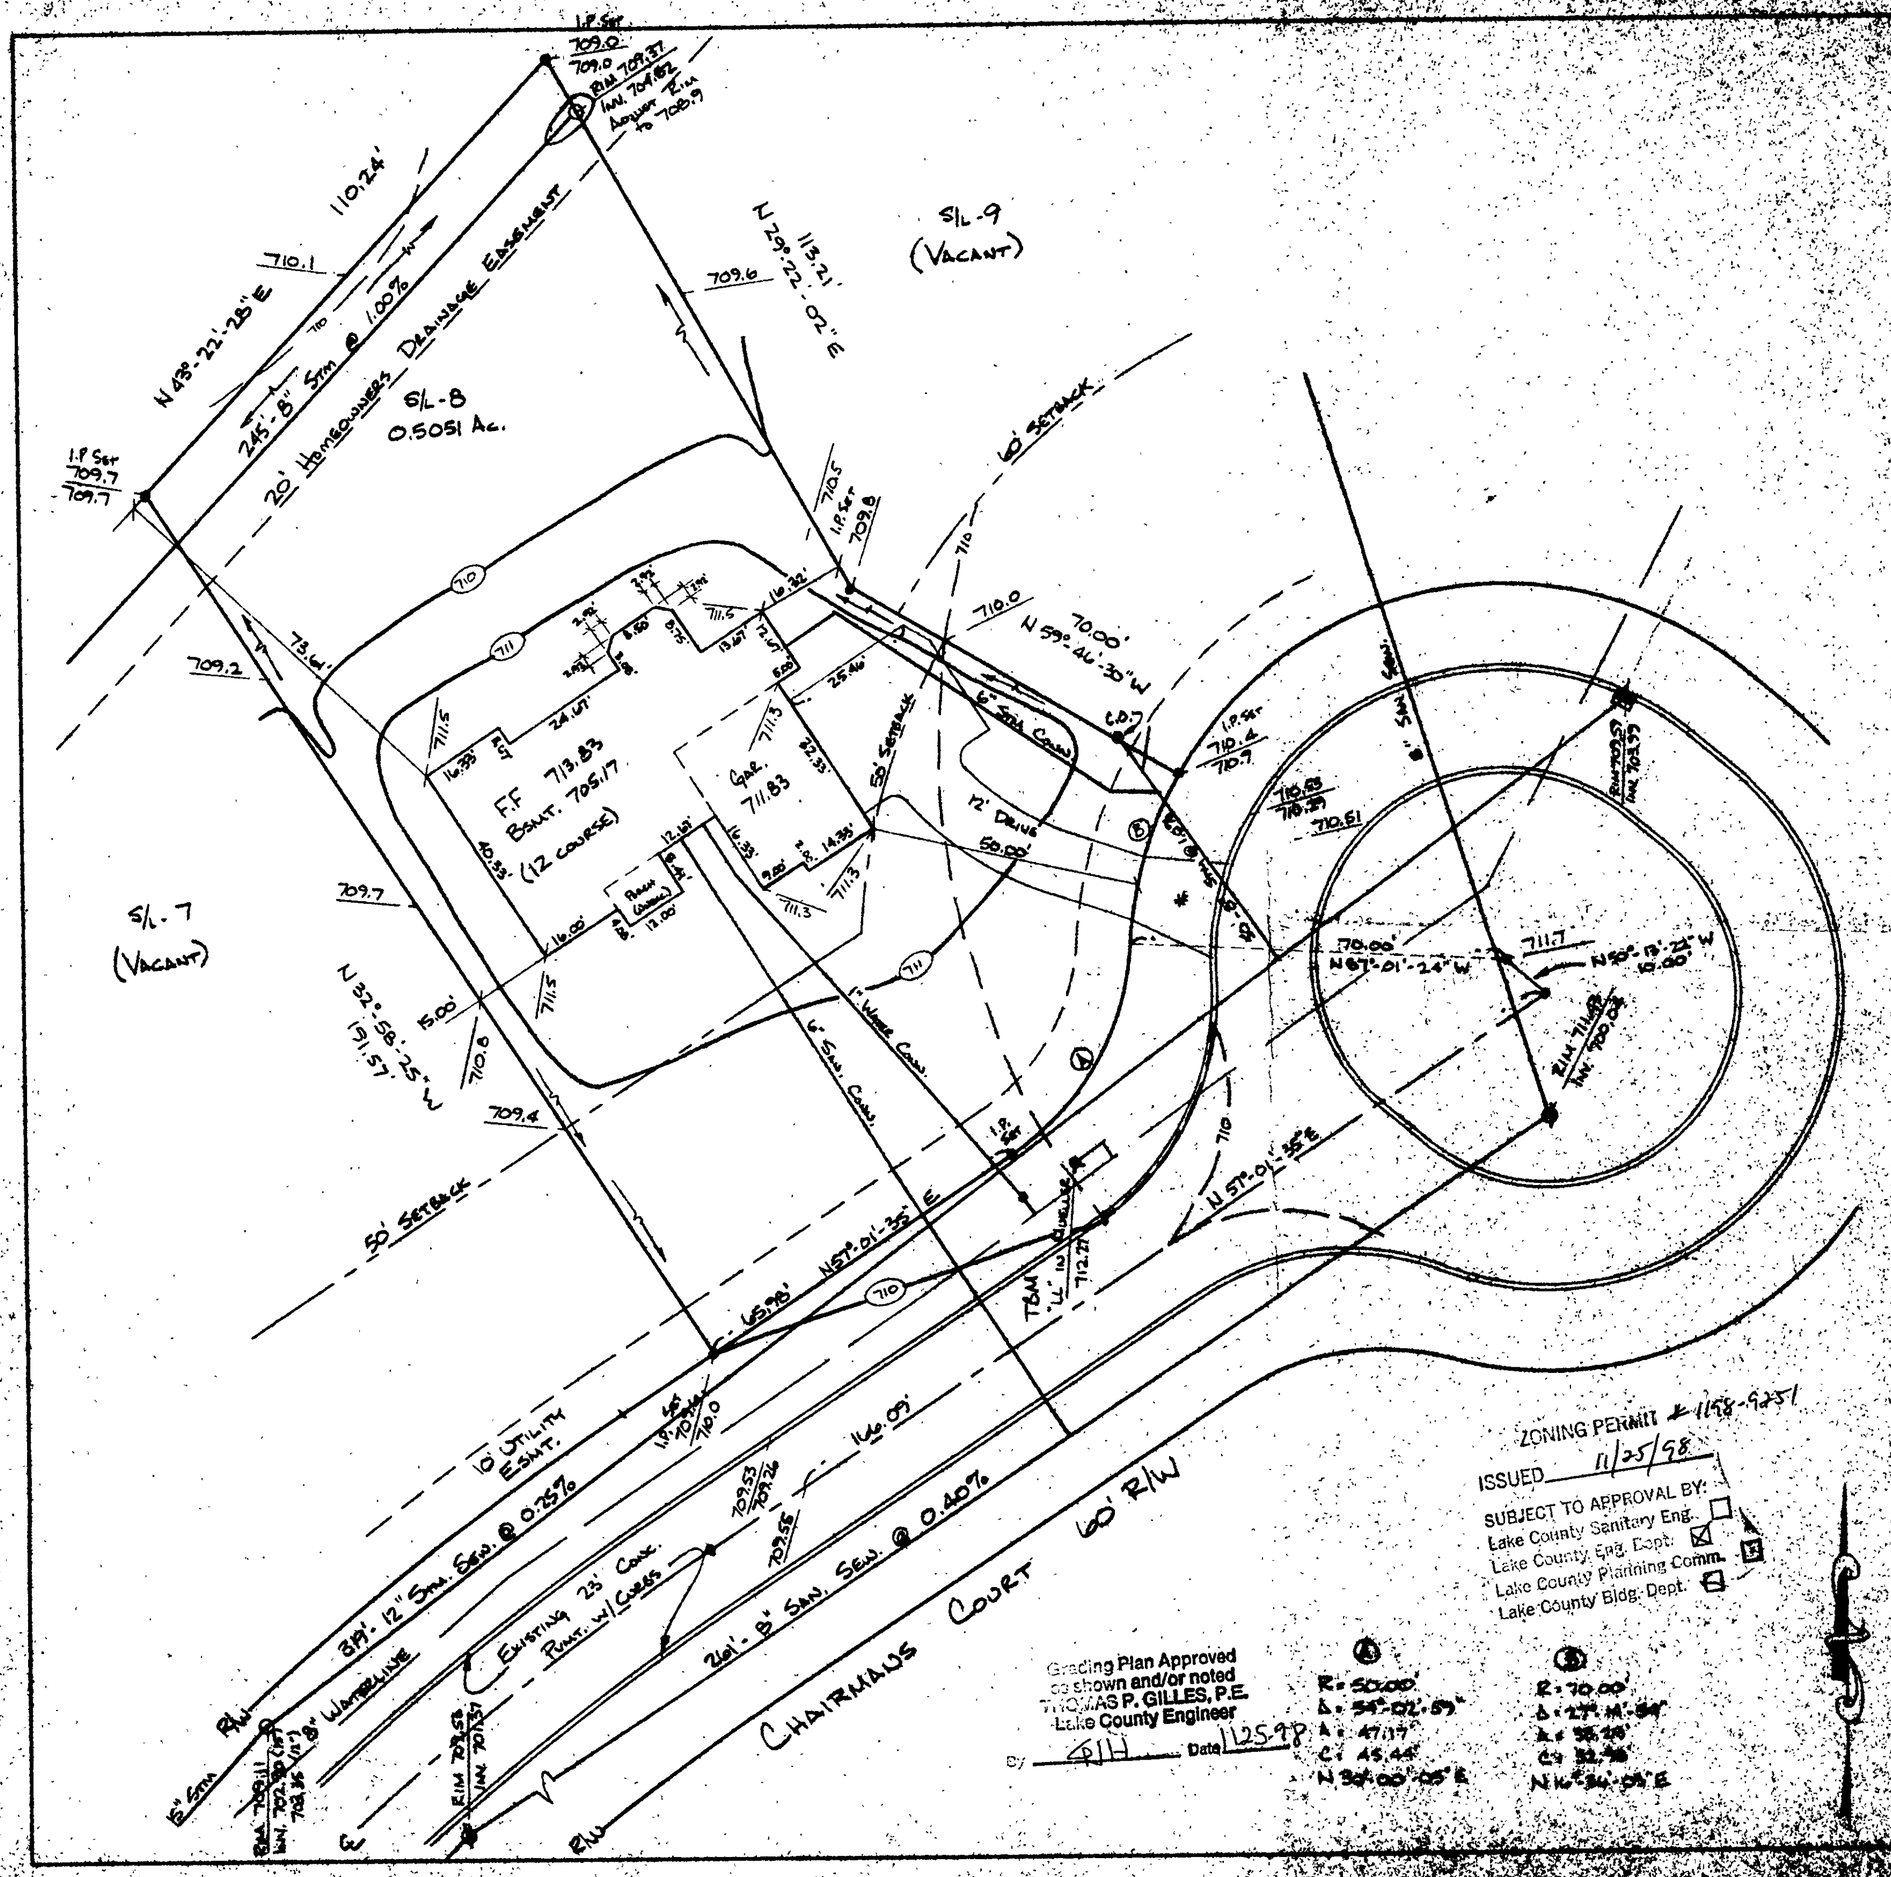

ZONING PERMIT # 1198-9251

ISSUED 11/25/98

SUBJECT TO APPROVAL BY:
Lake County Sanitary Eng. ☐
Lake County Eng. Dept. ☒
Lake County Planning Comm. ☒
Lake County Bldg. Dept. ☒

Grading Plan Approved as shown and/or noted
THOMAS P. GILLES, P.E.
Lake County Engineer
By GJH Date 11-25-98

Ⓐ
R = 50.00'
Δ = 54°-02'-59"
A = 47.17'
C = 45.44'
N 30°-00'-05" E

Ⓑ
R = 70.00'
Δ = 27°-14'-54"
A = 35.28'
C = 32.98'
N 16°-34'-05" E

CHECK LIST

THIS PLAT WAS PREPARED ... TO THE BEST OF MY ...

I HEREBY CERTIFY THAT THE ... AS OBTAINED ON THIS ... CORRECT TO THE BEST OF ...

LEGEND
STORM MANHOLE
SANITARY MANHOLE
EXISTING CONTOURS
PROPOSED CONTOURS
EXIST. ELEV.
DIRECTION OF SURFACE DRAINAGE

BENCHMARK

* DRIVE APRON AND ... 6" THICK CONCRETE

2 WORKING DAYS BEFORE ... CALL TOLL FREE ... OHIO UTILITIES PROTECTION ...

CONTRACTOR SHALL ... OF LATERAL ... THE TIME OF ...