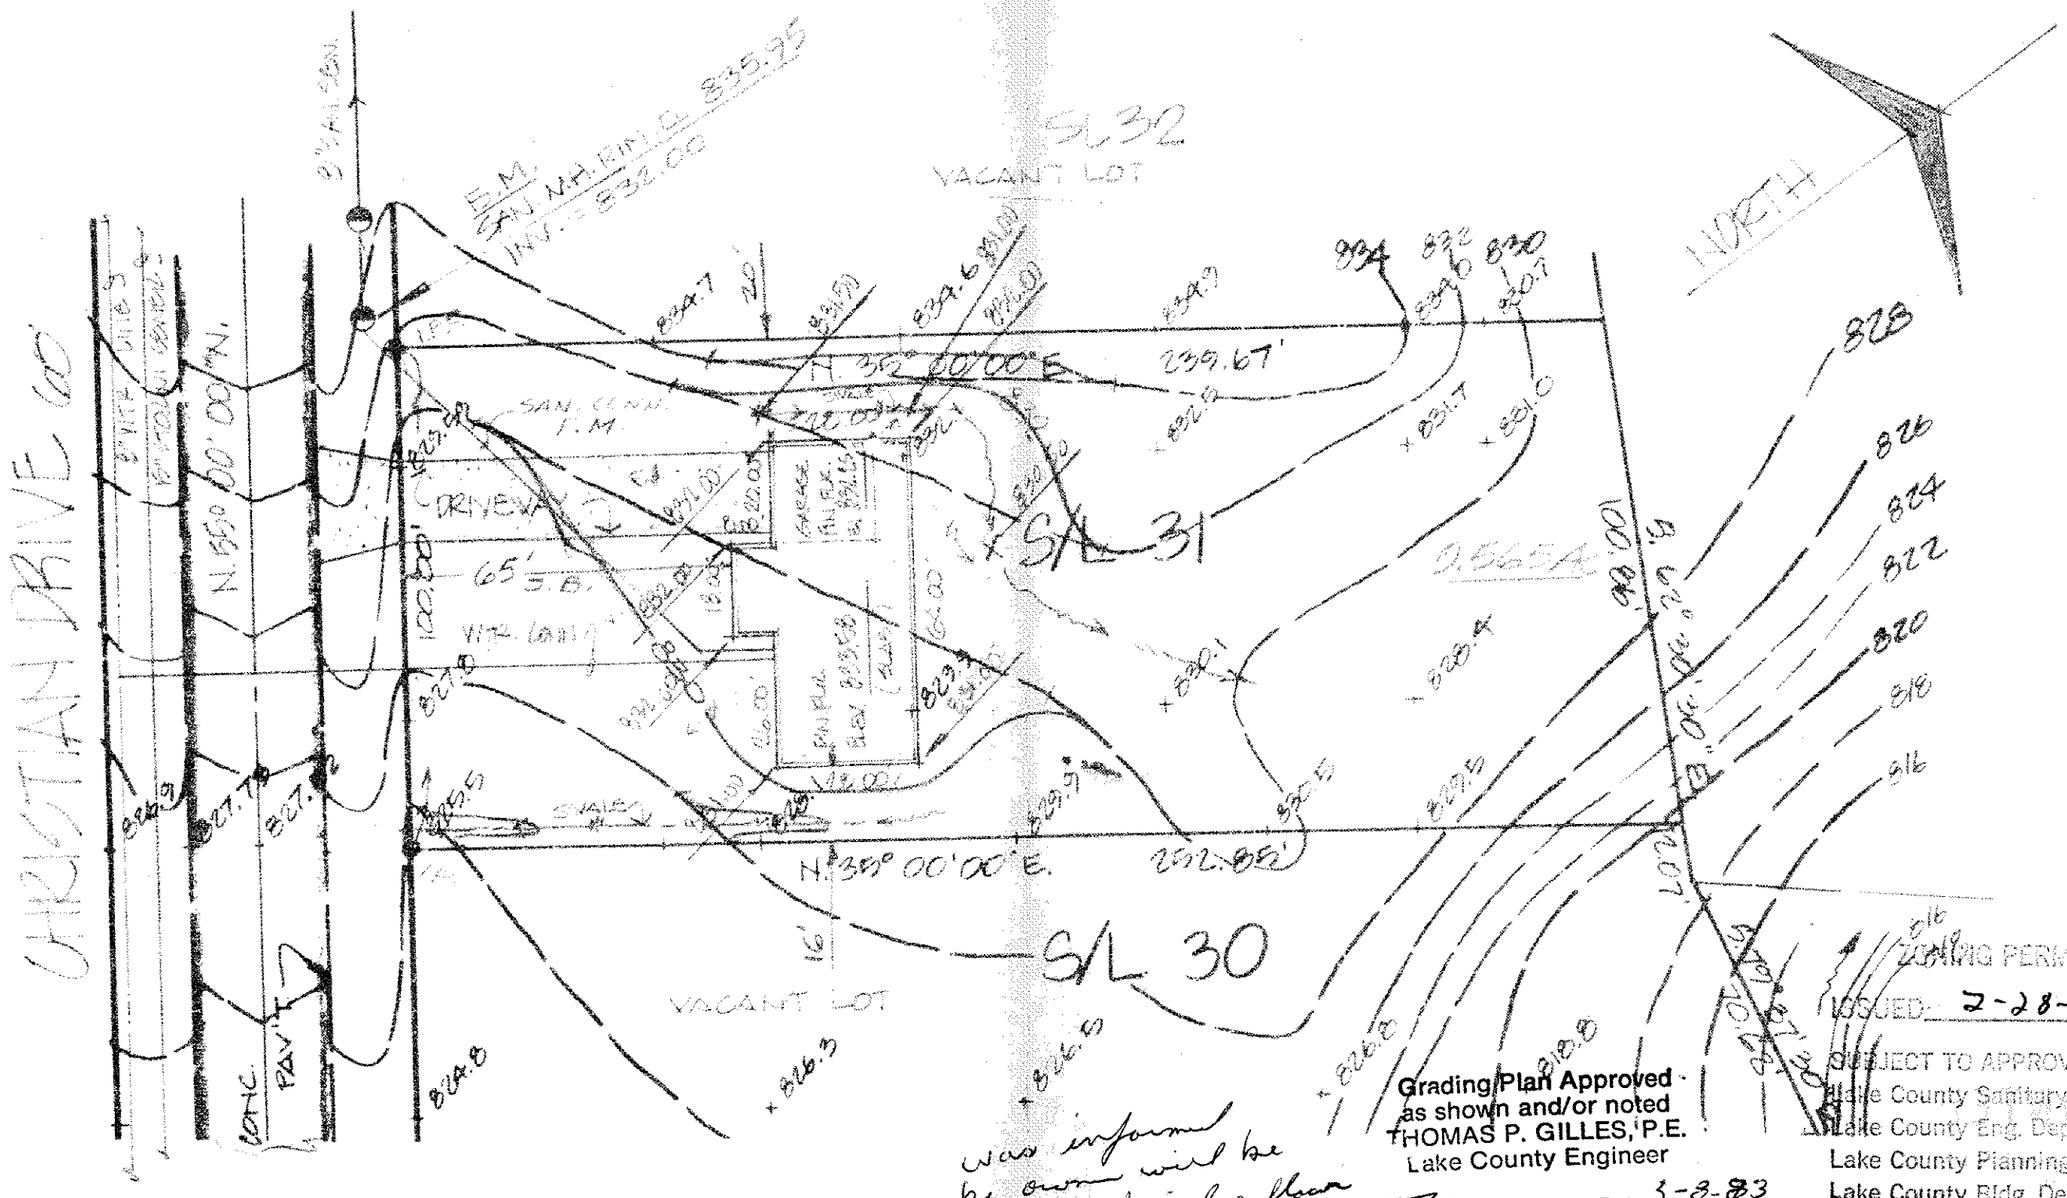

ZONING PERMIT #4584

ISSUED: 2-28-83

SUBJECT TO APPROVAL BY:

- Lake County Sanitary Eng. ☐
- Lake County Eng. Dept. ☒
- Lake County Planning Comm. ☐
- Lake County Bldg. Dept. ☒

Grading Plan Approved as shown and/or noted
THOMAS P. GILLES, P.E.
Lake County Engineer

By TLO Date 3-8-83

Terry S Marano

was informed by owner will be raising finished floor 18" ±

1187

NOTE: UNDERLINED ELEVATIONS INDICATES PROPOSED GRADES.

DESIGN CERTIFICATION	AS BUILT CERTIFICATION			
THIS PLAT WAS PREPARED BY ME, AND IS CORRECT TO THE BEST OF MY KNOWLEDGE AND BELIEF. Chris Defelice	I HEREBY CERTIFY THAT THE CIRCLED GRADES ARE EXISTING FINISH GRADES CHECKED IN THE FIELD ON ..... AND THAT SURVEY IS CORRECT TO THE BEST OF MY KNOWLEDGE AND BELIEF	COLPETZER · WOODS CONSULTANTS, INC. 9470 MENTOR AVENUE • MENTOR, OHIO 44060 • (216) 357-7569	DATE [illegible] SCALE [illegible] DRWN BY [illegible] CHKD BY [illegible] JOB NO [illegible] FB [illegible] PG [illegible]	SITE PLAN FOR: [illegible]
REG. SURVEYOR NO 4785	REG. SURVEYOR NO			