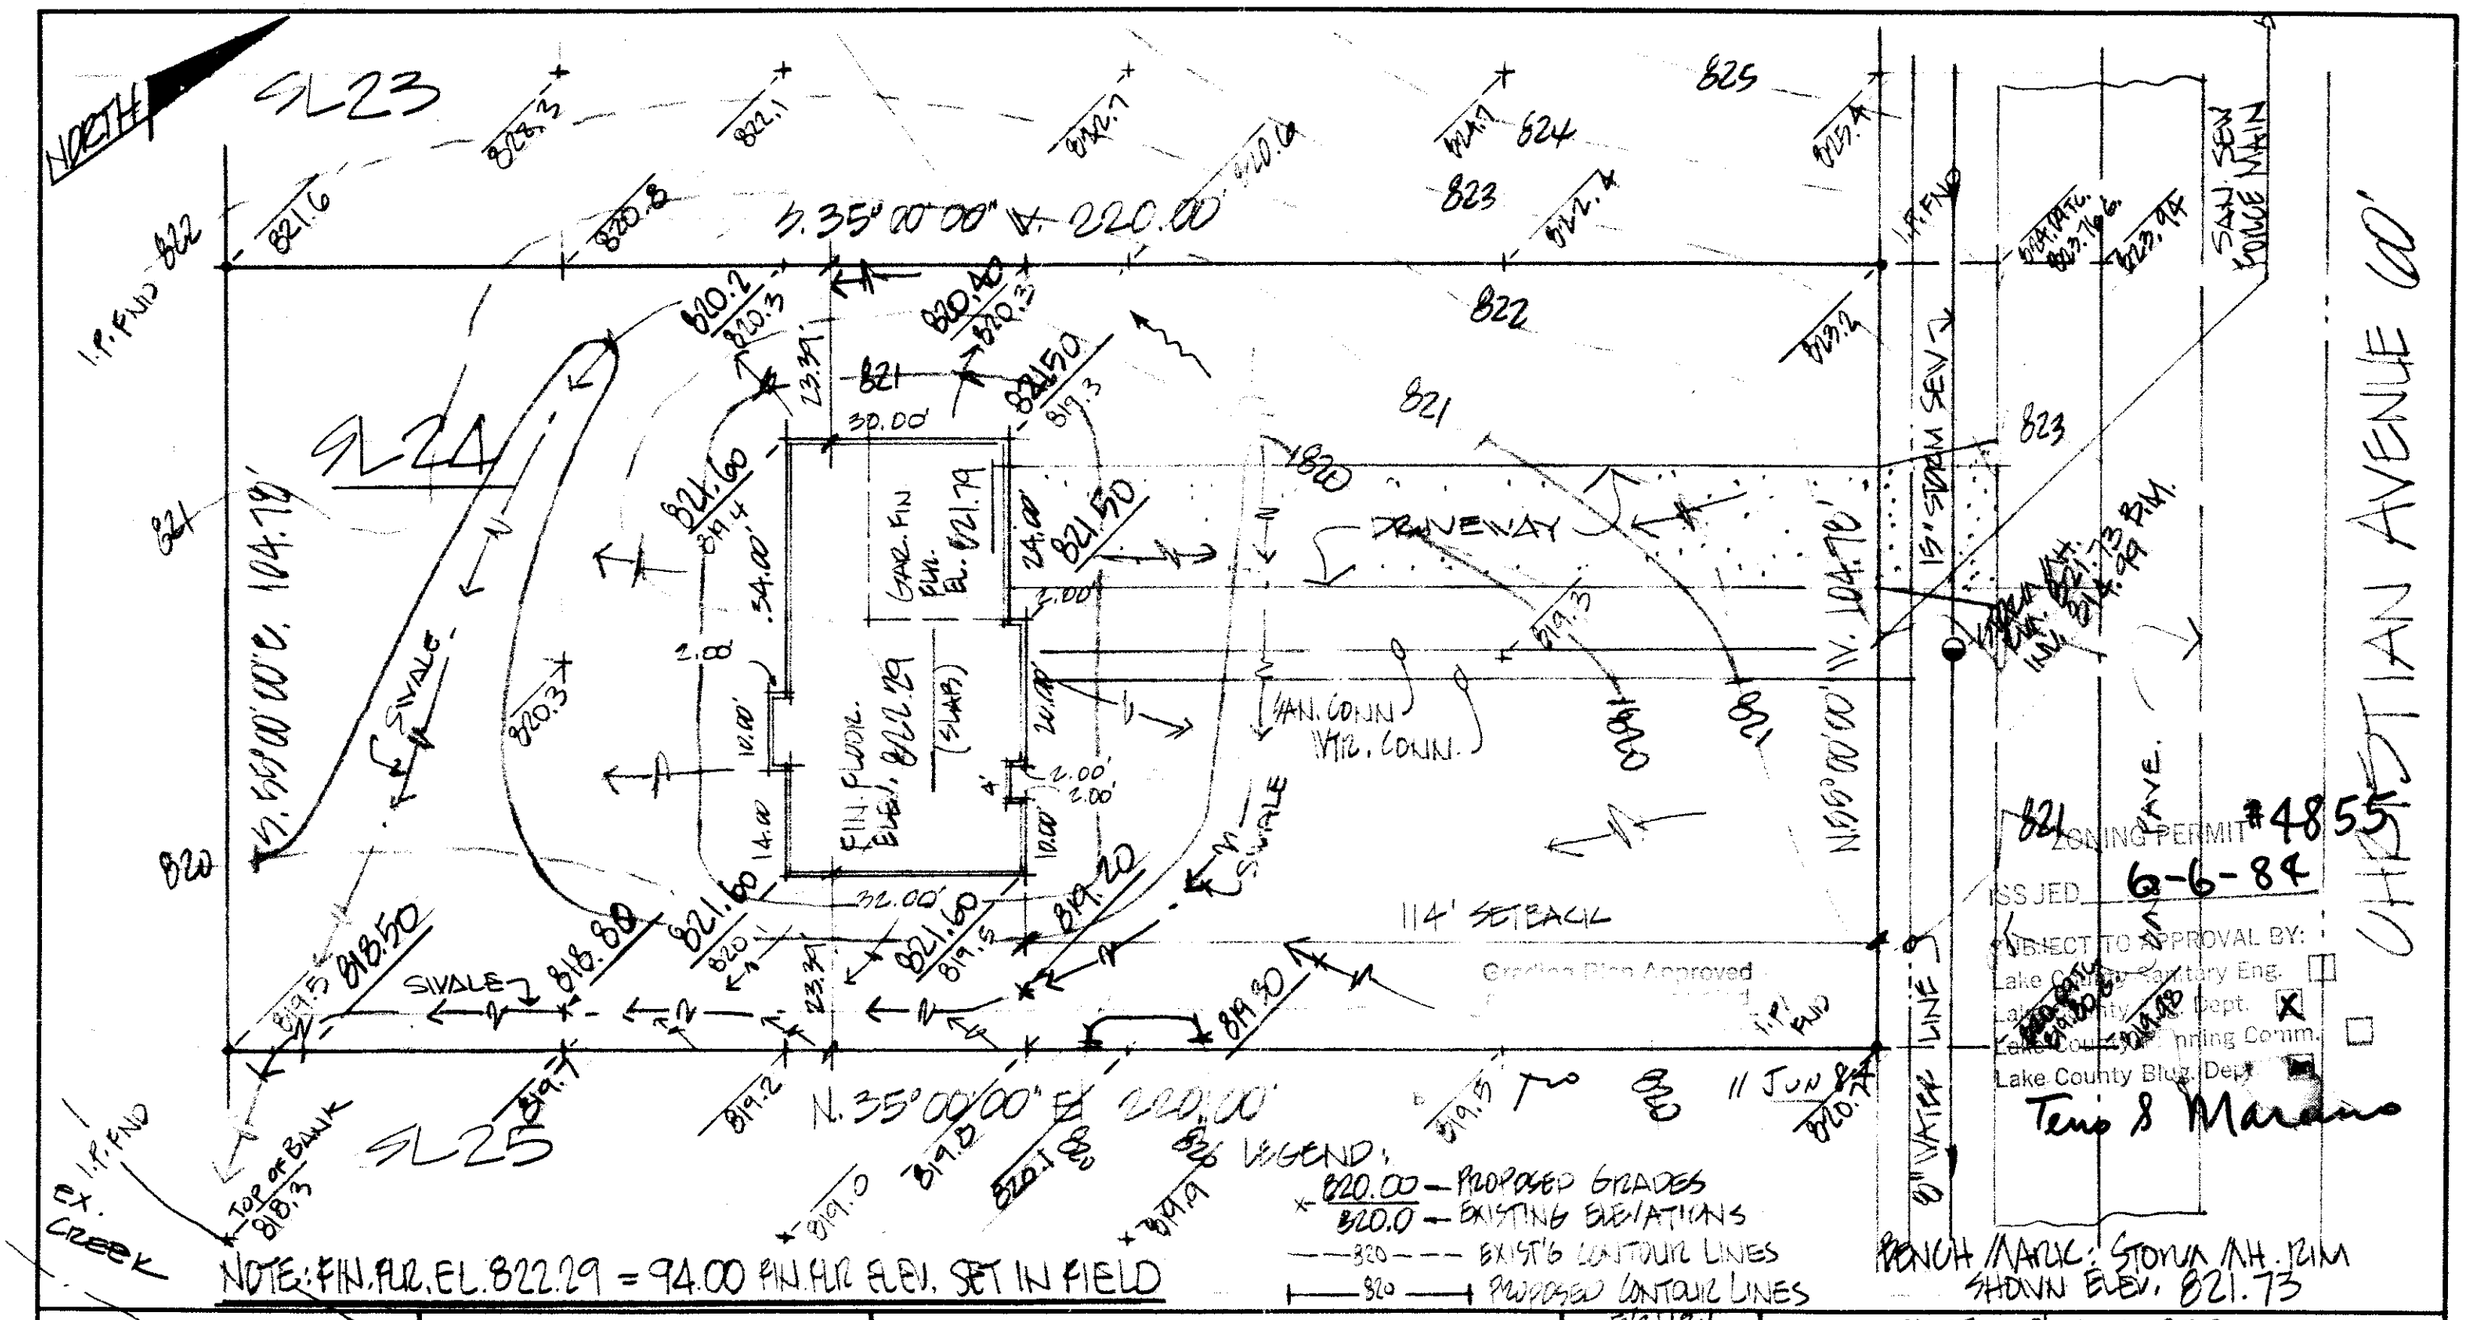

DESIGN CERTIFICATION	AS BUILT CERTIFICATION			
THIS PLAT WAS PREPARED BY ME, AND IS CORRECT TO THE BEST OF MY KNOWLEDGE AND BELIEF.	I HEREBY CERTIFY THAT THE CIRCLED GRADES ARE EXISTING FINISH GRADES CHECKED IN THE FIELD ON _____ AND THAT SURVEY IS CORRECT TO THE BEST OF MY KNOWLEDGE AND BELIEF.	**COLPETZER · WOODS** CONSULTANTS, INC. 9470 MENTOR AVENUE • MENTOR, OHIO 44060 • (216) 357-7569	DATE 5/31/84 SCALE 1"=20' DRWN BY CDB CHKD BY JOB NO. 84-126 FB 479 PG 13	SITE PLAN FOR: WYNN SPALLER BEING SUBLOT NO. 24 IN THE FAR HILLS ESTATES SUBDIVISION NO. 2 IN CONCORD TOWNSHIP, OHIO.
REG. SURVEYOR NO. 4785	REG. SURVEYOR NO. _____			