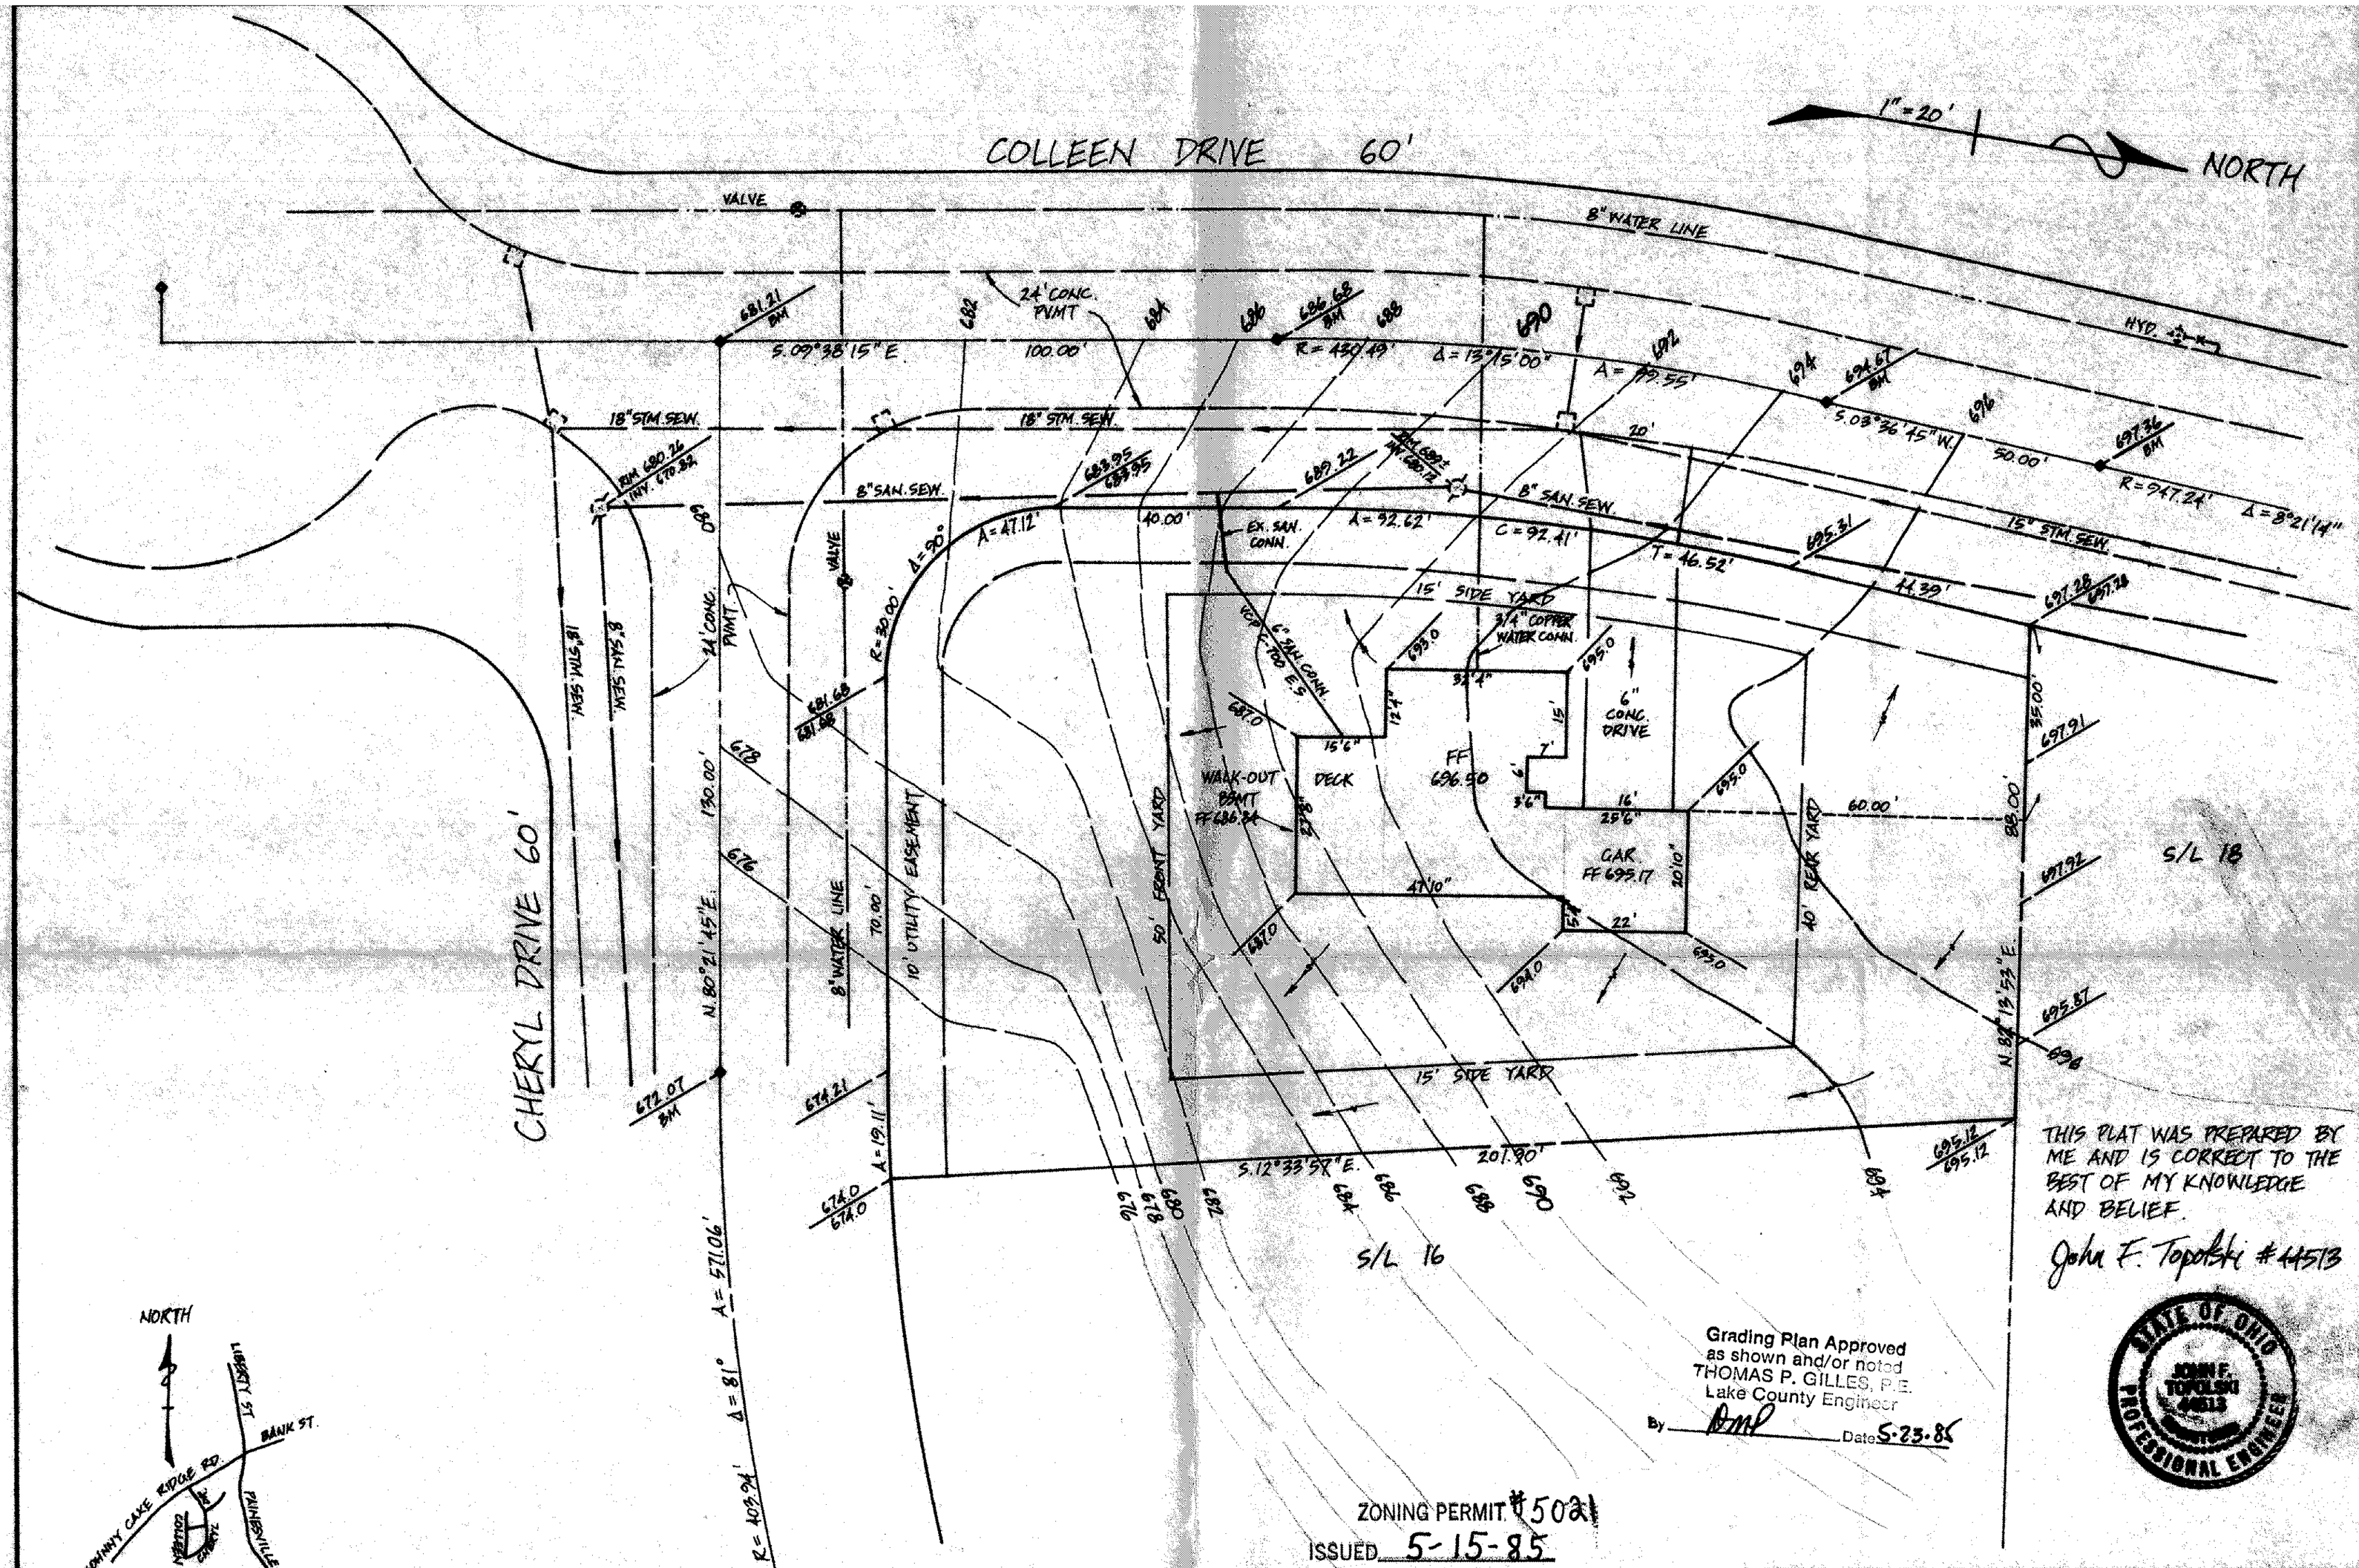

THIS PLAT WAS PREPARED BY ME AND IS CORRECT TO THE BEST OF MY KNOWLEDGE AND BELIEF.

John F. Topolski #44513

STATE OF OHIO
JOHN F. TOPOLSKI
44513
REGISTERED
PROFESSIONAL ENGINEER

Grading Plan Approved as shown and/or noted
THOMAS P. GILLES, P.E.
Lake County Engineer
By [signature] Date 5-23-85

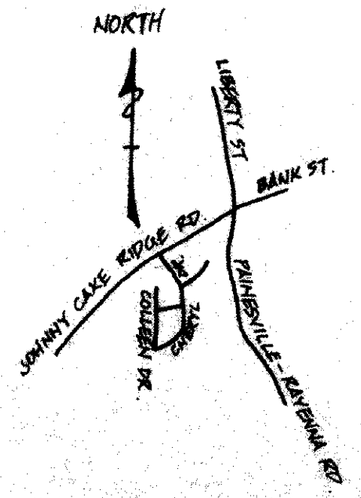

VICINITY MAP
NTS

ZONING PERMIT #5021
ISSUED 5-15-85

SUBJECT TO APPROVAL BY:
Lake County Sanitary Eng. ☐
Lake County Eng. Dept. ☒
Lake County Planning Comm. ☐
Lake County Bldg. Dept. ☒

Teno S Marano

SITE PLAN for RICHARD KOVACH S/L #17 ~ CONCORD KELLOGG PARK ESTATES		354-2400 XT 2083
SCALE: 1" = 20'	APPROVED BY	DRAWN BY JFT
DATE: 4-26-85		354-4700
CONCORD TWP. R-1 ZONE		3 BEDROOM 2 STORY WALK-OUT BSMT.
21ST CENTURY ENGINEERING, INC. 180 S. STATE ST. #150 PVL, OH 44077		DRAWING NUMBER 85-5

TELEDYNE POST 18AB-14E