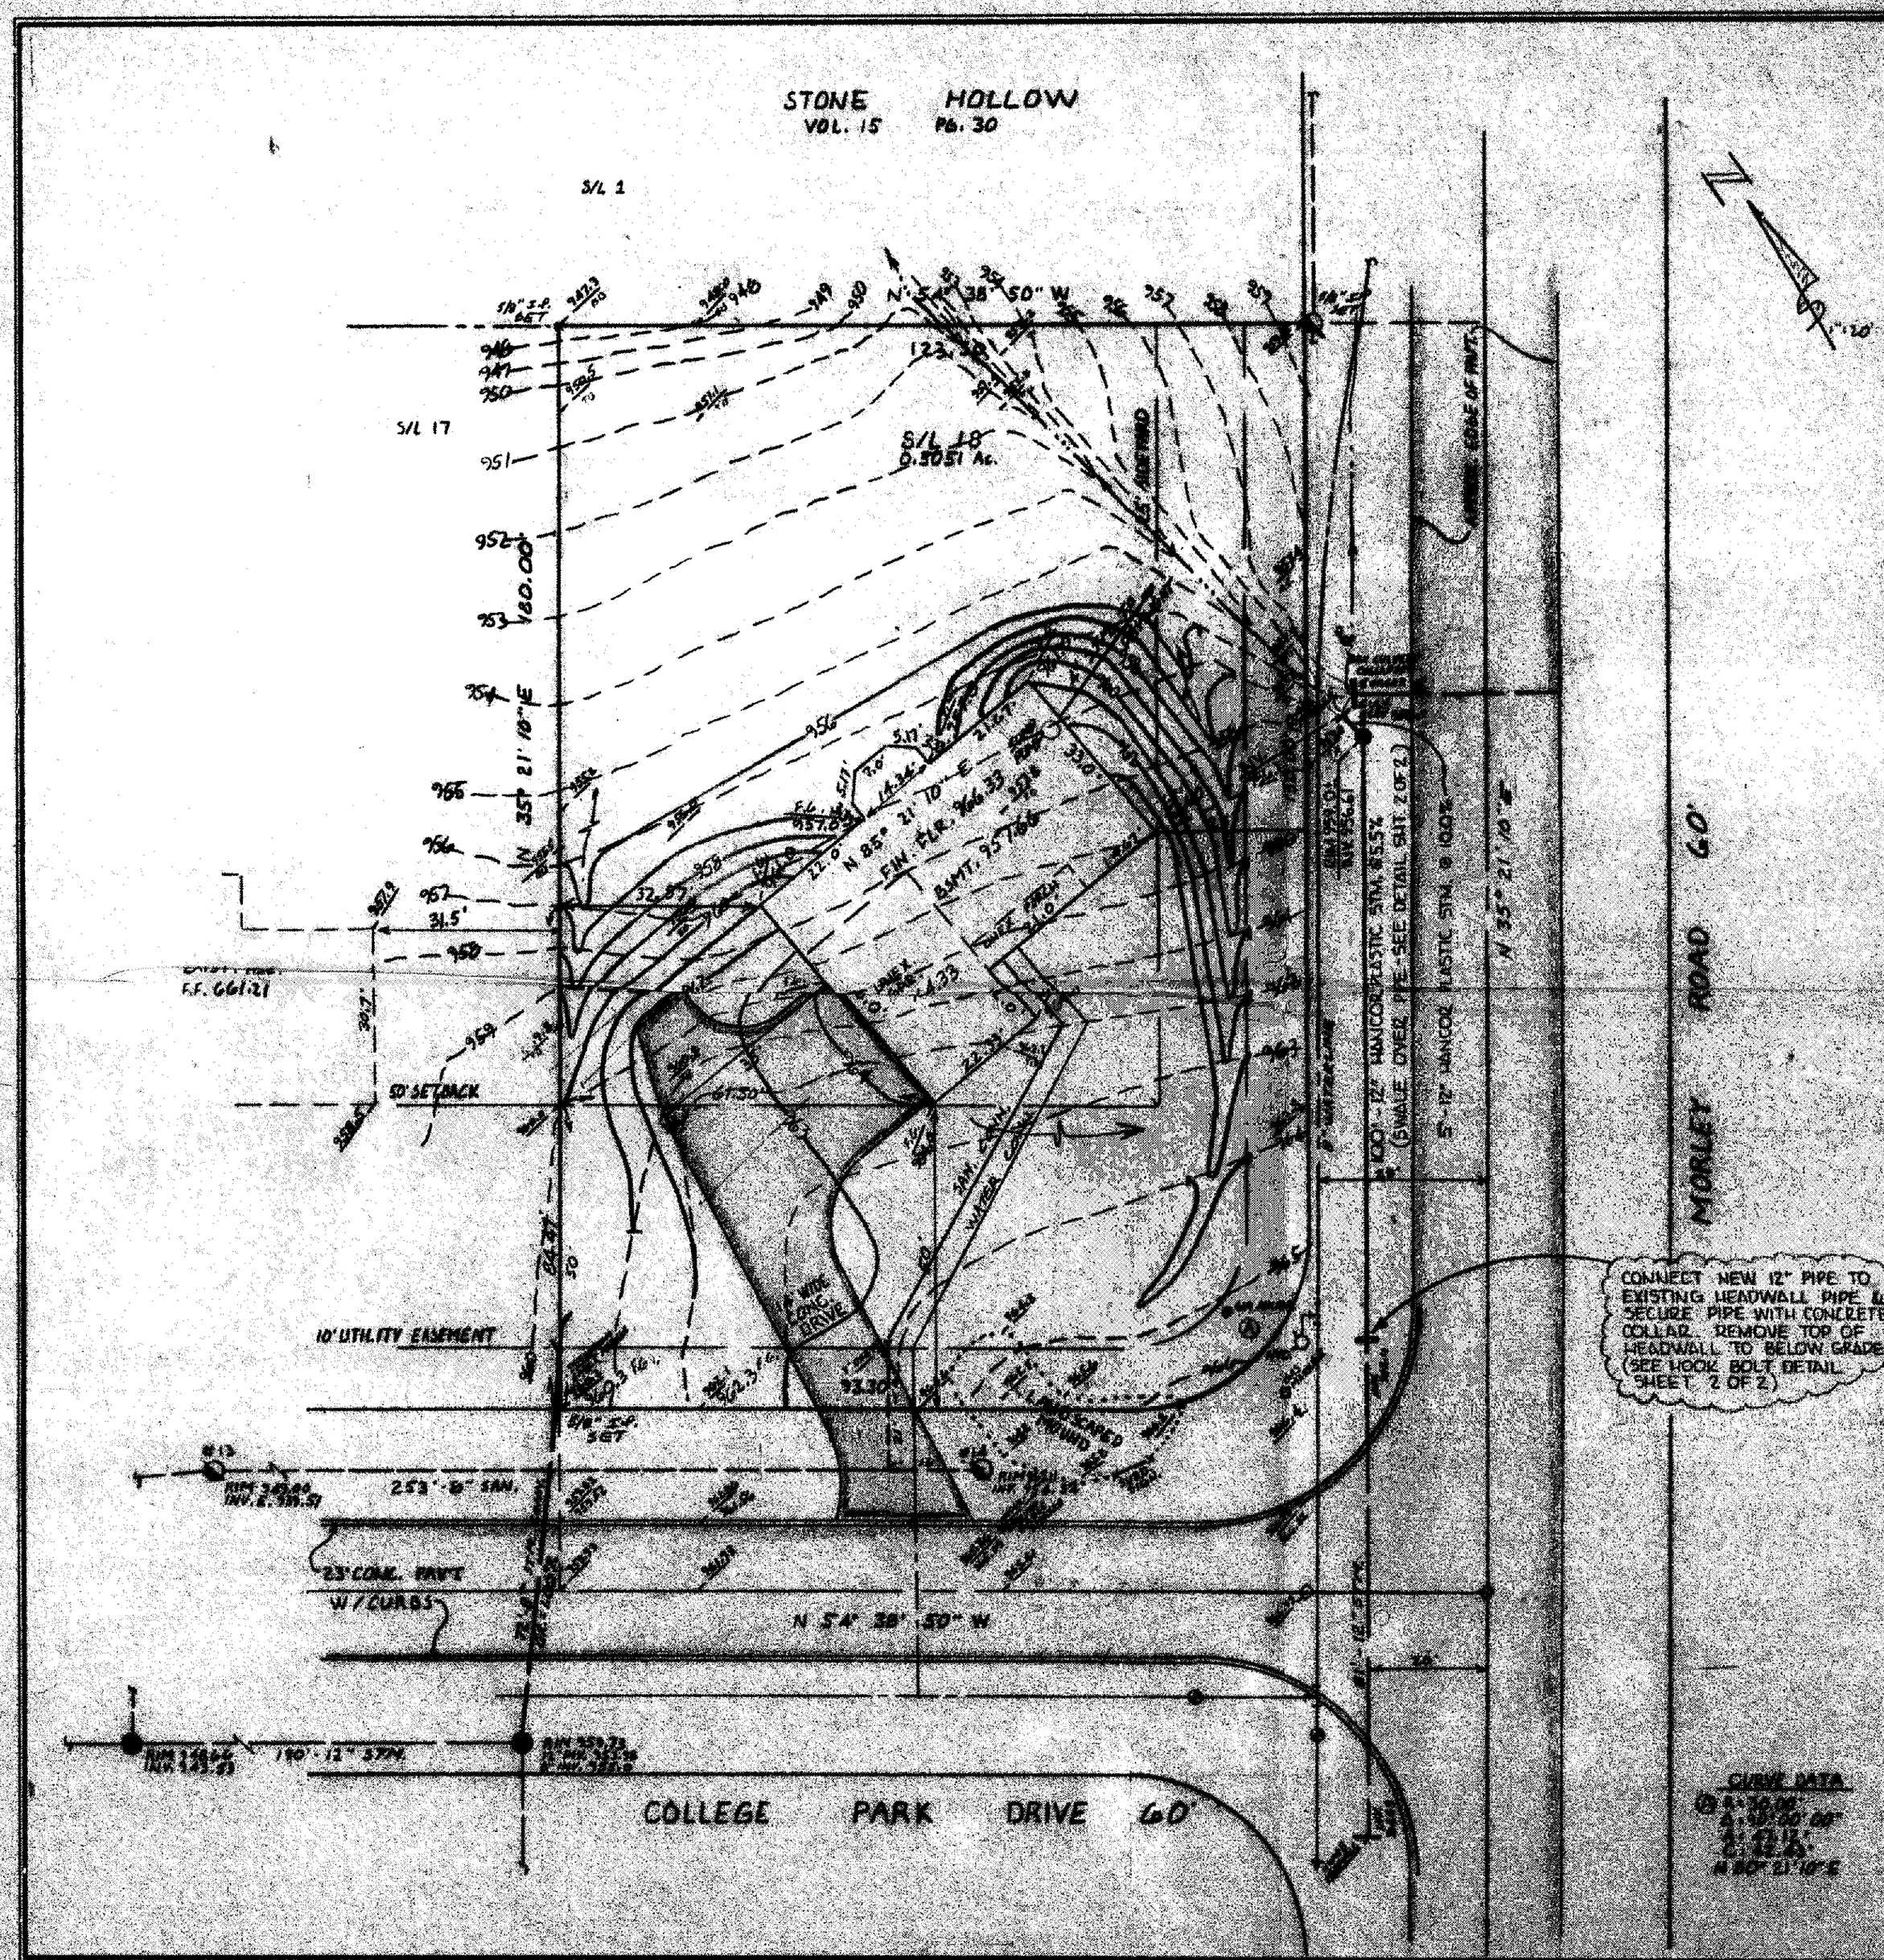

SITE PLAN

for : CARLA POLEWCHAK
CLIENT

9968 HOOSE RD MENTOR
ADDRESS STREET CITY

18 CARRIAGE HILLS SUB. #2
SUBLOT No. SUBDIVISION NAME VOL. PAGE

CONCORD TWP.
LOT, TRACT OHIO

LAND DESIGN consultants
Civil Engineers and Surveyors
8588 EAST AVENUE • MENTOR, OHIO 44060
TELEPHONE 255-6463 354-9838 951-LAND

DESIGN CERTIFICATION

THIS PLAT WAS PREPARED BY ME, AND IS CORRECT TO THE BEST OF MY KNOWLEDGE AND BELIEF.

4.15.93
NAME

CHECK LIST

LOT DIMENSIONS & BEARINGS
TIE TO NEAREST STREET
SUBLOT No. (PARCEL No.)
SURROUNDING OWNERS
BUILDING DIMENSIONS
SETBACK, SIDEYARD, REARYARD
FINISHED GRADES
DRIVE & APRON TYPE, WIDTH, THICKNESS
SIDEWALK TYPE, WIDTH, THICKNESS
CULVERT TYPE, DIAM., LENGTH
WATER MAIN SIZE, LOCATION
SAN. SEWER SIZE, % GRADE, LOC.
SAN. MH. CAST. ELEV., INV. ELEV.
SAN. CONN. SIZE, % GRADE, LOC.
STORM SEWER SIZE, % GRADE, LOC.
STORM MH. CAST. ELEV., INV. ELEV.
PAVE TYPE, GRADE, CURBS
GAS LINE LOC. SIZE
SEPTIC SYSTEM & DUPLICATION
WELL LOCATION & ISOLATION RADIUS

STATE OF OHIO
RUDY E. SCHWARTZ
7193
REGISTERED PROFESSIONAL SURVEYOR
STATE SEAL

"AS BUILT" CERTIFICATION

I HEREBY CERTIFY THAT THE CIRCLED INFORMATION IS EXISTING AS OBTAINED ON THE SITE _____ 19____ AND IS CORRECT TO THE BEST OF MY KNOWLEDGE AND BELIEF.

NAME

LEGEND

STORM MANHOLE
SANITARY MANHOLE
EXISTING CONTOURS
PROPOSED CONTOURS
EXIST. ELEV. 100.0 / 100.0 PROP. ELEV.
DIRECTION OF SURFACE DRAINAGE

DRAWN BY	SCALE
SAS	1" = 20'
CHK'D BY	DATE
	FEB. 1993

1	ADD 12" STM. INLET STRUCTURE & HEADWALL 11-4-93
2	REVISE 12" STM. ADD INLET & HEADWALL 11-8-93

ACCEPTED : _____ CLIENT _____ DATE

BENCHMARK: RIM OF SAN. MH. No. 14, ELEV. 965.11

SHEET 1 OF 2
DRAWING No. 93-018