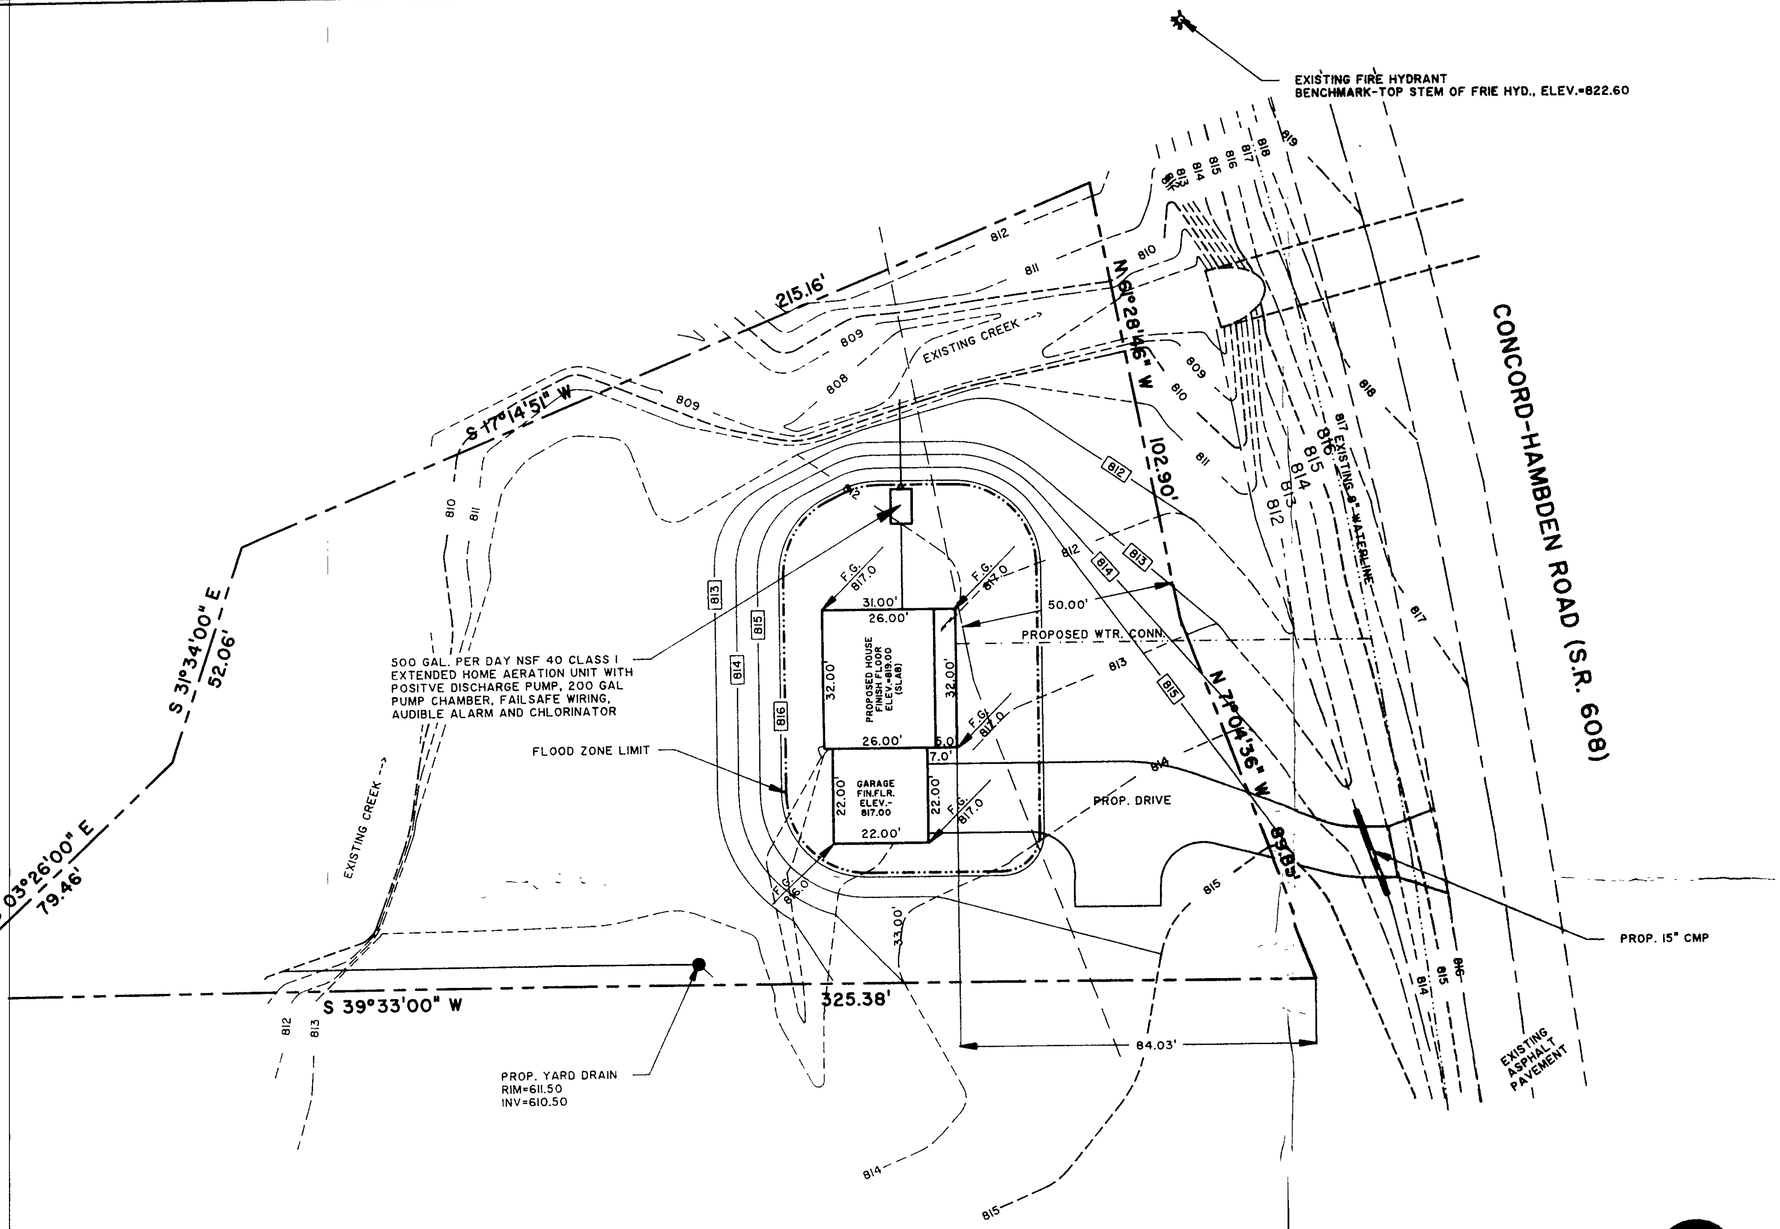

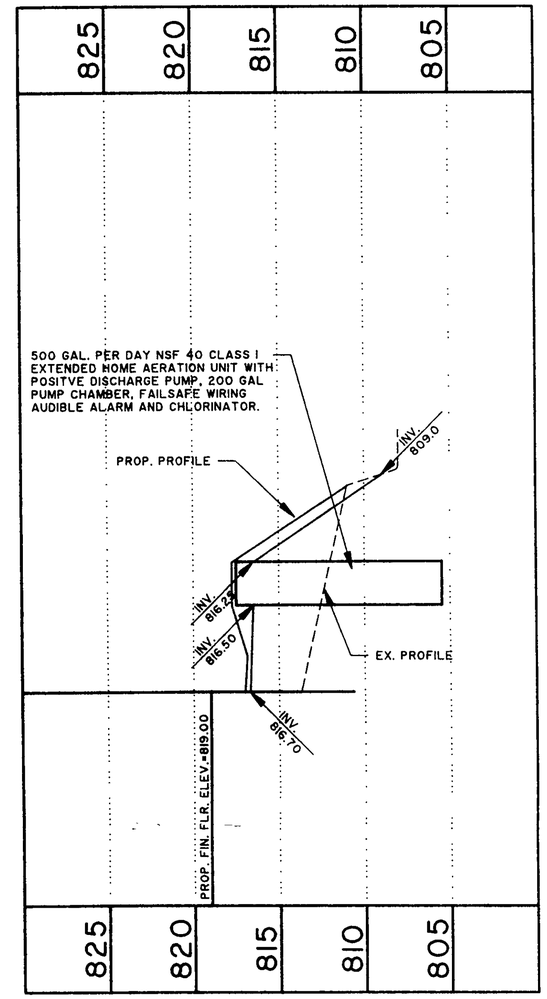

SEWAGE DISP
OBTAINED BY
INSTALLER BE
STARTED.

LOW YIEL
FIXTURES
ON A
Shower Head
Toilet

A. To be brought
1. Septic tank
2. Splitter box
3. Distribution
B. No footer drai
to be discharg
C. All waste wate
septic tanks

Reviewed an
LAKE COUNTY GENER
Date 11-22-
1950's
JOEL LUCIA, R
Health Com
BY J. Li

GENERAL NOTES:

1. DRIVEWAY APRON TO BE 6" THICK
2. BENCHMARK - TOP STEM OF FIRE HYDRANT LOCATED IN FRONT OF SUBLOT No. 8, ELEV.=822.60

LEGEND

EXISTING CONTOUR
PROPOSED CONTOUR

100.00 / 100.00 — EXISTING ELEVATION / PROPOSED ELEVATION

CERTIFICATION

"I THE UNDERSIGNED HEREBY CERTIFY THAT THIS TOPO INDICATED BY 1' CONTOURS AND ELEVATIONS SHOWN REPRESENTS AN ACTUAL SURVEY MADE BY ME ON THE DAY OF DEC> , 1994 AND THE ELEVATIONS WERE TA APPROPRIATE INTERVALS AND AS OF THAT DAY THEY AS INDICATED HEREON.

"I HEREBY CERTIFY THAT THIS PLAN WAS PREPARED BY AND IS CORRECT TO THE BEST OF MY KNOWLEDGE"

DAVID W. NOVAK, P.S. No. 750

Grading Plan Approved
as shown and/or noted
THOMAS P. GILLES, P.E.
Lake County Engineer

By GJH Date 4.30.98
- Flood zone elevation per Cali woods drainage Study
- Flood plain Panel # 390771-0051C

ZONING PERMIT #0498-9027
ISSUED 4/23/98
SUBJECT TO APPROVAL BY:
Lake County Sanitary Eng. ☐
Lake County Eng. Dept. ☒
Lake County Planning Comm. ☐
Lake County Bldg. Dept. ☒

GRAPHIC SCALE

20 0 10 20 40 80

(IN FEET)
1 inch = 20 ft.

DESCRIPTION	DATE	BY	CH'K'D.
SEPTIC SYSTEM	11/13/96	DWN	
SEPTIC SYSTEM	11/21/96	DWN	

STATE OF OHIO — DAVID W. NOVAK S-7507 — REGISTERED SURVEYOR

Himebaugh and Novak
Surveyors and Site Consultants
8663 Tyler Boulevard
Mentor, Ohio 44060-4346
(216) 974-7670, (216) 255-5900 FAX.

440
946-1761

LITTLE MOUNTAIN HOMES, INC.
1447 NORTH RIDGE ROAD, PAINESVILLE, OH 44077

DATE: JUNE 21, 1995
DRAWN BY: D. W. NOVAK
CHECKED BY: DWN
APPROVED BY:
F.B. No. -- PG. --

SITE PLAN

SUBLOT No. 9 FAR HILLS ESTATES, VOL. K, PG. 58