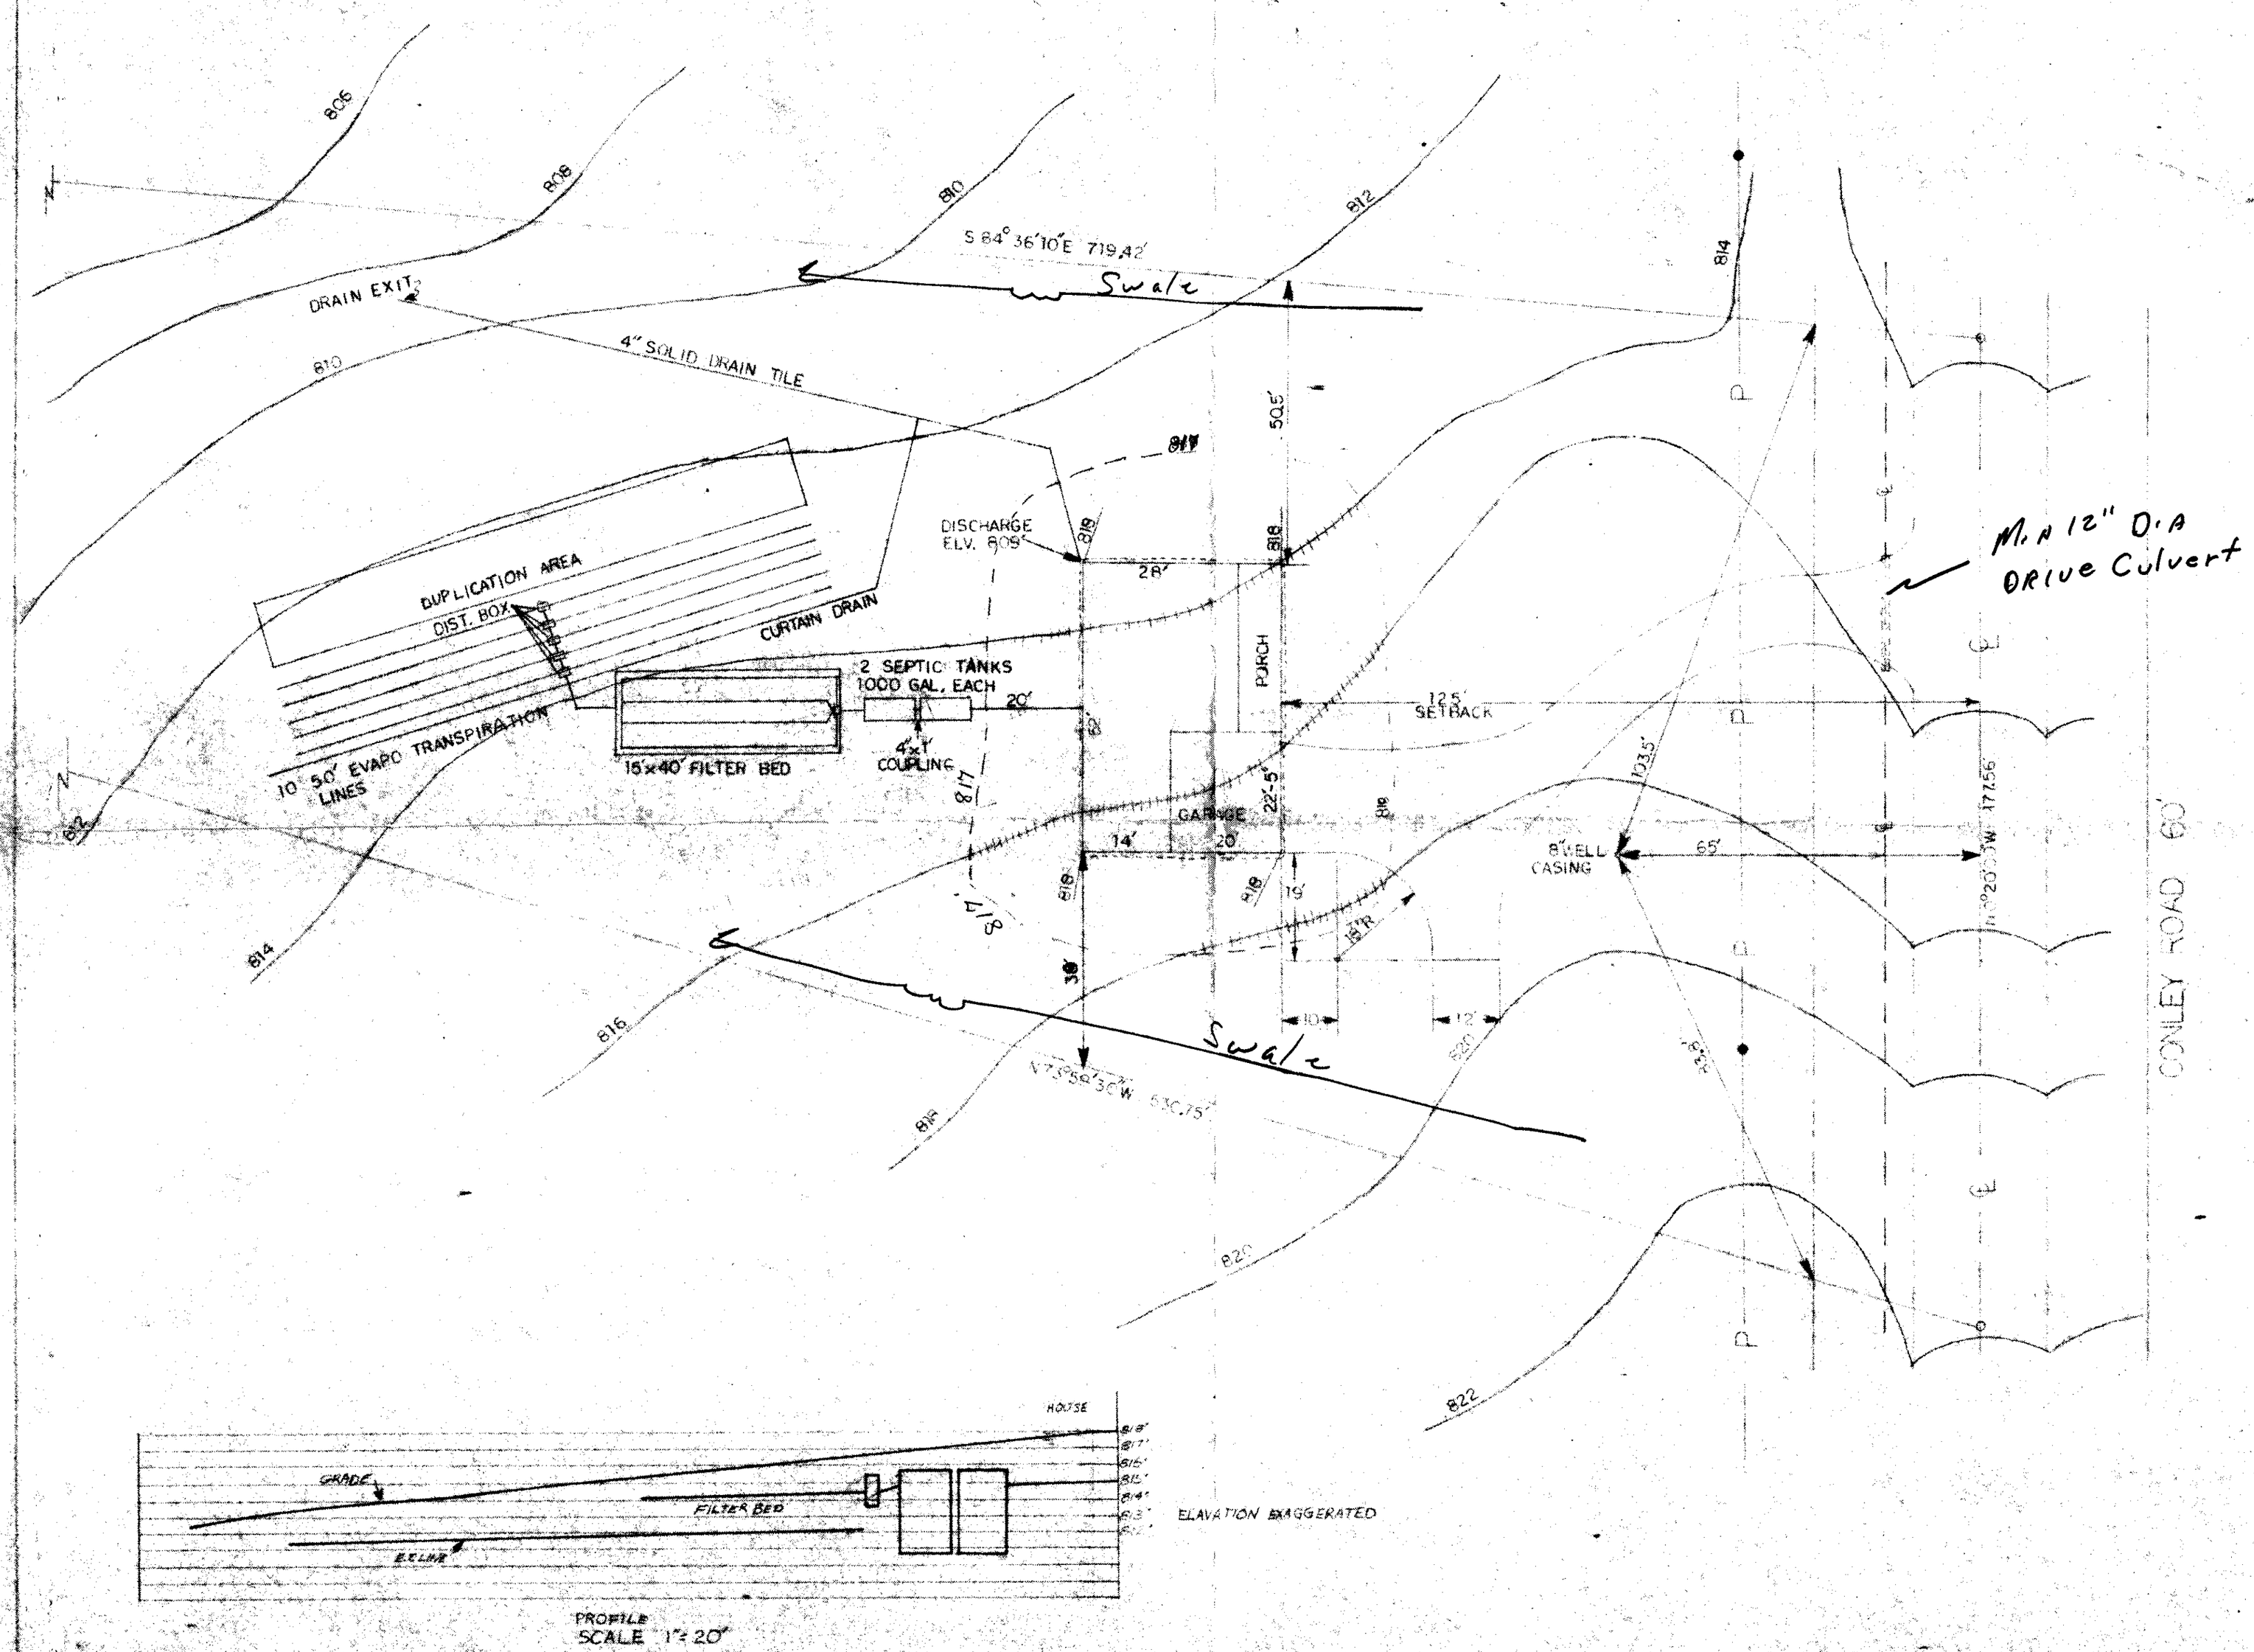

806
808
810
812
814
816
818
820
822
S 84° 36' 10" E 719.42'
Swale
DRAIN EXIT
4" SOLID DRAIN TILE
DISCHARGE ELV. 809'
28'
50.5'
DUPLICATION AREA
DIST. BOX
CURTAIN DRAIN
2 SEPTIC TANKS 1000 GAL. EACH
20'
PORCH
12.5' SETBACK
10 50' EVAPO TRANSPIRATION LINES
15'x40' FILTER BED
4"x1' COUPLING
GARAGE
22'-5"
14'
20'
19'
8" WELL CASING
65'
103.5'
177.56'
N 73°58'30" W 530.75'
Swale
Min 12" Dia Drive Culvert
CONLEY ROAD 60'
HOUSE
GRADE
FILTER BED
ELEVATION EXAGGERATED
PROFILE
SCALE 1" = 20'