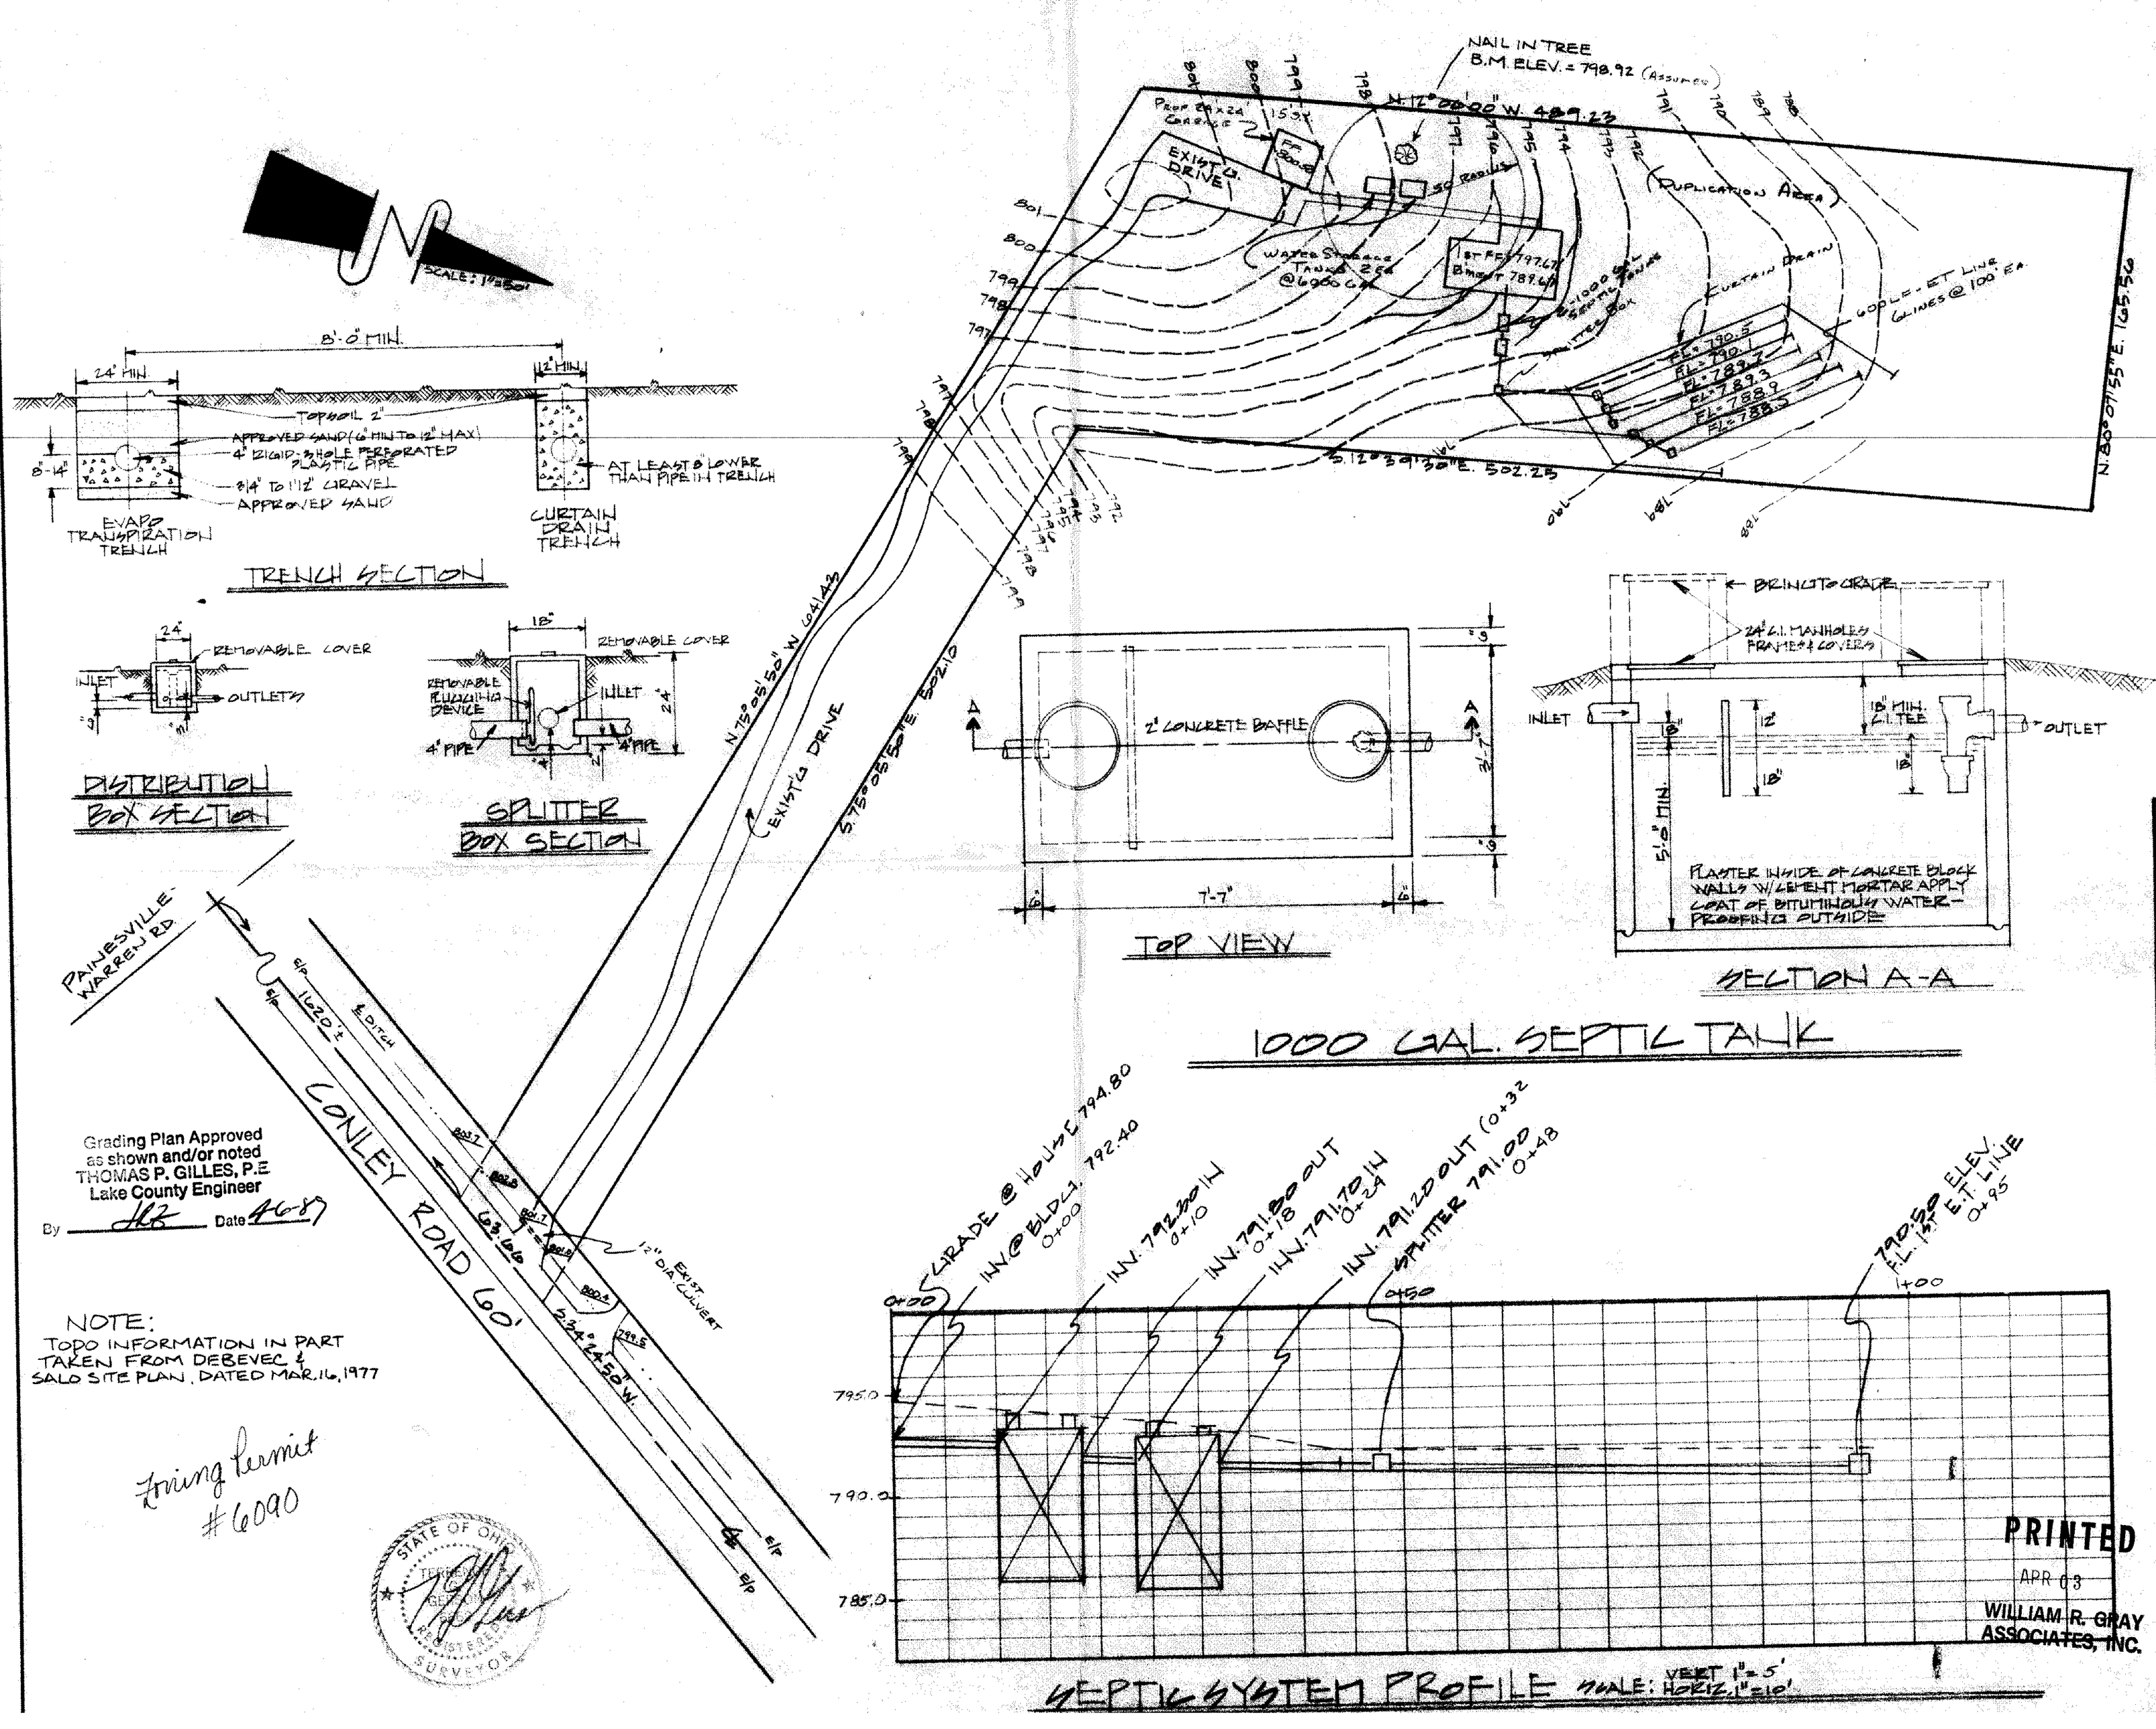

Grading Plan Approved as shown and/or noted
THOMAS P. GILLES, P.E
Lake County Engineer
By [signature] Date 4-6-87

NOTE:
TOPO INFORMATION IN PART TAKEN FROM DEBEVEC & SALO SITE PLAN, DATED MAR. 16, 1977

Zoning Permit #6090

STATE OF OHIO
TERRENCE
GEORGE
REGISTERED
SURVEYOR

PRINTED
APR 03
WILLIAM R. GRAY ASSOCIATES, INC.

WILLIAM R. GRAY ASSOCIATES, INC.
MENTOR, OHIO 44060 946-1616

WRG

TITLE: SITE PLAN & SEPTIC SYSTEM
DATE: 2-21-88
DRAWN BY: M. SHERWOOD
REV
Mr & Mrs. Charles Cuthbert
6360 Conley Road
Concord, Ohio, 44077
SHEET NO