REVISIONS	BY

Barrington
CONSULTING GROUP, INC.
9114 TYLER BLVD., MENTOR, OHIO 44060
PHONE 440.205.1260 FAX 440.205.1262
www.BarringtonCGI.com

STATE OF OHIO — DAVID W. NOVAK S-7507 — REGISTERED SURVEYOR

SITE PLAN

9859 COUNTRY SCENE LN., CONCORD TWP., OHIO 44077
UNIT #18 GABRIEL'S EDGE SINGLE DETACHED CLUSTER DEVELOPMENT VOL. 59 PG. 17

PROBUILT HOMES, INC.

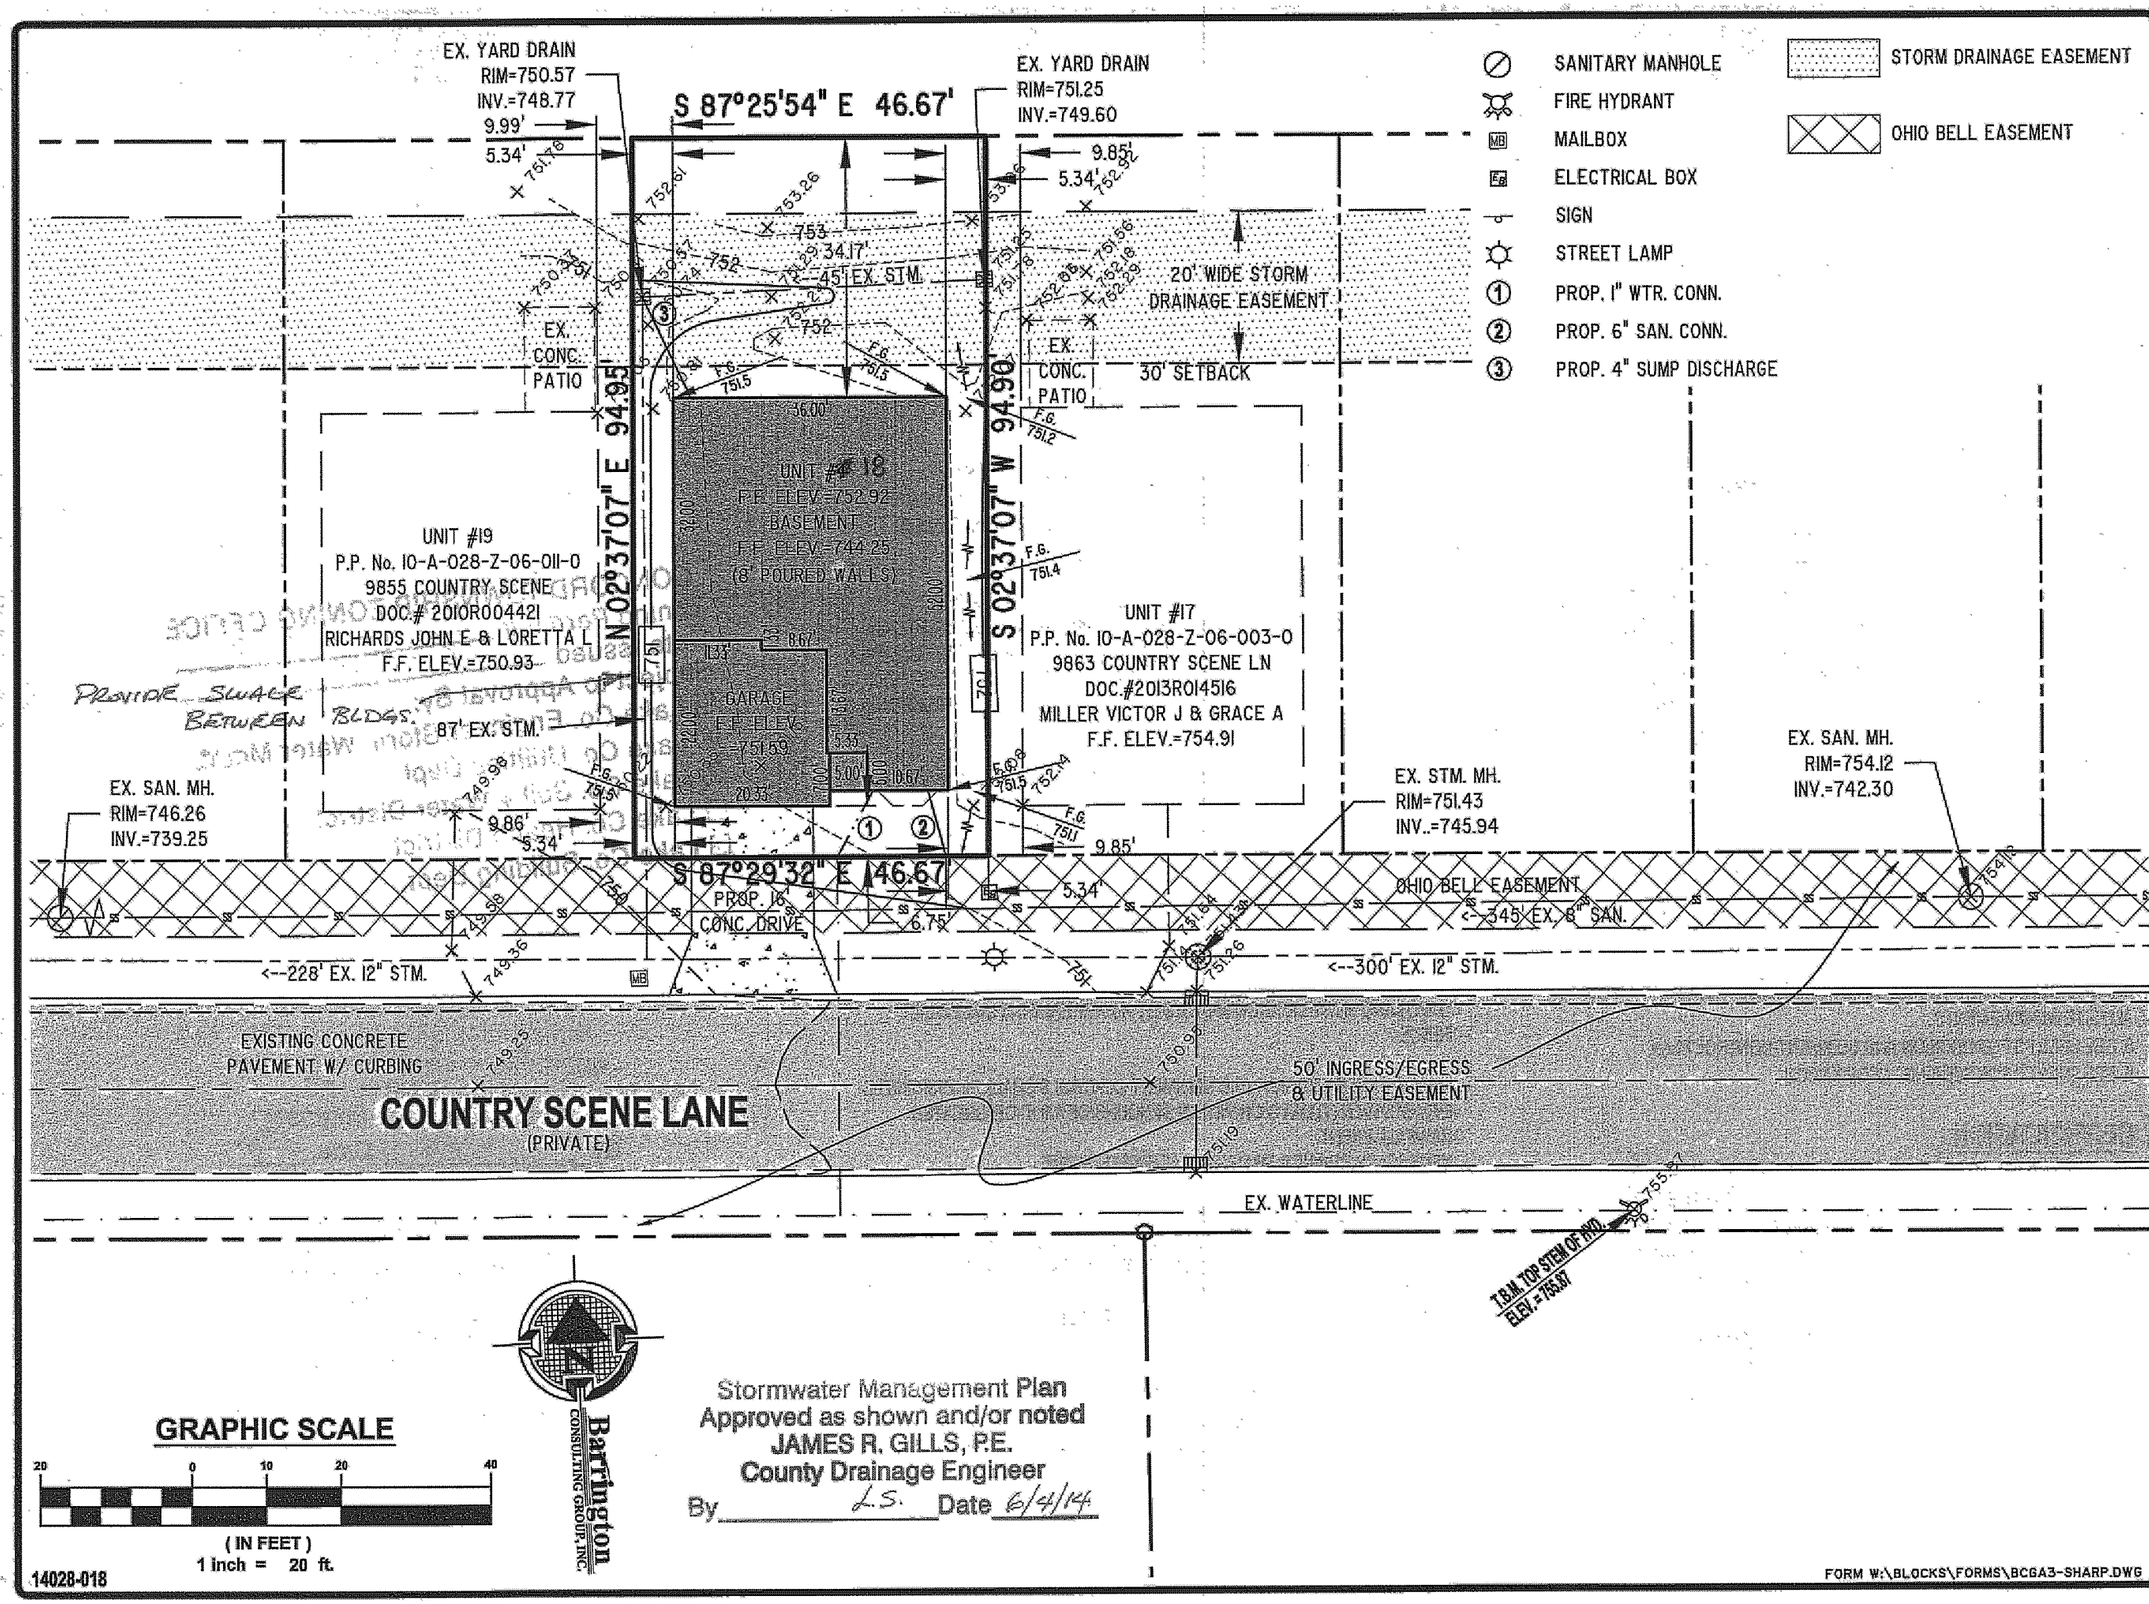

GRAPHIC SCALE

20 0 10 20 40

(IN FEET)
1 inch = 20 ft.

Stormwater Management Plan
Approved as shown and/or noted
JAMES R. GILLS, P.E.
County Drainage Engineer
By L.S. Date 6/4/14

DRAWN	WSO
CHECKED	DWN
DATE	MAY 28, 2014
SCALE	1" = 20'
JOB NO.	14028-018
SHEET	2/3
OF	SHEETS

14028-018

FORM W:\BLOCKS\FORMS\BCGA3-SHARP.DWG

Civil Engineers - Surveyors - Land Planners
Barrington
CONSULTING GROUP, INC.
9114 TYLER BLVD., MENTOR, OHIO 44060
PHONE 440.205.1260 FAX 440.205.1262
www.BarringtonCGI.com