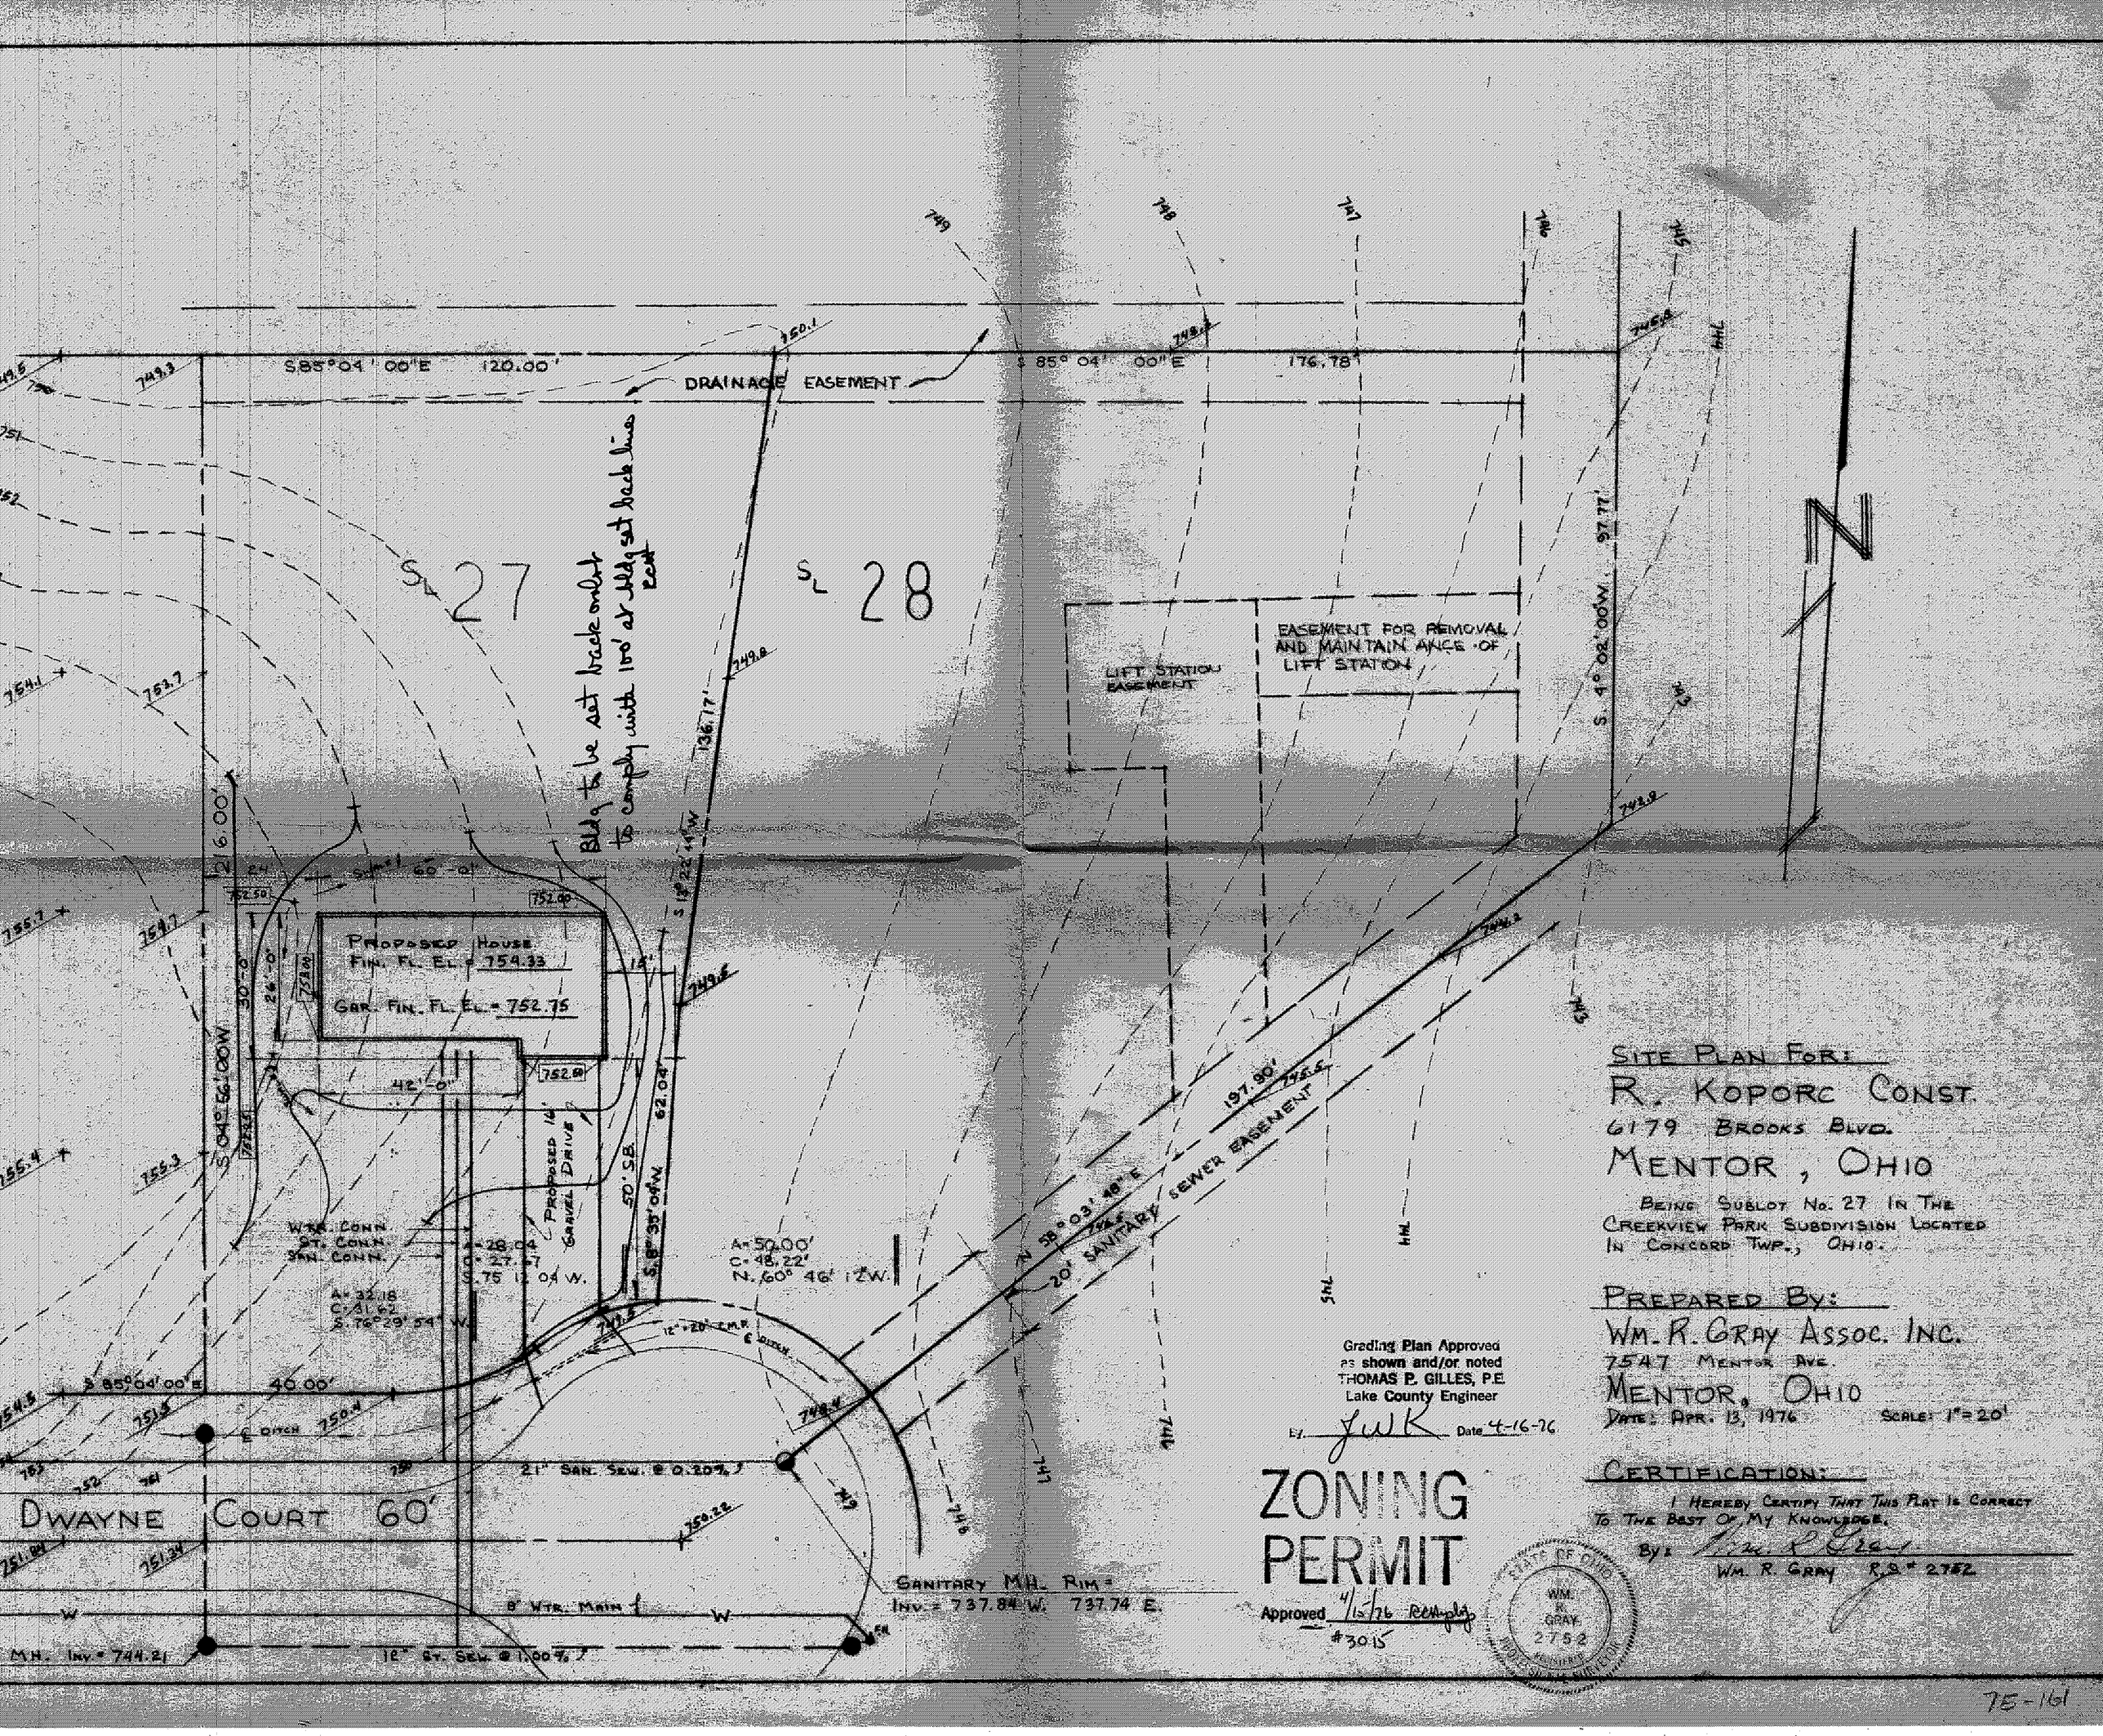

SITE PLAN FOR:

R. KOPORC CONST.
6179 BROOKS BLVD.
MENTOR, OHIO

BEING SUBLOT NO. 27 IN THE CREEKVIEW PARK SUBDIVISION LOCATED IN CONCORD TWP., OHIO.

PREPARED BY:

WM. R. GRAY ASSOC. INC.
7547 MENTOR AVE.
MENTOR, OHIO
DATE: APR. 13, 1976 SCALE: 1" = 20'

CERTIFICATION:

I HEREBY CERTIFY THAT THIS PLAT IS CORRECT TO THE BEST OF MY KNOWLEDGE.

BY: Wm. R. Gray
WM. R. GRAY R.S. # 2752

Grading Plan Approved as shown and/or noted
THOMAS P. GILLES, P.E.
Lake County Engineer
By JWK Date 4-16-76

ZONING PERMIT

Approved 4/15/76 RCHuplig
#3015

STATE OF OHIO WM. R. GRAY 2752 REGISTERED PROFESSIONAL ENGINEER

75-161