SITE PLAN

CONCORD TOWNSHIP, LAKE COUNTY, OHIO

for: CANTERBILT
CLIENT OWNER

ADDRESS STREET CITY ZIP

ELLISON CREEK SUB. #2
SUBDIVISION NAME

TRACT STREET

46 VOL.-PG. DEER HAVEN DRIVE LOT
SUBLOT NO. STREET VOL.-PG. PERM. PARCEL NO.

LEGEND

SANITARY MANHOLE
STORM MANHOLE
INLET OR CATCH BASIN
HYDRANT
EXISTING CONTOURS
PROPOSED CONTOURS

EXIST. ELEV. 100.0 / 100.0 PROP. ELEV.

AS BUILT ELEVATION

INDICATES DIRECTION OF SURFACE DRAINAGE

DESIGN CERTIFICATION

THIS PLAT WAS PREPARED BY ME, AND IS CORRECT TO THE BEST OF MY KNOWLEDGE AND BELIEF.

NAME SURVEYOR REGISTRATION NO. #6343

REVISIONS		
NO.	DATE	BY
1		
2		
3		
4		
5		

PLAN PREPARED BY:
BABCOCK · JONES & ASSOCIATES, INC.
PAINESVILLE, OHIO

DRAWN BY B.P.	SCALE 1"=30'	PHONE NO. 440-357-1811	
CHK'D. H.J.	DATE 6/26/02	DRAWING NO. 00-265-46	
CREW CHIEF W.B.	APP'D H.J.		

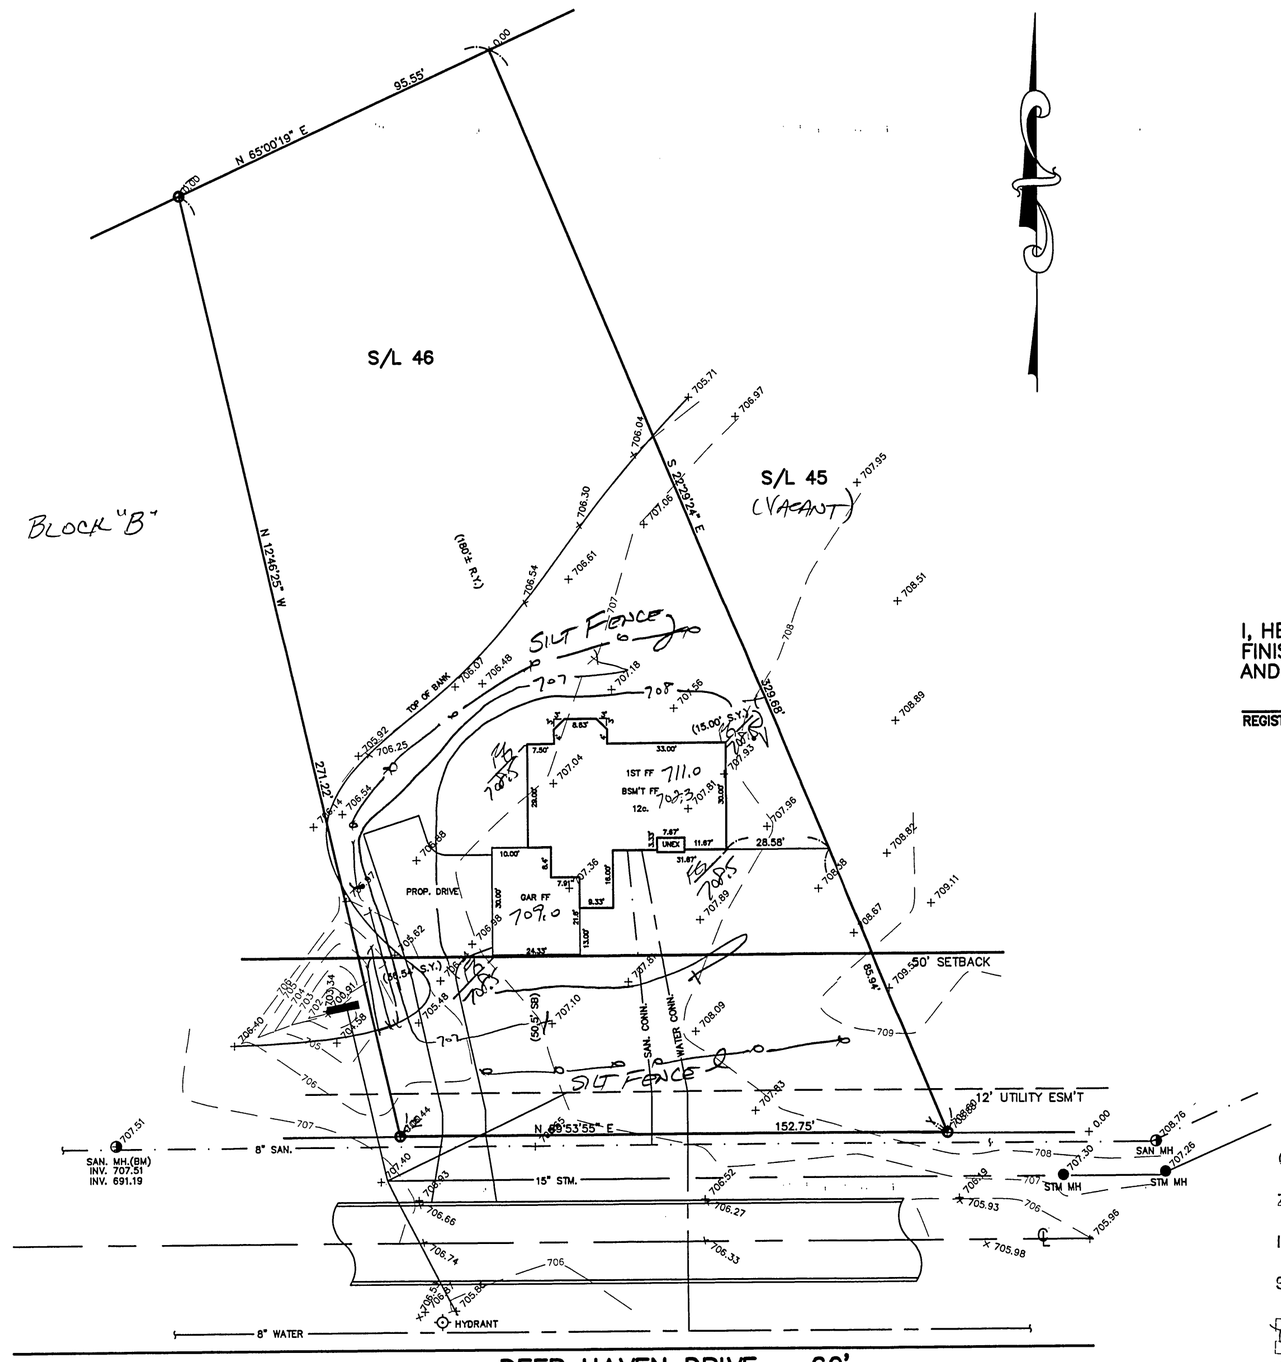

"AS BUILT" CERTIFICATION
I, HEREBY CERTIFY THAT THE CIRCLED GRADES ARE EXISTING FINISH GRADES CHECKED IN THE FIELD ON _____, 20___ AND ARE CORRECT TO THE BEST OF MY KNOWLEDGE AND BELIEF.

REGISTERED SURVEYOR REG. NO.

BM–SANITARY MANHOLE
ELEV–707.51

Grading Plan Approved
as shown and/or noted
JAMES R. GILLS, P.E.
Lake County Engineer
By GH Date 7/3/02

NOTE: TEMPORARY SEEDING REQUIRED IN DISTURBED AREAS.

CONCORD TOWNSHIP ZONING OFFICE
ZONING PERMIT # 0602-10642
ISSUED 6-27-02
SUBJECT TO COMPLIANCE WITH:
☐ [illegible]
☐ [illegible]
☐ [illegible] Comm.
☑ Lake Co. Building Dept.
☑ Lake Co. Soil & Water Cons. Dist.

STATE OF OHIO
HARRY S. JONES, JR.
S-6343
REGISTERED
PROFESSIONAL SURVEYOR