SITE PLAN

CONCORD TOWNSHIP, LAKE COUNTY, OHIO

for: KNEZ CONSTRUCTION
CLIENT OWNER

ADDRESS STREET CITY ZIP

ELLISON CREEK — SUBDIVISION
39–17 — VOL.–PG.
NAME
TRACT
STREET
51 — SUBLOT NO.
LOT
DEERHAVEN DRIVE — STREET
VOL.–PG.
PERM. PARCEL NO.

LEGEND

SANITARY MANHOLE
STORM MANHOLE
INLET OR CATCH BASIN
HYDRANT
EXISTING CONTOURS
PROPOSED CONTOURS

EXIST. ELEV. 100.0 / 100.0 PROP. ELEV.

AS BUILT ELEVATION

INDICATES DIRECTION OF SURFACE DRAINAGE

REMARKS

ALL BOUNDARY DATA SHOWN WAS OBTAINED FROM (DEEDS, RECORDED SUBDIVISION PLAT OR OTHER PUBLIC RECORDS)

LOCATIONS AS SHOWN OF ADJACENT WELLS AND SEPTIC TANKS OBTAINED FROM LAKE COUNTY HEALTH DEPARTMENT

DESIGN CERTIFICATION

THIS PLAT WAS PREPARED BY ME, AND IS CORRECT TO THE BEST OF MY KNOWLEDGE AND BELIEF.

NAME SURVEYOR REGISTRATION NO. #6343

CHECK LIST

NO. OF BEDROOMS
DIMENSIONS
BEARINGS
TIE TO NEAREST STREET
SUBLOT NO. PARCEL NO.
SURROUNDING OWNERS
BLDG. DIMENSIONS FIN GR.
BLDG. TIES FL'R. GRADES
APRON TYPE WIDTH THICKNESS
SIDEWALK TYPE WIDTH THICKNESS
CULVERT TYPE DIA., LENGTH
ROCK OUTCROPPINGS

WATER MAIN SIZE, LOCATION
SAN. SEWER SIZE % GR. LOC.
SAN. MH. CAST. ELEV. INV. ELEV.
SAN. CONN. SIZE, LOC. DEPTH
STORM SEWER SIZE % GR. LOC.
STORM MH. CAST ELEV. INV. ELEV.
PAV'T TYPE GRADE CURBS
GAS LINE LOC. SIZE PRESSURE
SEPTIC TANK LOCATION & DUPLICATION AREA
WELL LOCATION
ISOLATION RADIUS FROM WELL

REVISIONS		
NO.	DATE	BY
1	6/24/02	B.P.
2		
3		
4		
5		

PLAN PREPARED BY:
BABCOCK · JONES & ASSOCIATES, INC.
PAINESVILLE, OHIO

DRAWN BY B.P.	SCALE 1"=40'	PHONE NO. 440–357–1811	
CHK'D. H.J.	DATE 2/20/02	DRAWING NO. 00–265–51	
CREW CHIEF R.B.	APP'D H.J.		

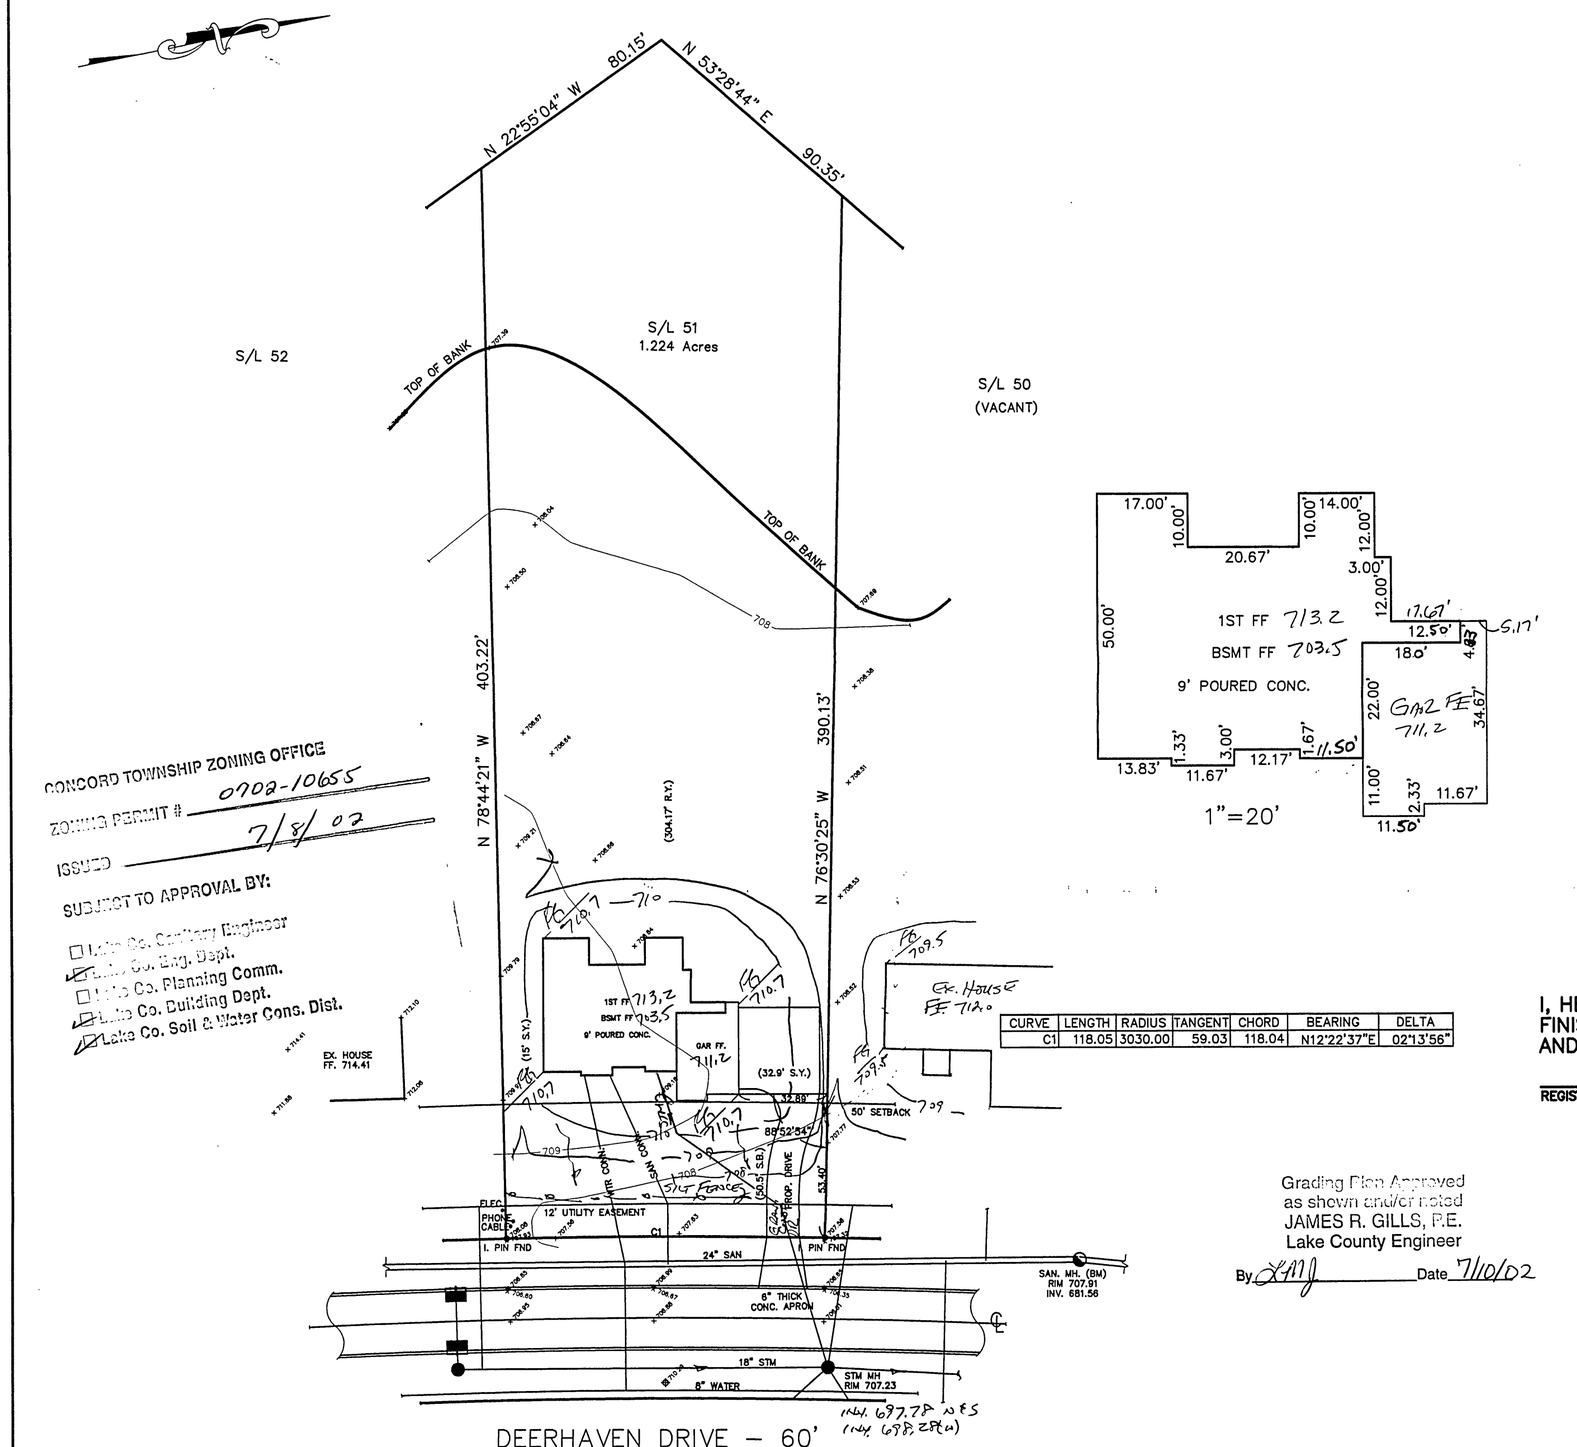

1"=20'

CURVE	LENGTH	RADIUS	TANGENT	CHORD	BEARING	DELTA
C1	118.05	3030.00	59.03	118.04	N12°22'37"E	02°13'56"

CONCORD TOWNSHIP ZONING OFFICE
ZONING PERMIT # 0702-10655
ISSUED 7/8/02
SUBJECT TO APPROVAL BY:
- ☐ Lake Co. Sanitary Engineer
- ☑ Lake Co. Eng. Dept.
- ☐ Lake Co. Planning Comm.
- ☑ Lake Co. Building Dept.
- ☑ Lake Co. Soil & Water Cons. Dist.

Grading Plan Approved as shown and/or noted
JAMES R. GILLS, P.E.
Lake County Engineer
By JRG Date 7/10/02

"AS BUILT" CERTIFICATION

I, HEREBY CERTIFY THAT THE CIRCLED GRADES ARE EXISTING FINISH GRADES CHECKED IN THE FIELD ON _____, 20___ AND ARE CORRECT TO THE BEST OF MY KNOWLEDGE AND BELIEF.

REGISTERED SURVEYOR REG. NO.

BM–SANITARY MANHOLE #2
RIM=707.91

NOTE: TEMPORARY SEEDING REQUIRED IN DISTURBED AREAS.

STATE OF OHIO
HARRY S. JONES, JR.
S–6343
REGISTERED
PROFESSIONAL SURVEYOR