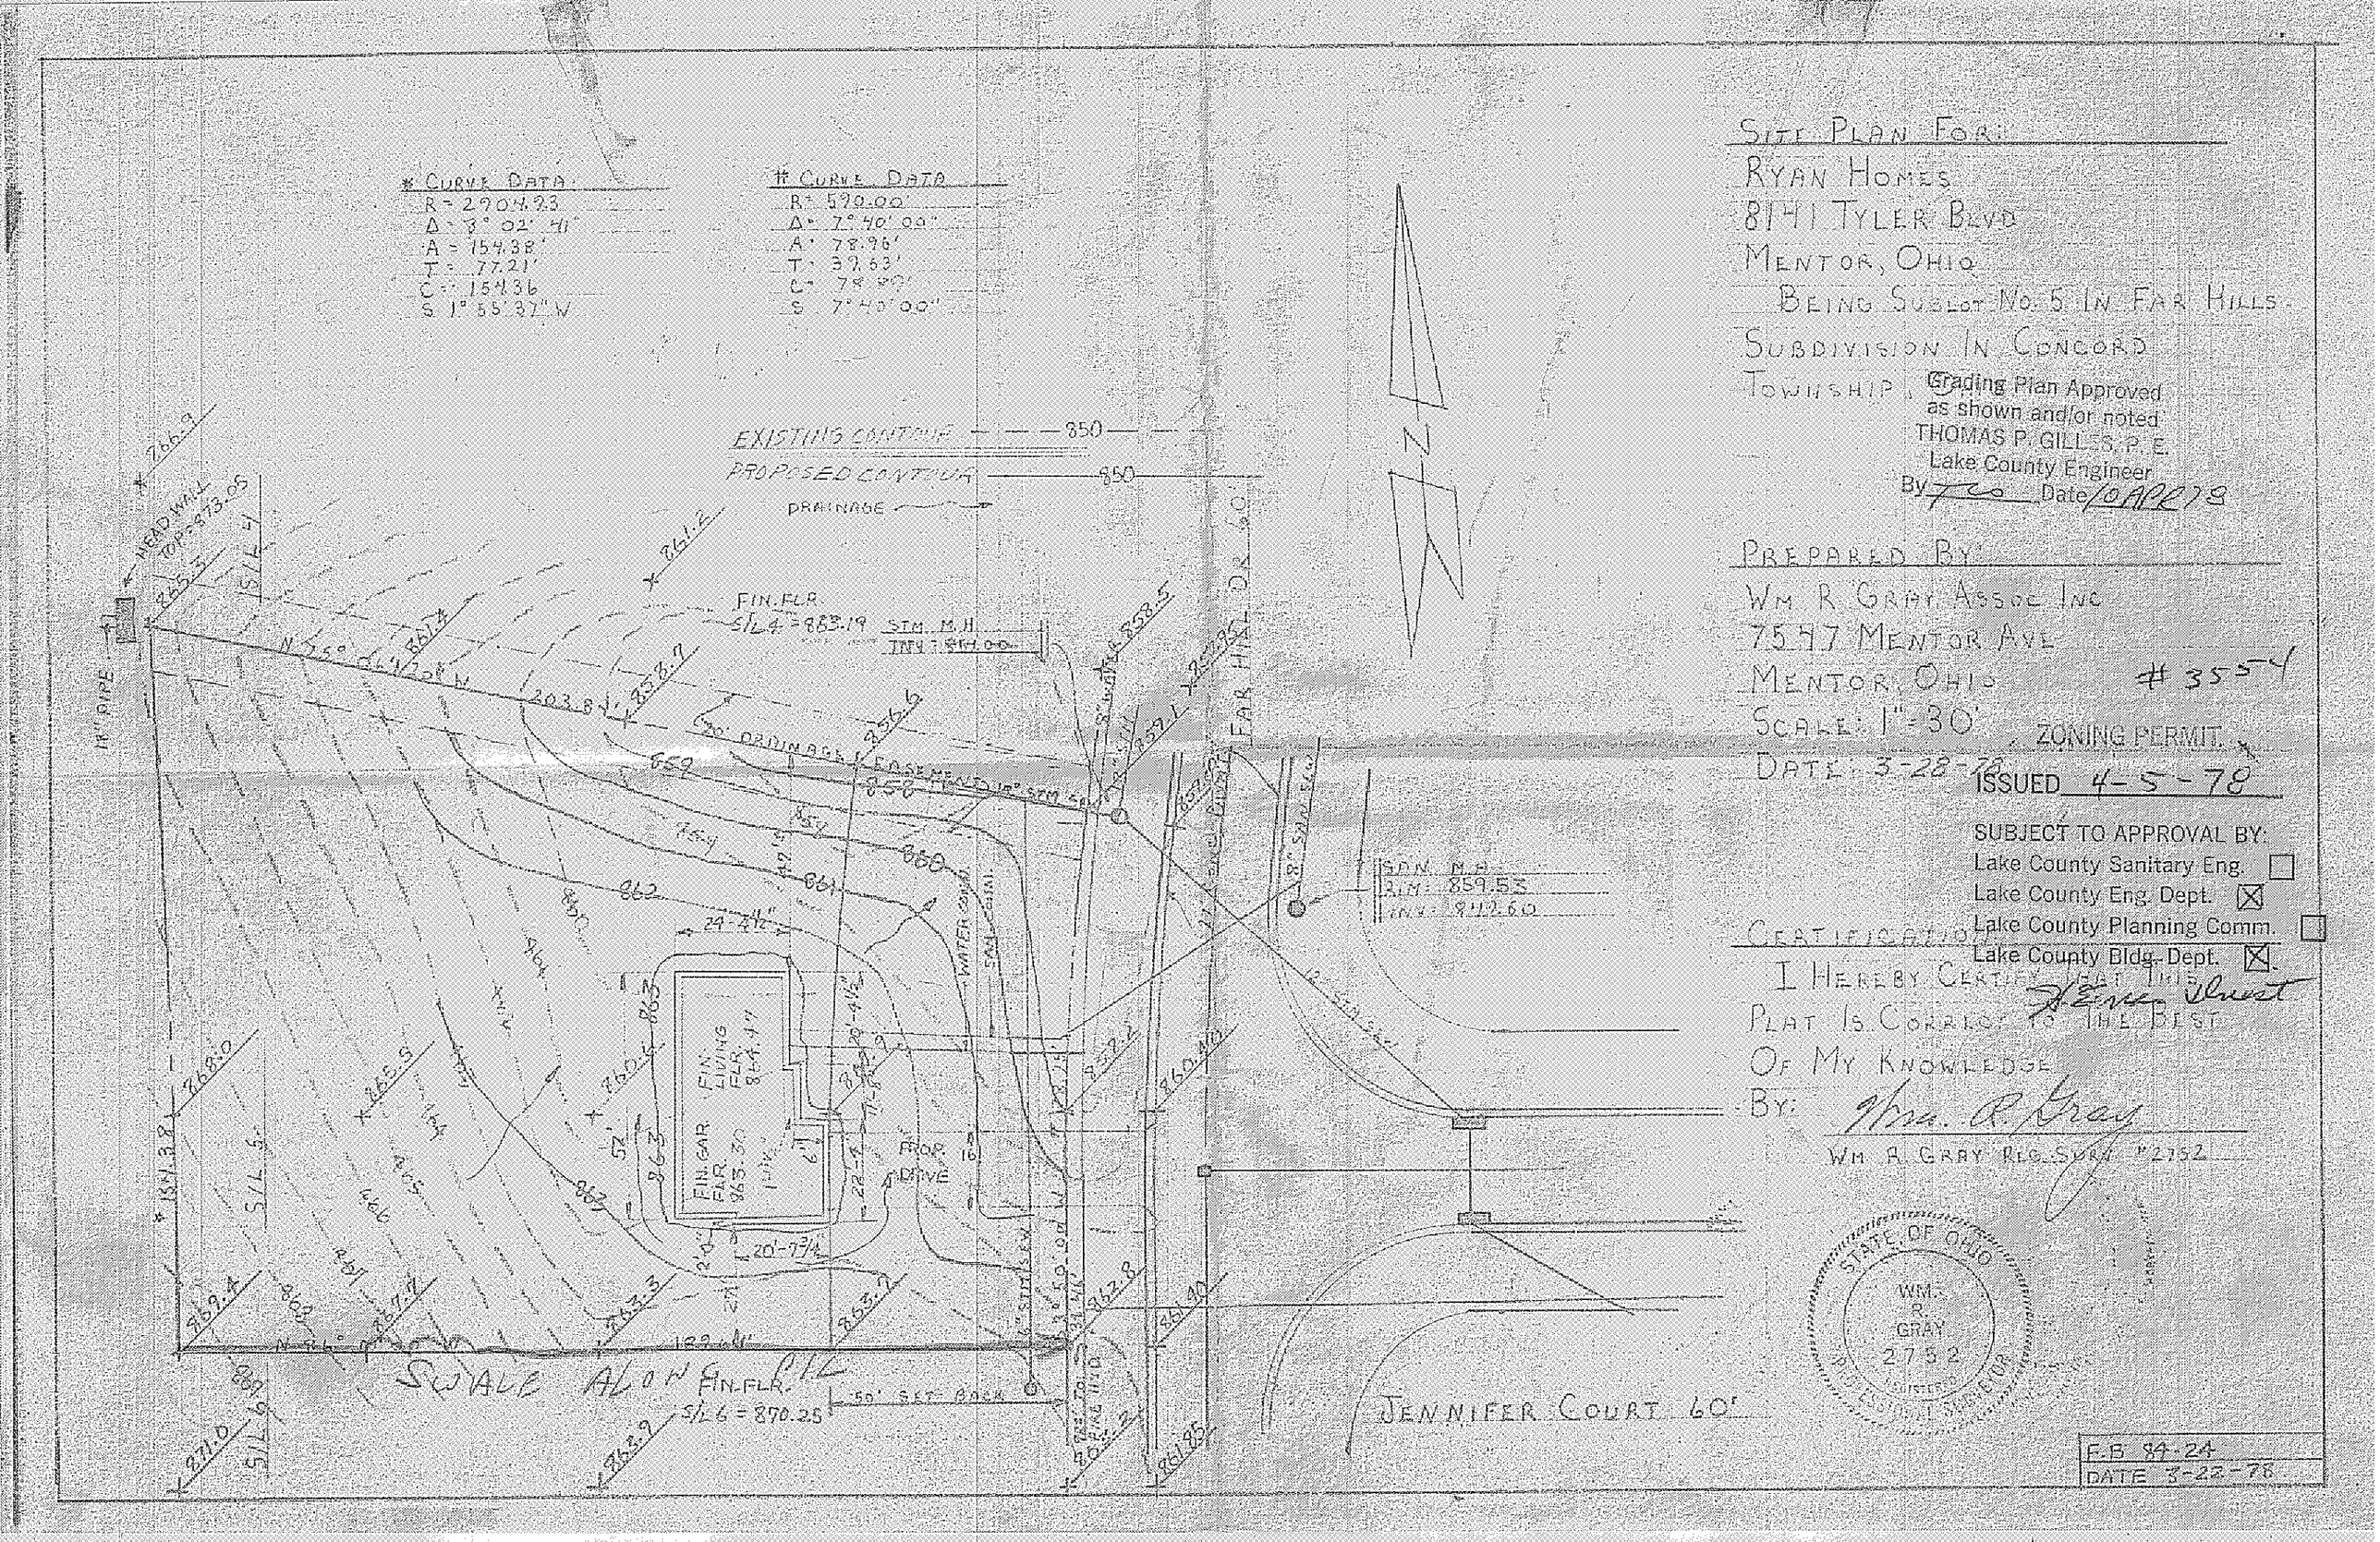

SITE PLAN FOR:
RYAN HOMES
8141 TYLER BLVD
MENTOR, OHIO
BEING SUBLOT NO. 5 IN FAR HILLS
SUBDIVISION IN CONCORD
TOWNSHIP

Grading Plan Approved
as shown and/or noted
THOMAS P. GILLIS, P.E.
Lake County Engineer
By _____ Date 10 APR 78

PREPARED BY:
WM. R. GRAY ASSOC. INC
7597 MENTOR AVE
MENTOR, OHIO
SCALE: 1" = 30'
DATE: 3-28-78

#3554
ZONING PERMIT
ISSUED 4-5-78

SUBJECT TO APPROVAL BY:
Lake County Sanitary Eng. ☐
Lake County Eng. Dept. ☒
Lake County Planning Comm. ☐
Lake County Bldg. Dept. ☒

CERTIFICATION
I HEREBY CERTIFY THAT THIS PLAT IS CORRECT TO THE BEST OF MY KNOWLEDGE
BY: Wm. R. Gray
WM. R. GRAY REG. SURV. #2752

STATE OF OHIO
WM. R. GRAY
2752
REGISTERED
PROFESSIONAL SURVEYOR

F.B. 84-24
DATE 3-22-78