S/L 64

FAR HILLS

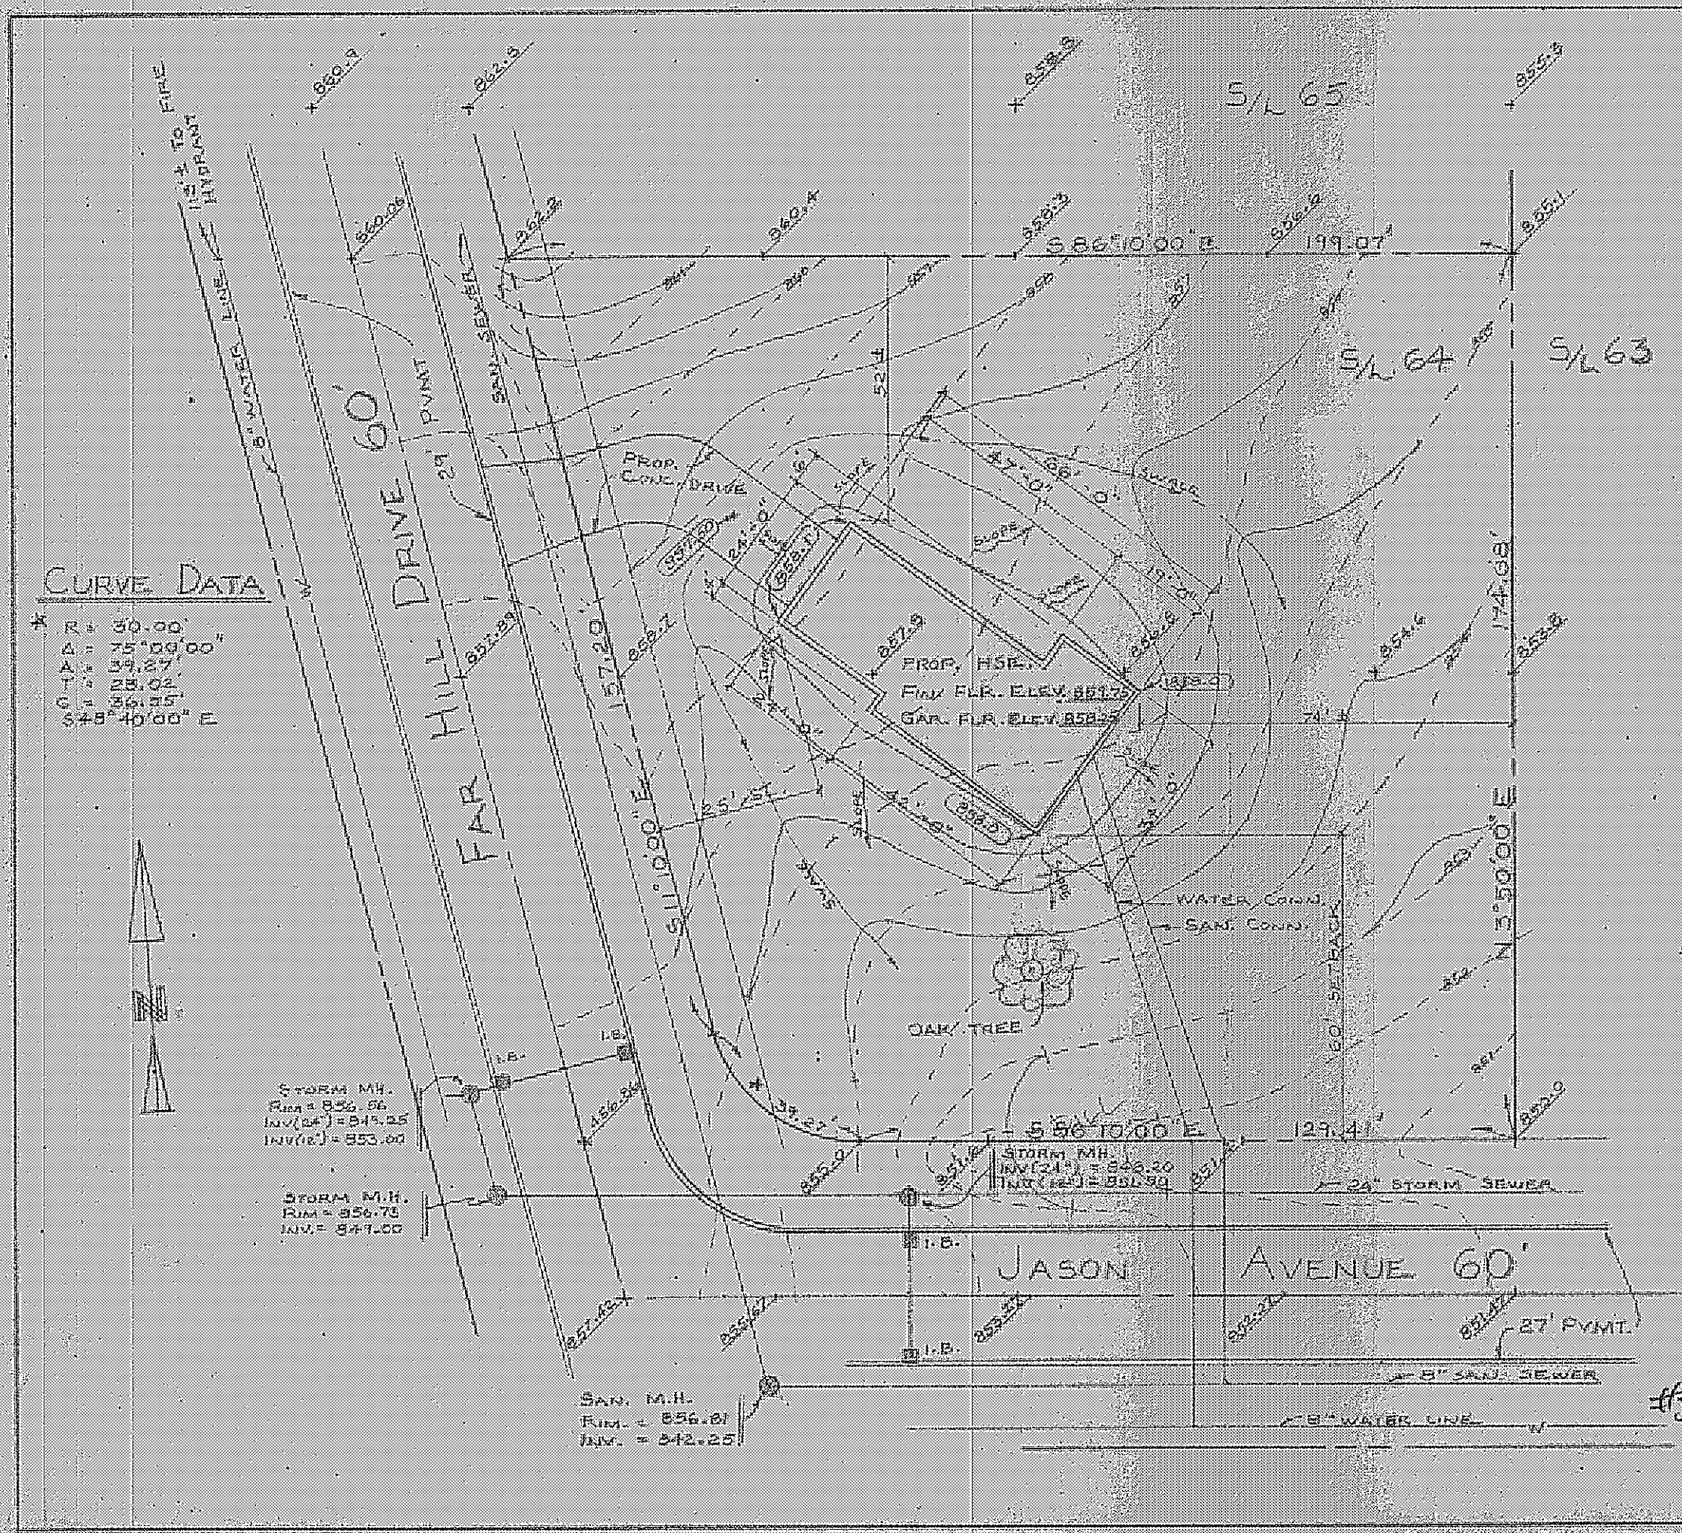

SITE PLAN FOR:

RYAN HOMES
8141 TYLER BLVD.
MENTOR, OHIO

BEING SUBLOT NUMBER 64 IN THE FAR HILLS ESTATES NUMBER 2 IN CONCORD TWP., LAKE COUNTY, OHIO

PREPARED BY:

WM. R. GRAY ASSOC. INC.
7547 MENTOR AVENUE
MENTOR, OHIO

SCALE: 1" = 30'

DATE: MAY 3, 1977

CERTIFICATION:

I HEREBY CERTIFY THAT THIS PLAT IS CORRECT TO THE BEST OF MY KNOWLEDGE.

BY: [signature]

WM. R. GRAY REG. SURV. # 2752

Grading Plan Approved as shown Error noted
THOMAS P. GILLES, P.E.
Lake County Engineer
By [signature] Date 5/23/77

ZONING PERMIT

#3274

Approved [signature]
5-17-77

STATE OF OHIO
WM. R. GRAY
2752
REGISTERED PROFESSIONAL SURVEYOR