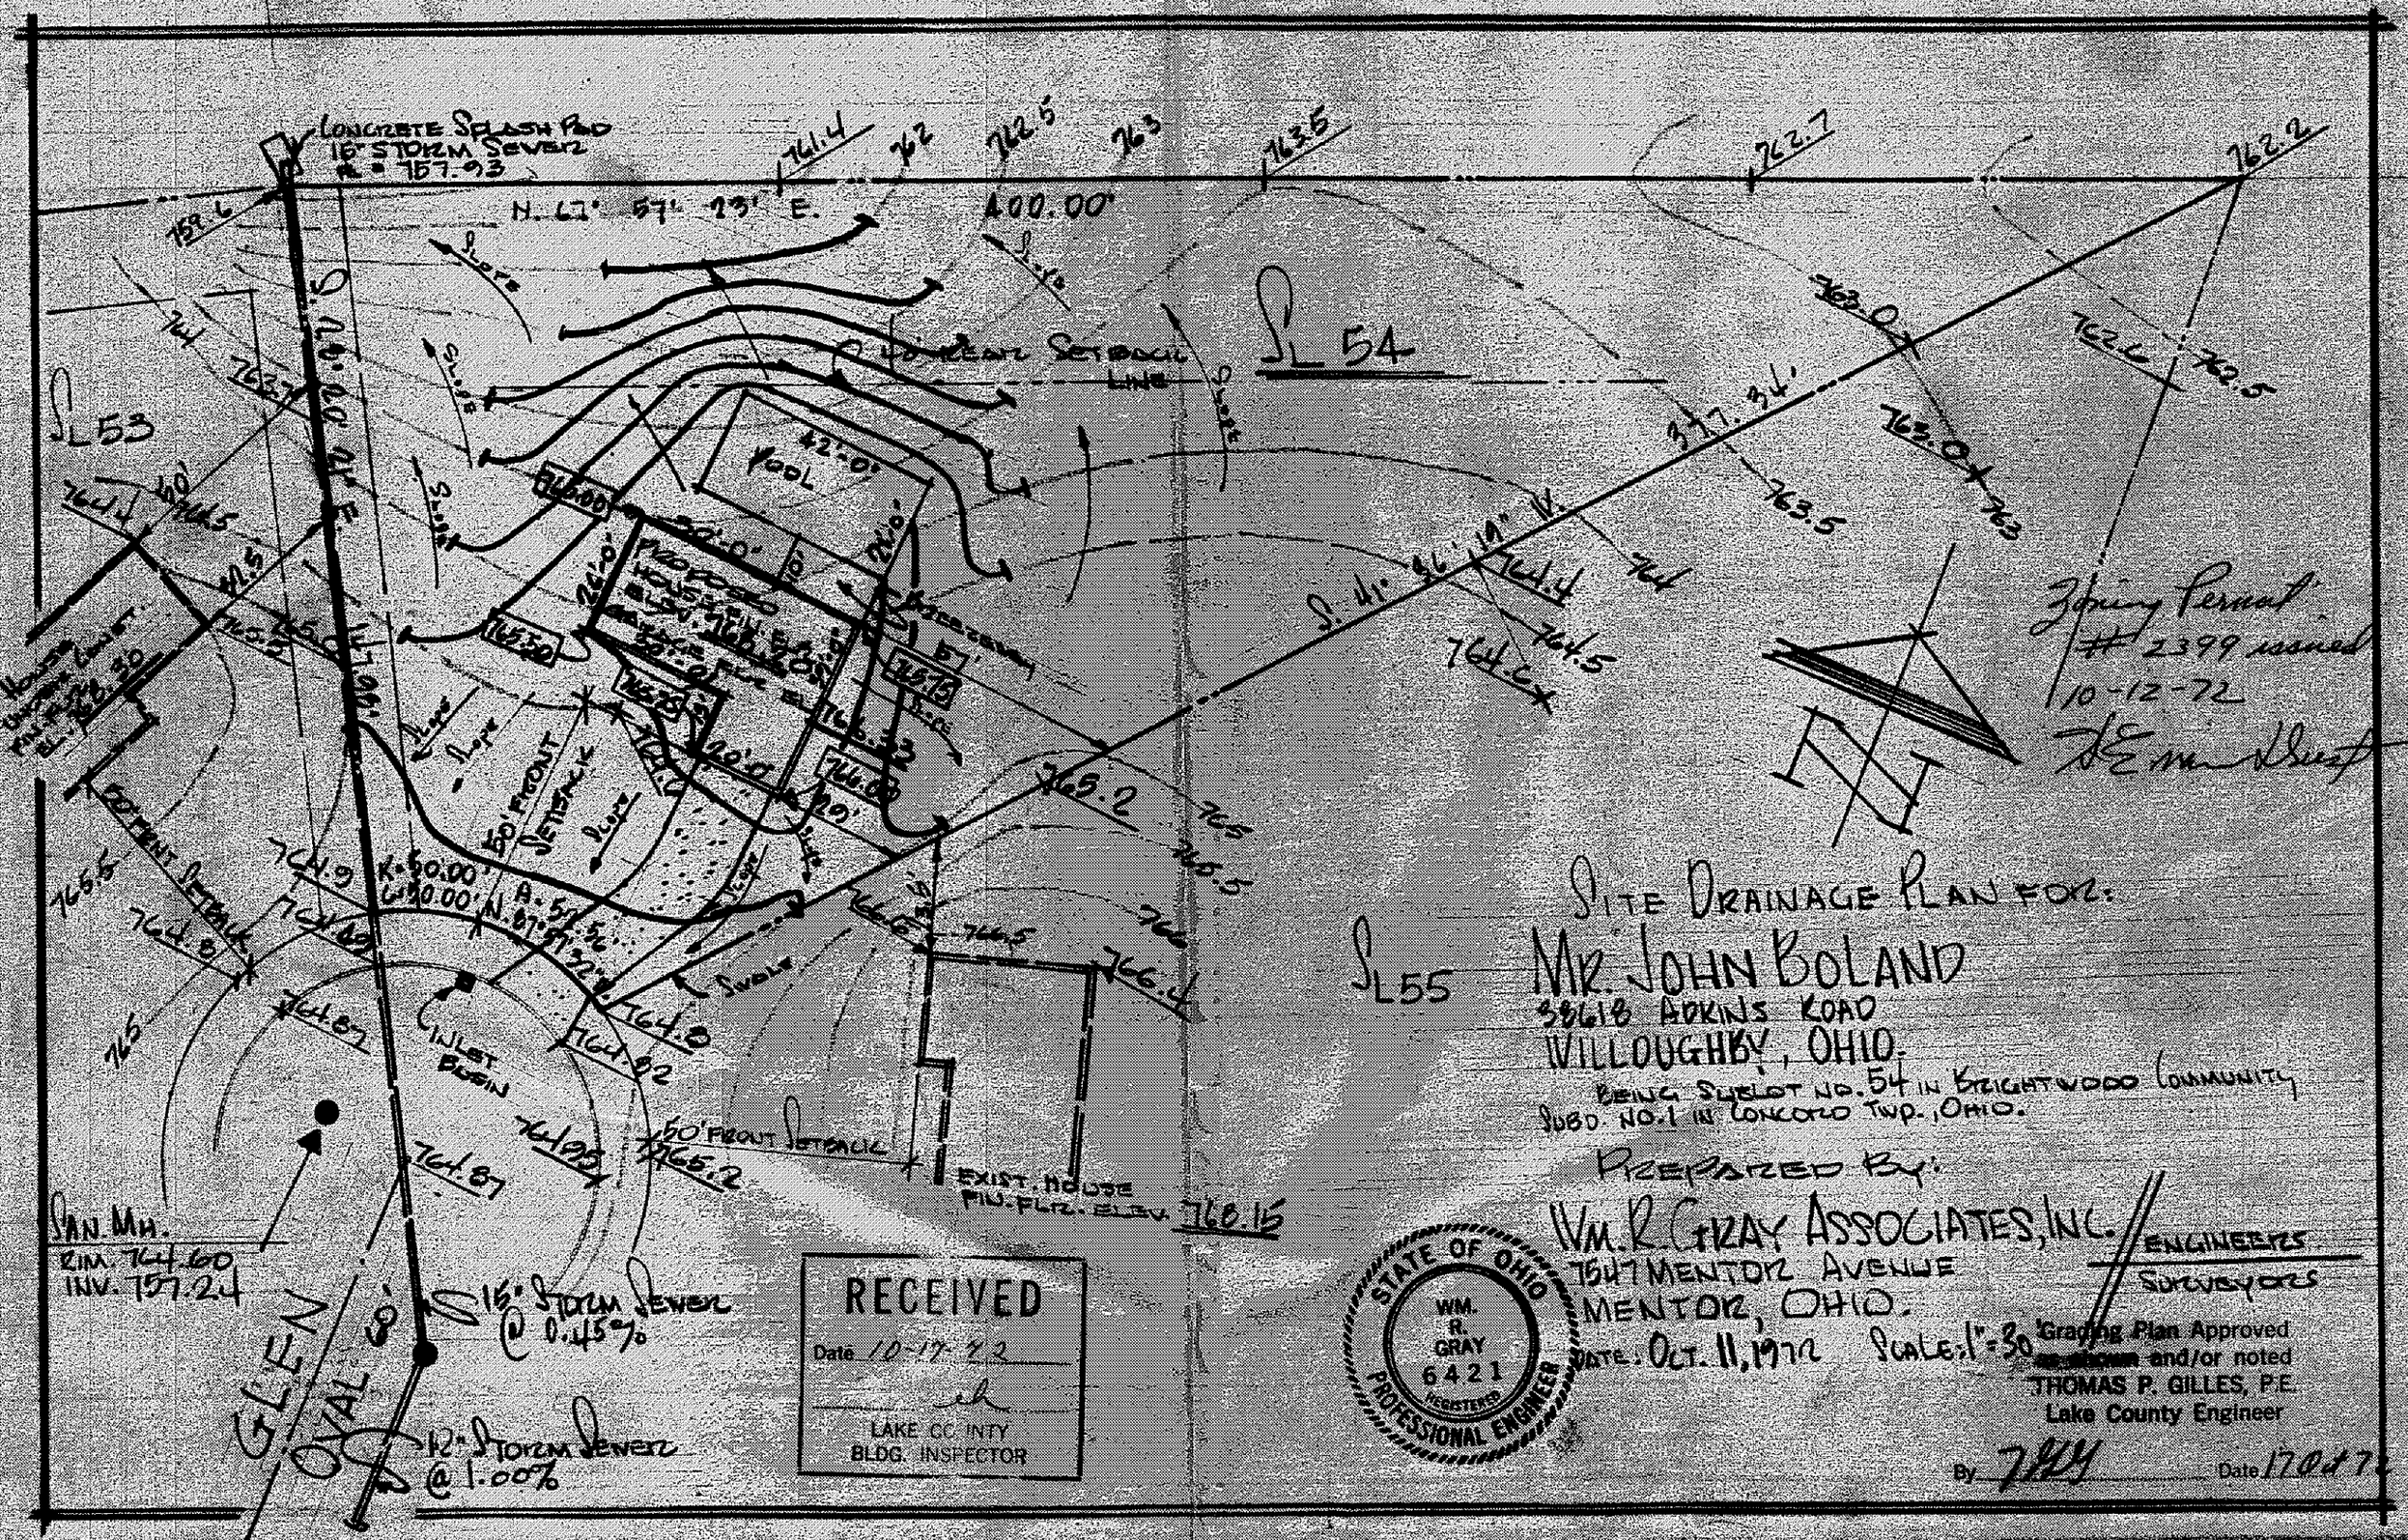

Site Drainage Plan for:

Mr. John Boland
38618 Adkins Road
Willoughby, Ohio.

Being Sublot No. 54 in Brightwood Community
Subd. No. 1 in Concord Twp., Ohio.

Prepared By:

Wm. R. Gray Associates, Inc.
7547 Mentor Avenue
Mentor, Ohio.

Engineers
Surveyors

Date: Oct. 11, 1972 Scale: 1" = 30'

Grading Plan Approved
as shown and/or noted
Thomas P. Gilles, P.E.
Lake County Engineer

By [signature] Date 17 Oct 72

RECEIVED
Date 10-17-72
[signature]
LAKE COUNTY
BLDG. INSPECTOR

STATE OF OHIO
WM. R. GRAY
6421
REGISTERED
PROFESSIONAL ENGINEER