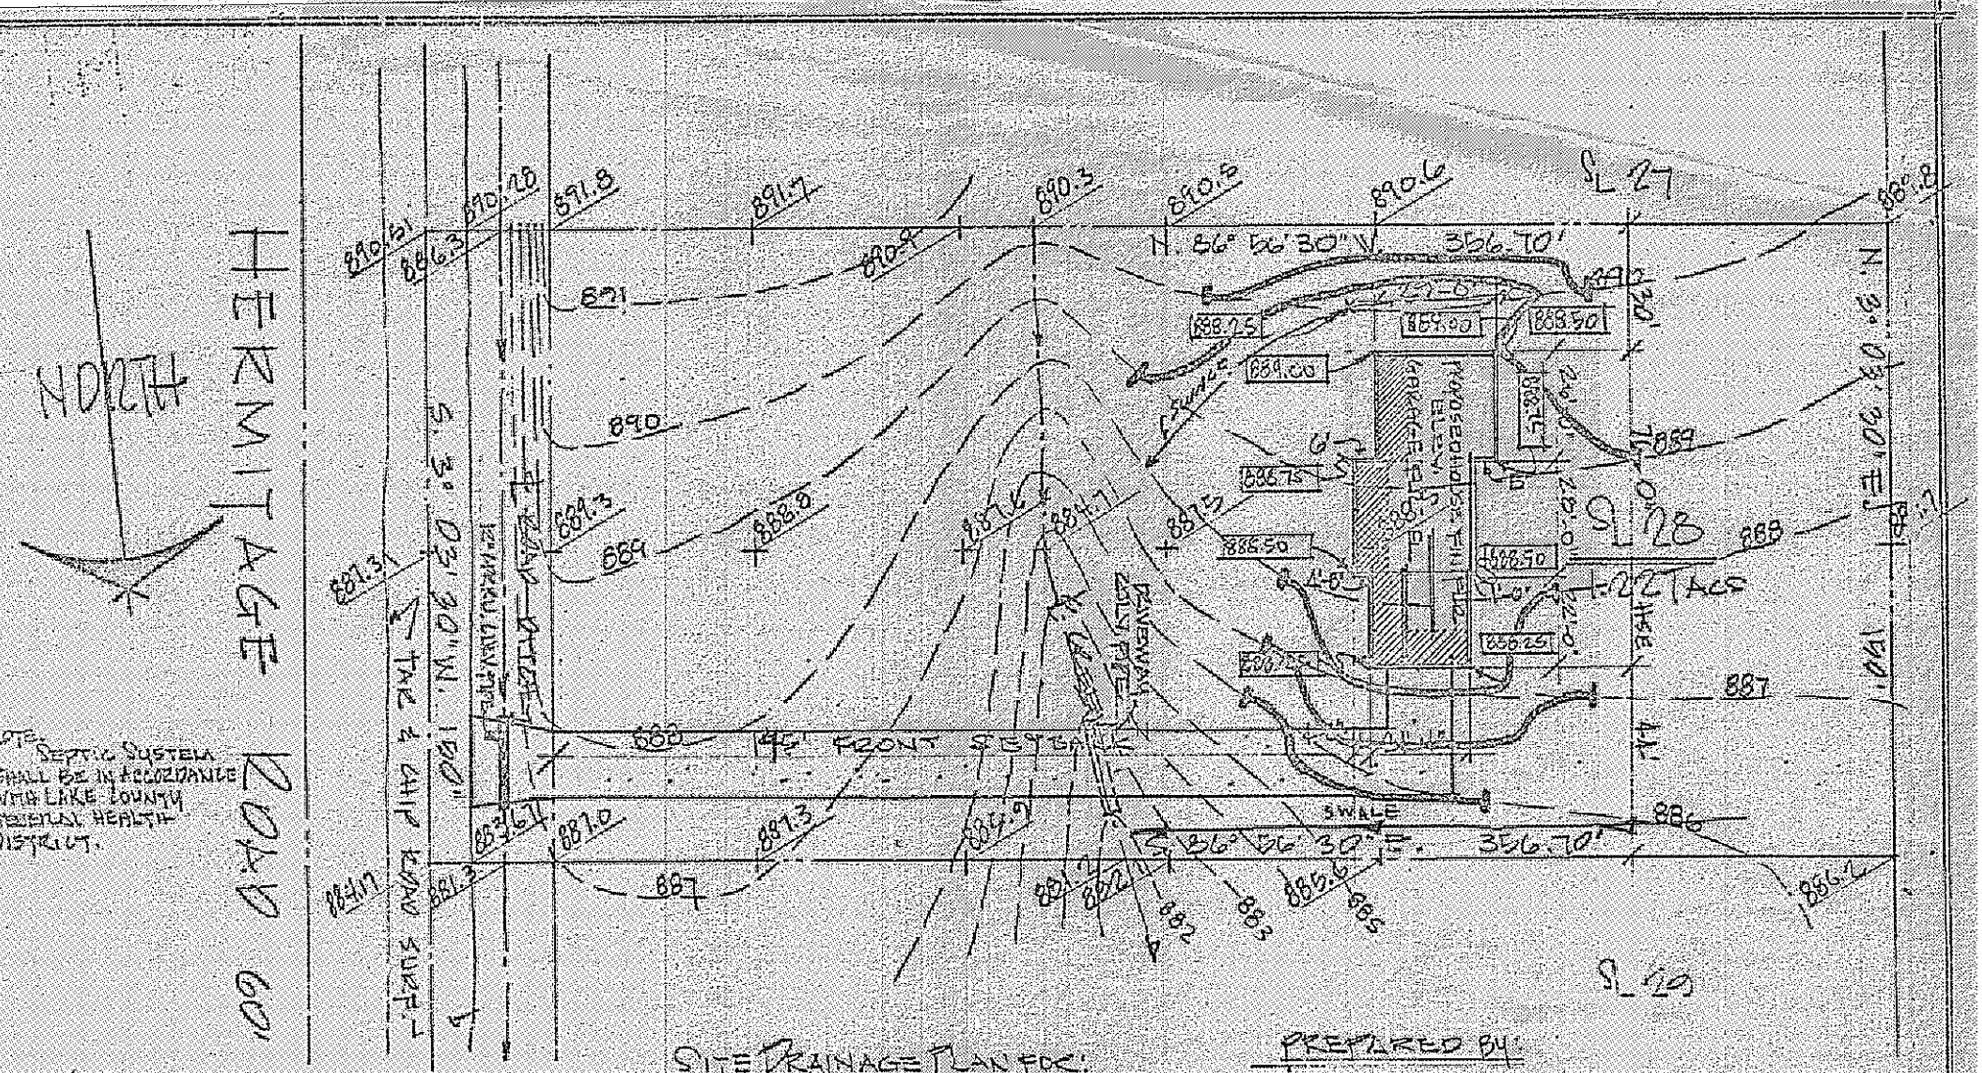

NOTE: SEPTIC SYSTEM SHALL BE IN ACCORDANCE WITH LAKE COUNTY GENERAL HEALTH DISTRICT.

- CERTIFICATION -
I HEREBY CERTIFY THAT THIS PLAT IS CORRECT TO THE BEST OF MY KNOWLEDGE:
BY: Wm. R. Gray
WM. R. GRAY, P.E. #6421 & R.S. #2752

SITE DRAINAGE PLAN FOR:
MAJESTIC HOMES
9764 CHILLICOTHE ROAD
KIRTLAND, OHIO.
BEING SUBLOT NO. 28 IN THE HERMITAGE CREST SUBD. IN CONCORD TWP., OHIO.

PREPARED BY:
WM. R. GRAY ASSOC., INC.
7547 MENTOR AVENUE
MENTOR, OHIO 44060
CIVIL ENGINEERS
SURVEYORS
DATE JUNE 20, 1973 SCALE: 1" = 30' DRAWN BY: [illegible]

Grading [illegible]
as shown and/or [illegible]
THOMAS P. GILLES, P.E.
Lake County Engineer
By D.J.L. Date 8/13/73

Zoning Permit # 2540 issued
Aug 9-73
H.E. [illegible]