T. THOS. MARCELLI ARCHITEC

RES. OF ANTHONY D. RODRIGUEZ SL Zoning Permit
# 2409 Issued 11-2-72
HE [illegible]

Grading Plan Approved
as shown and/or noted
THOMAS P. GILLES, P.E.
Lake County Engineer

By JWK Date 8 Nov 1972

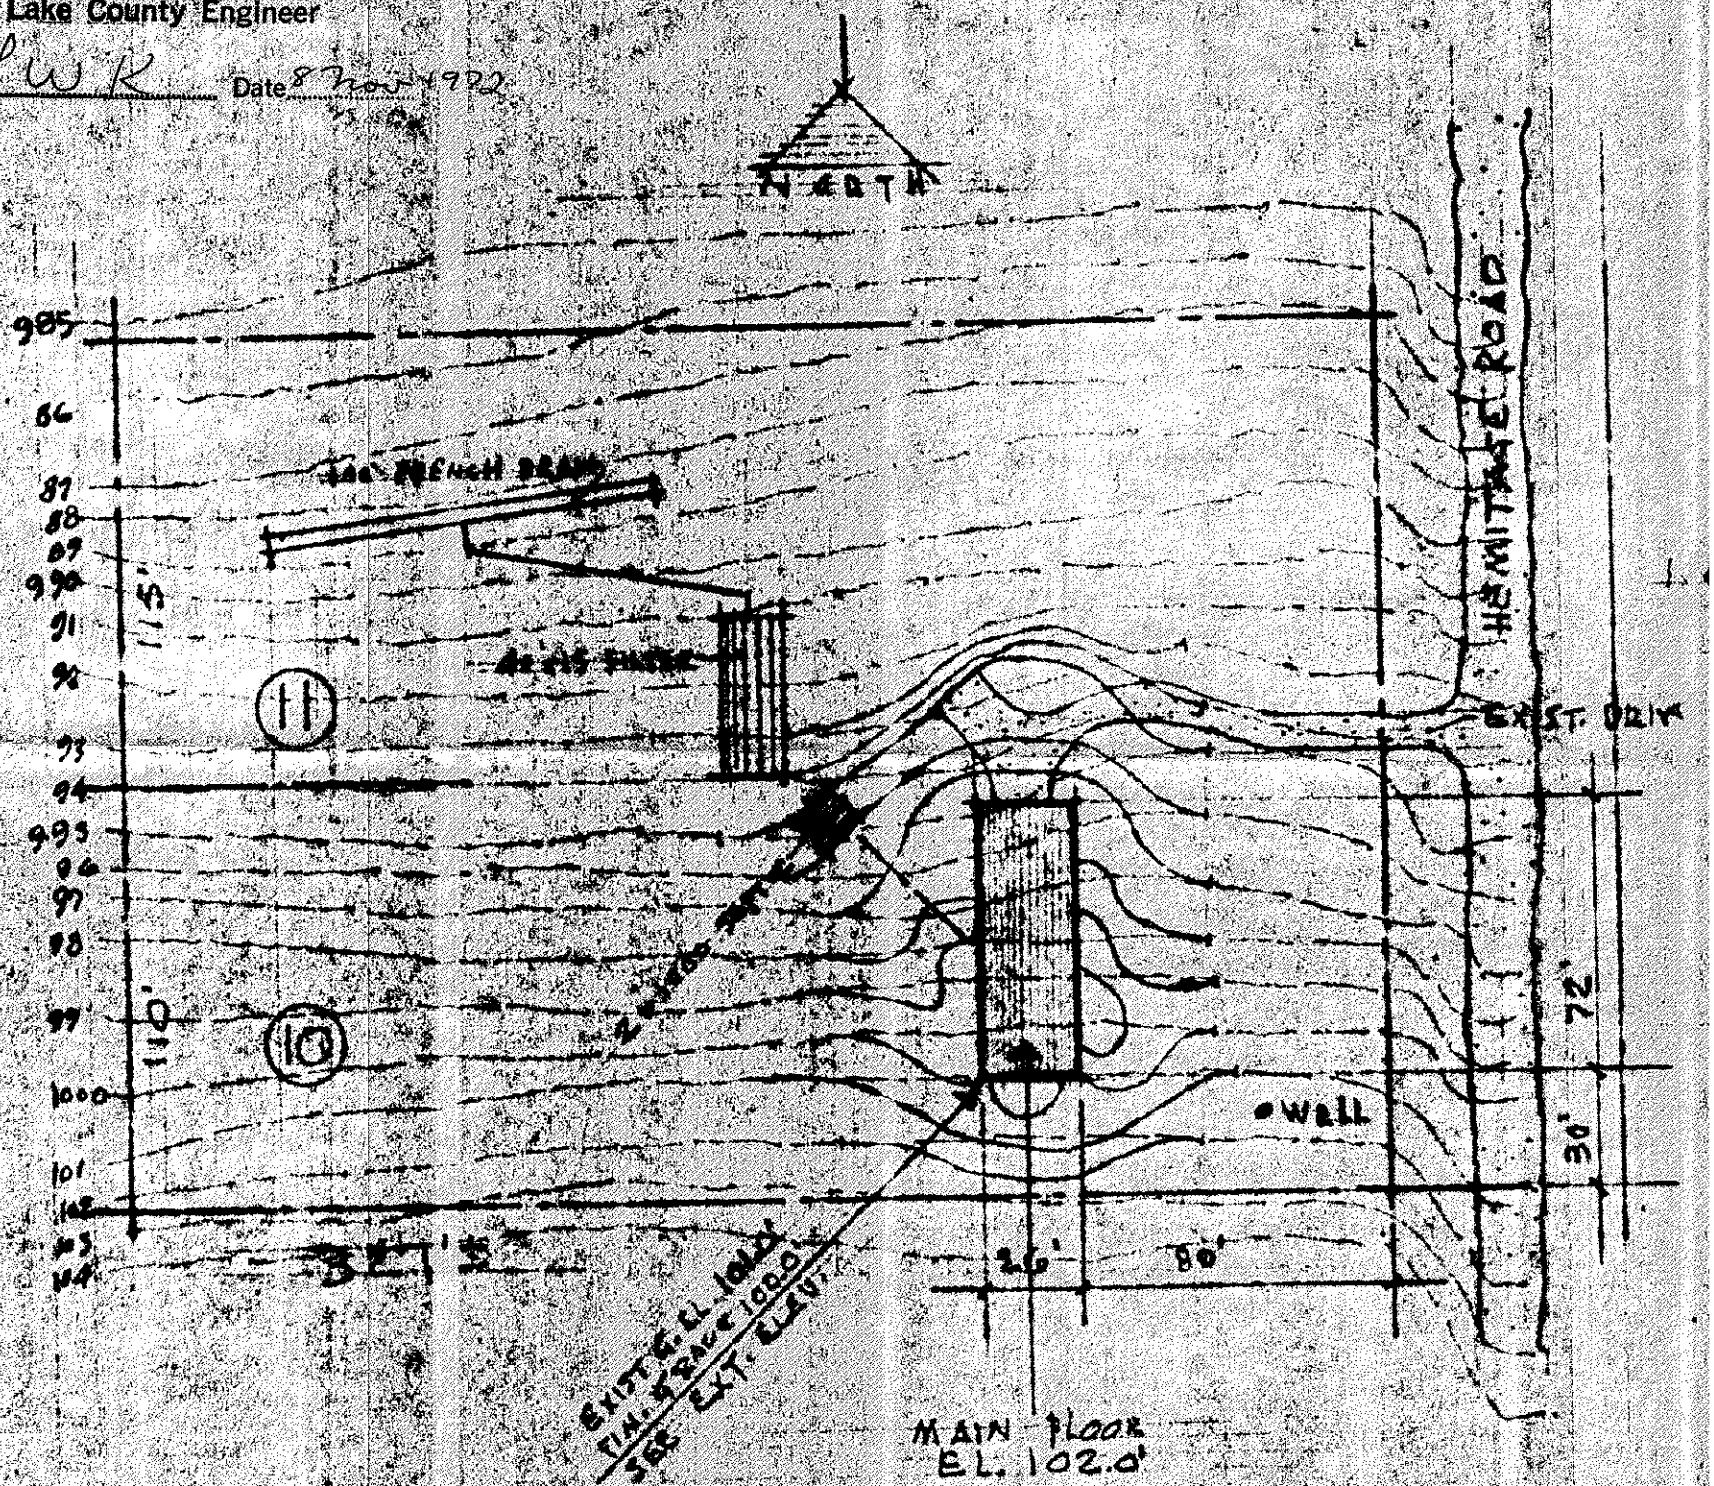


SITE PLAN - 1/50th SCALE