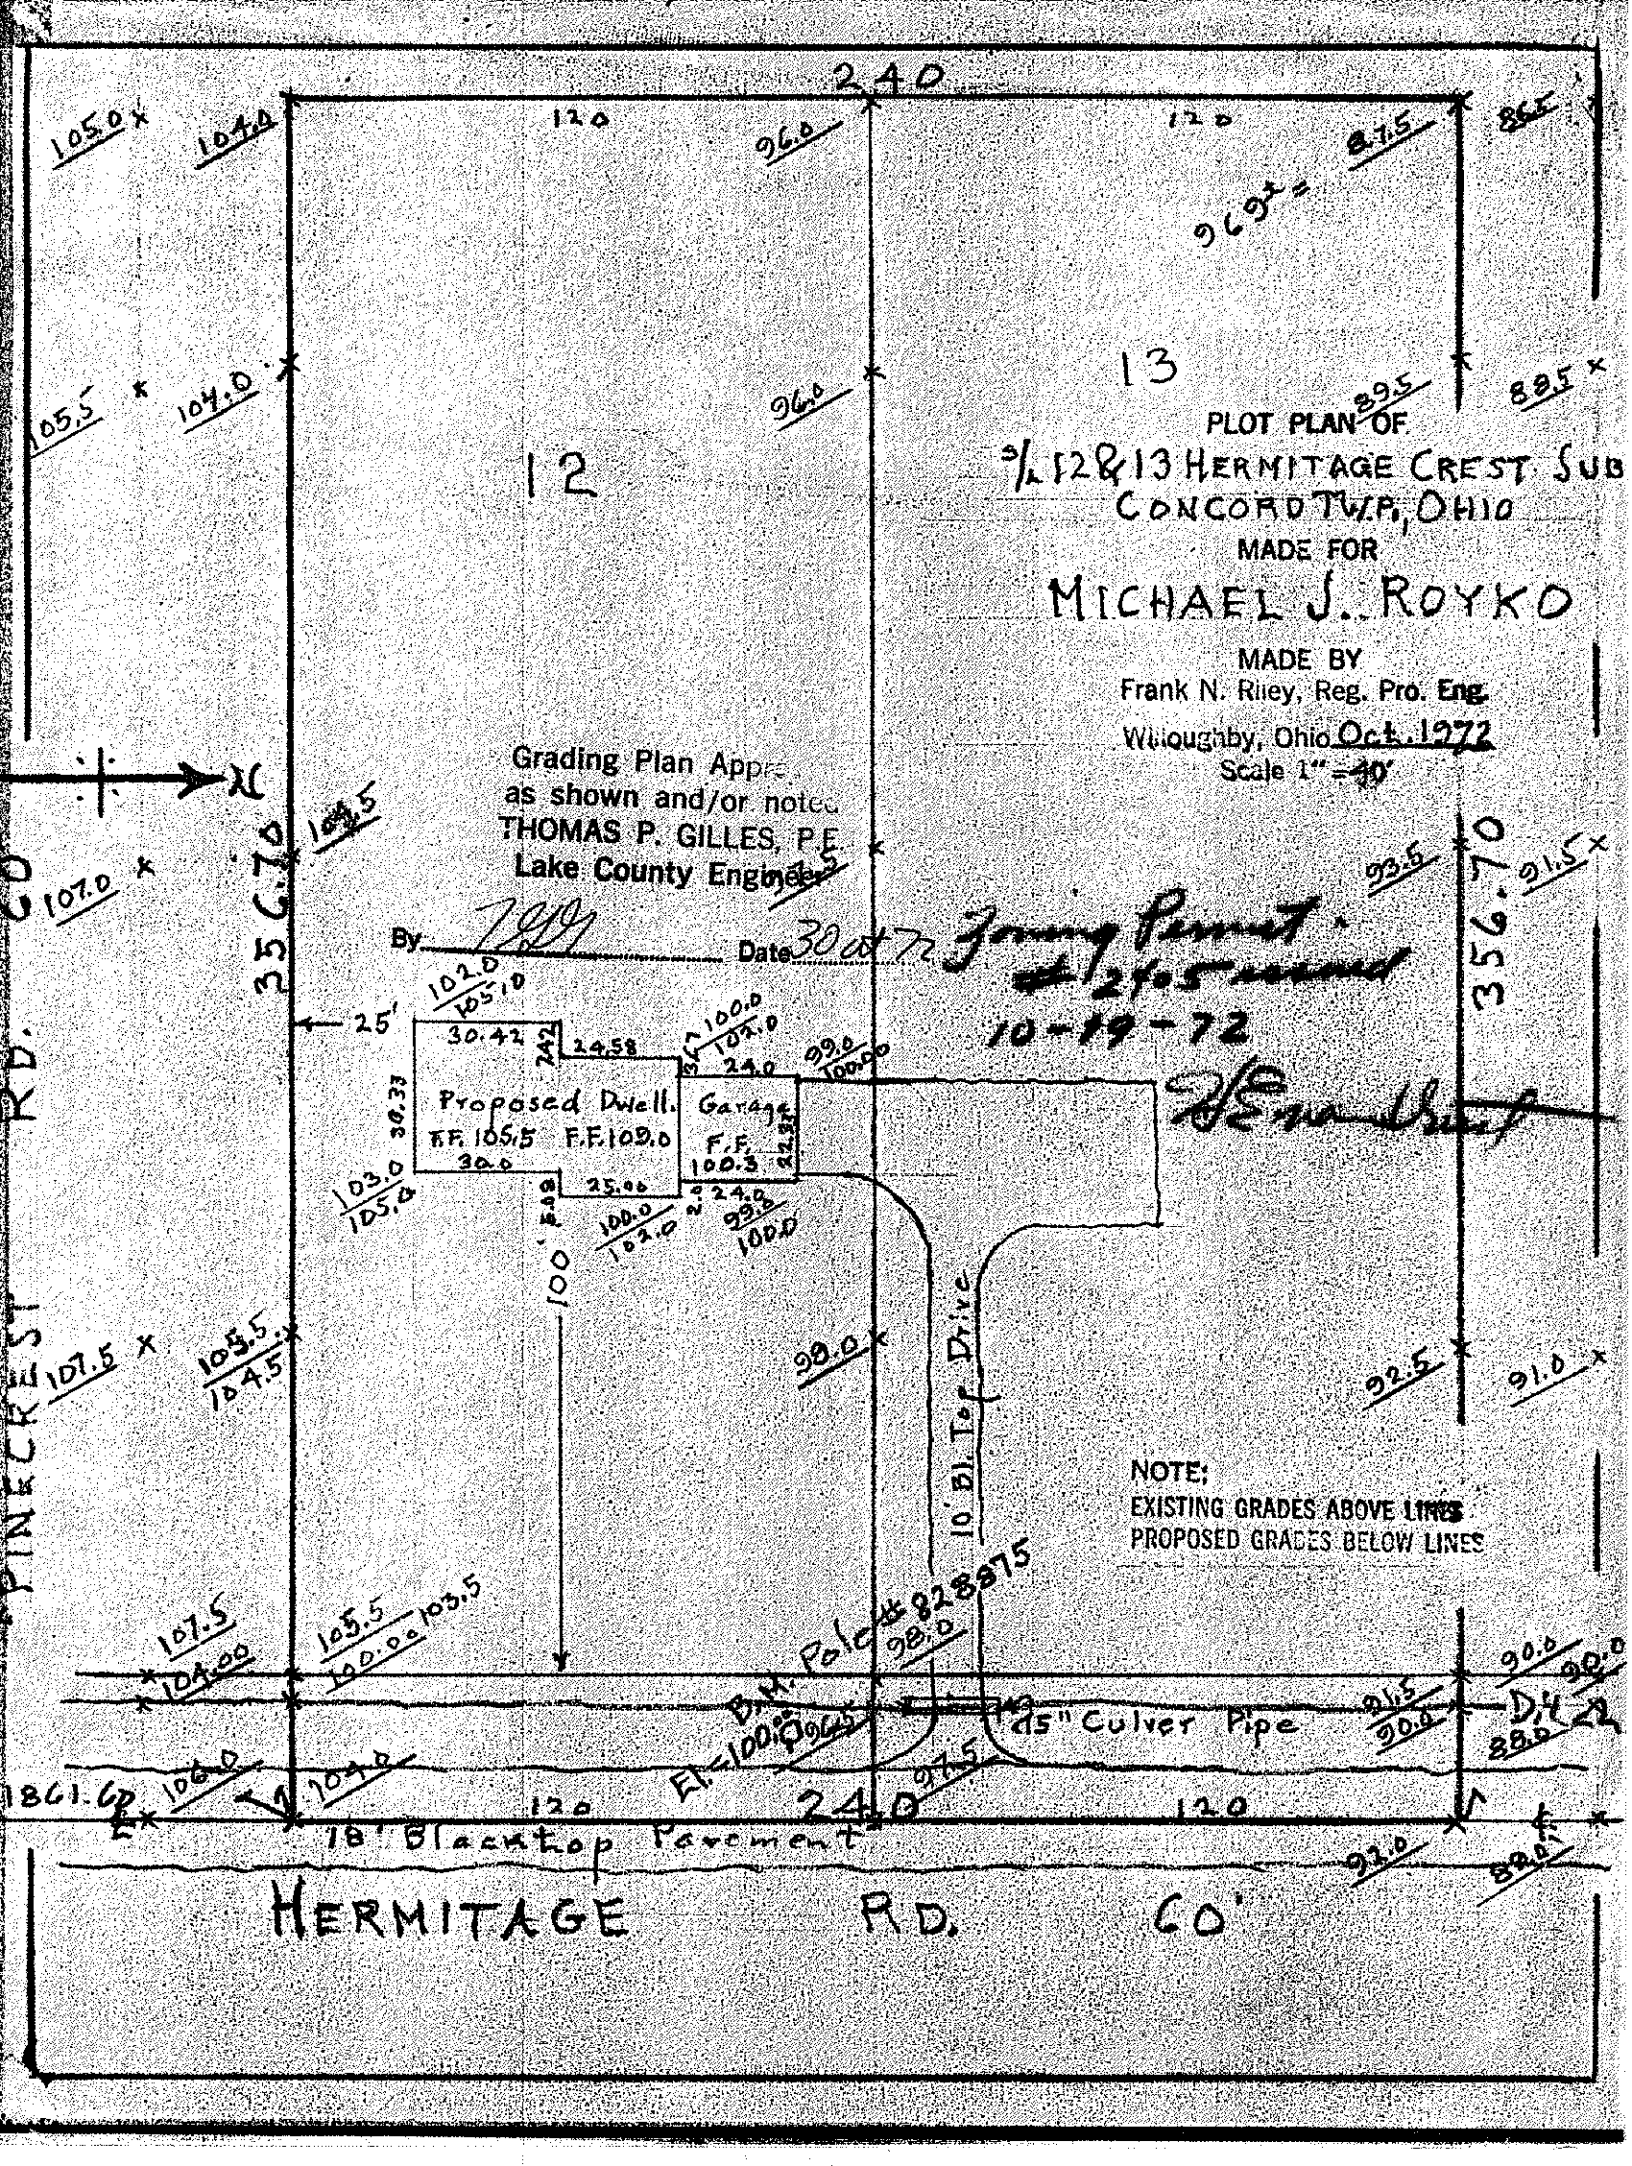

PLOT PLAN OF
S/L 12 & 13 HERMITAGE CREST SUB
CONCORD TWP., OHIO
MADE FOR
MICHAEL J. ROYKO
MADE BY
Frank N. Riley, Reg. Pro. Eng.
Willoughby, Ohio Oct. 1972
Scale 1" = 40'
Grading Plan Appr
as shown and/or noted
THOMAS P. GILLES, P.E.
Lake County Engineer
By
Date 30 Oct 72
Zoning Permit
#2405 issued
10-19-72
Proposed Dwell.
F.F. 105.5
F.F. 109.0
Garage
F.F. 100.3
NOTE:
EXISTING GRADES ABOVE LINES
PROPOSED GRADES BELOW LINES
10' Bl. Top Drive
Pole #828875
15" Culver Pipe
18' Blacktop Pavement
HERMITAGE RD. 60'
PINECREST RD. 60
356.70
240
120
13
12