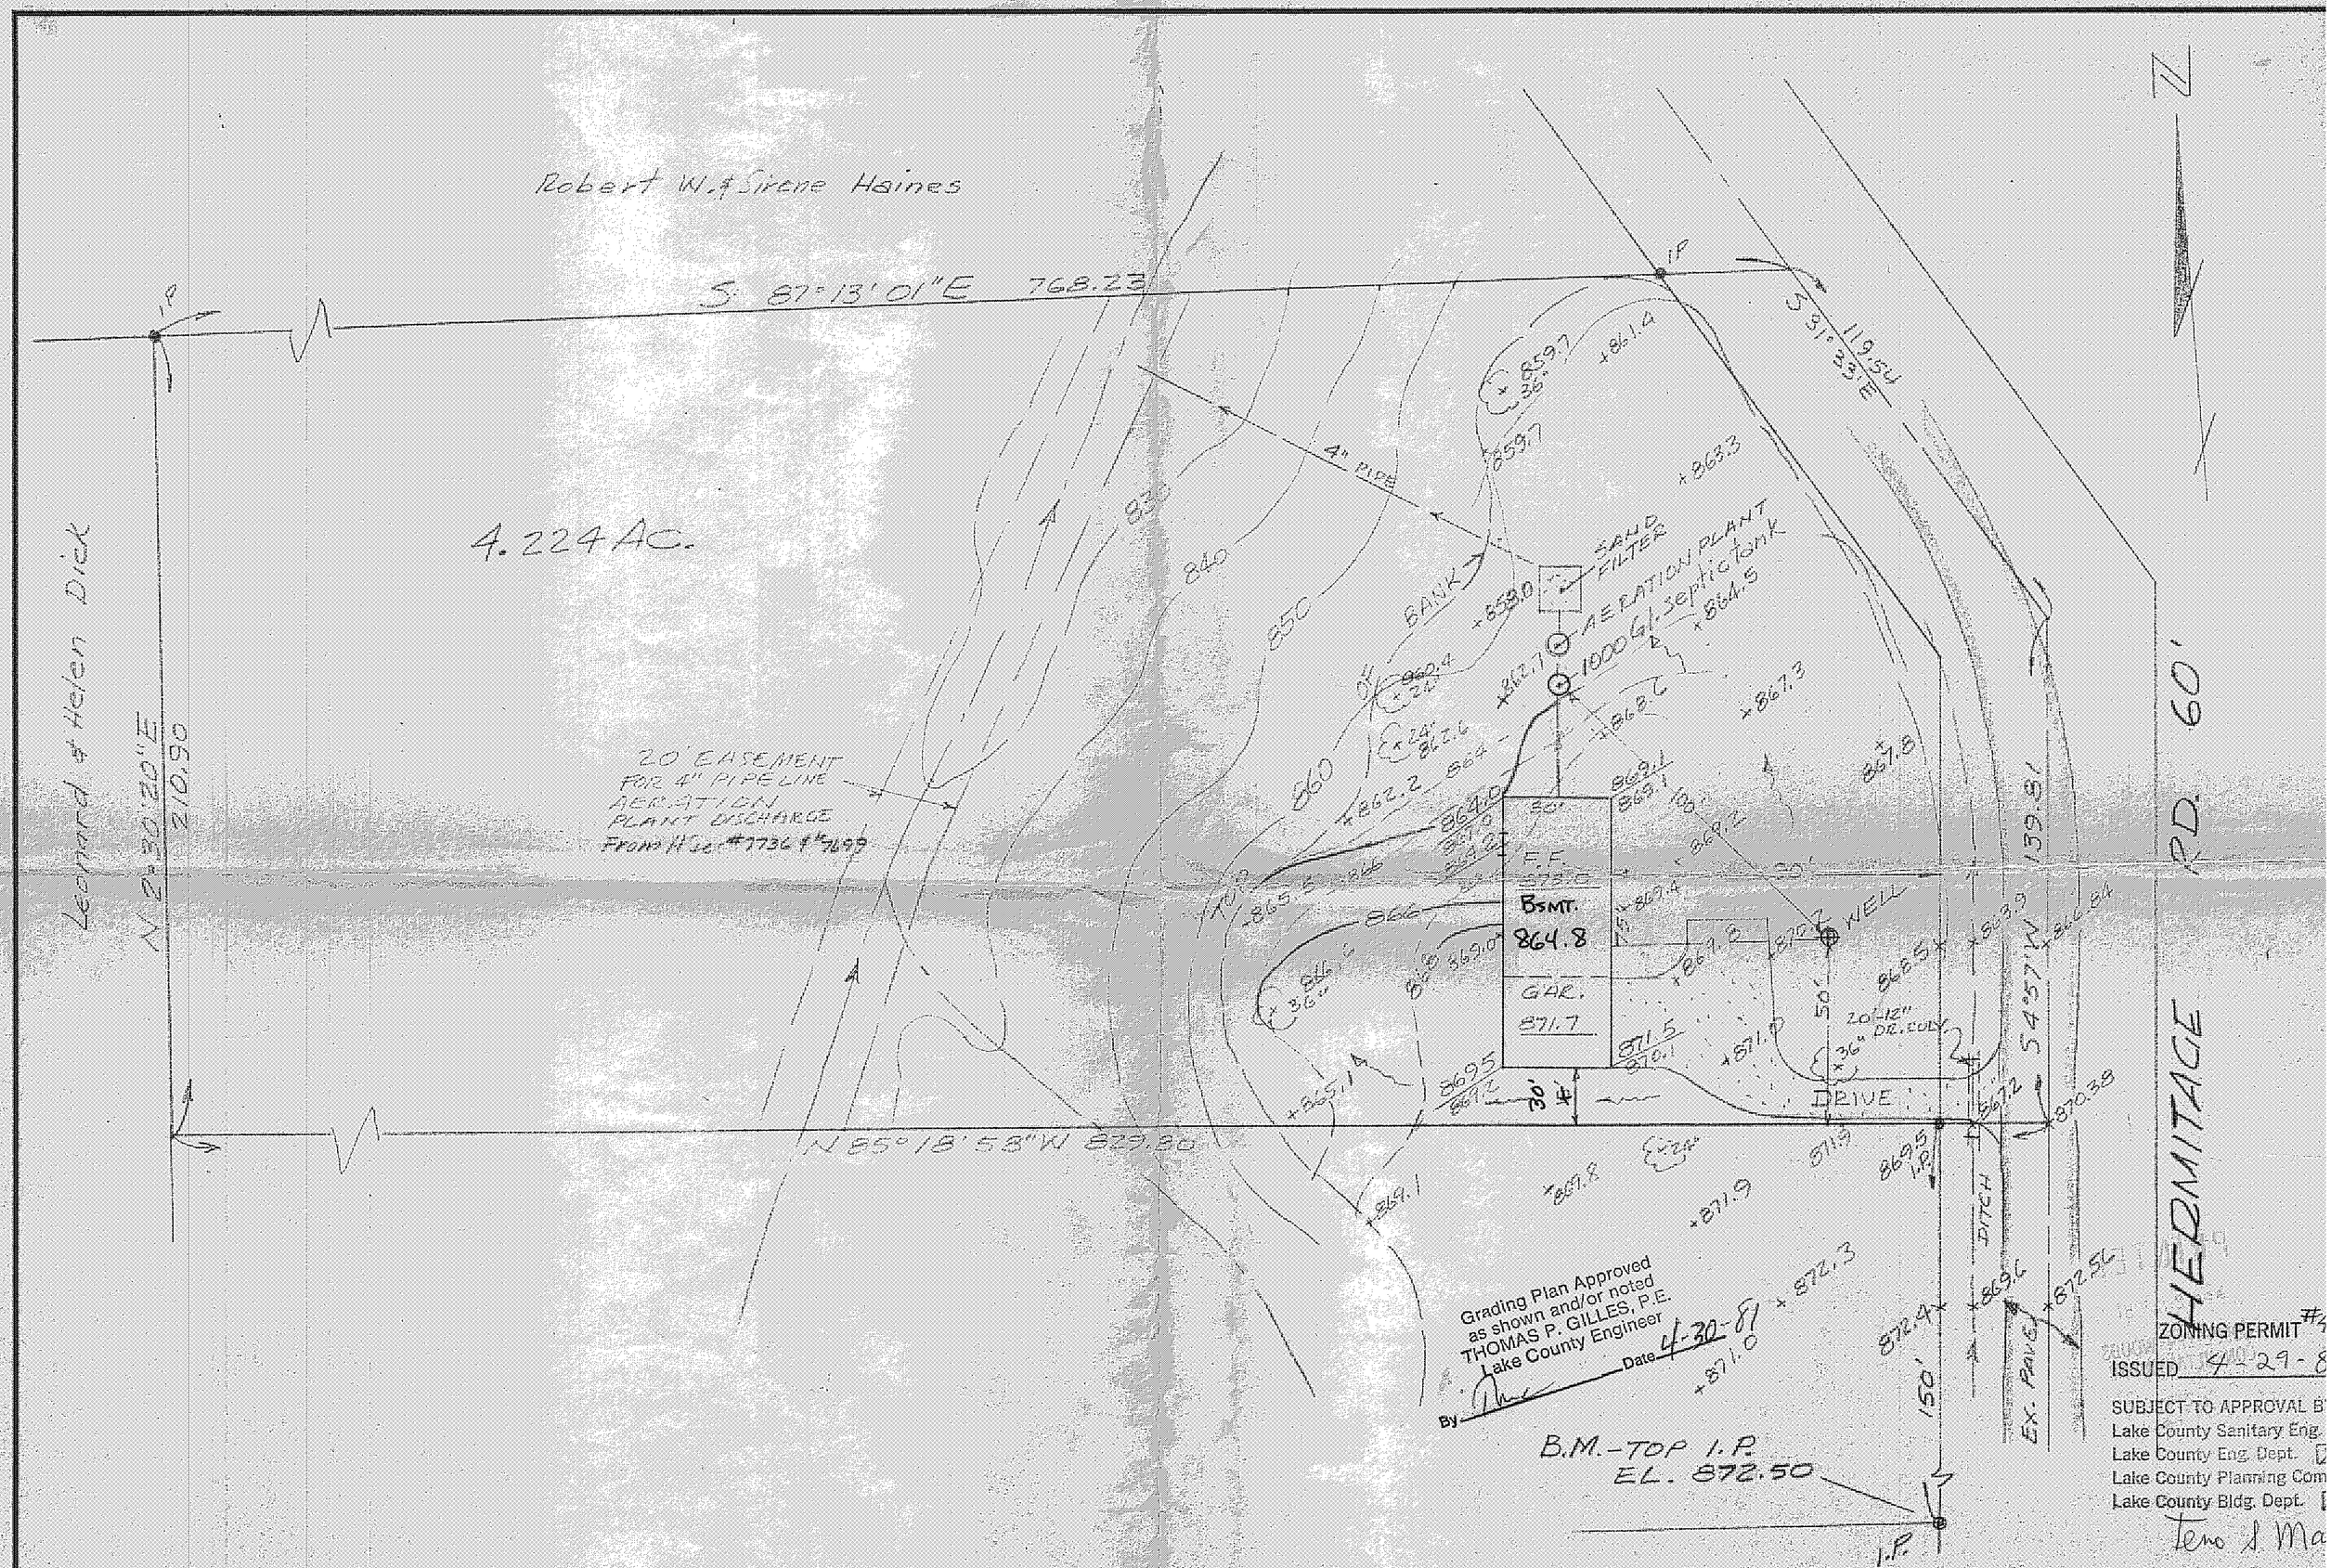

"DESIGN CERTIFICATION"

THIS PLAT WAS PREPARED BY ME AND IS CORRECT TO THE BEST OF MY KNOWLEDGE AND BELIEF.

REG. SURVEYOR #4785

"AS BUILT CERTIFICATION"

I HEREBY CERTIFY THAT THE CIRCLED GRADES ARE EXISTING FINISH GRADES CHECKED IN FIELD ON _____ AND THAT SURVEY IS CORRECT TO THE BEST OF MY KNOWLEDGE AND BELIEF

REG. SURVEYOR

NOTE: UNDERLINED EL. ARE PROPOSED FINISH GRADES

SITE PLAN for JOSEPH K. CYVAS

PT. LOT 17, TR. 4 CONCORD TWP - LAKE COUNTY, OHI

DATE 7-23-76
SCALE 1" = 30'
DRAWN BY
CH'K'D BY
F.B.# PG.

Colpetzer • Woods Consultants, Inc.
CONSULTING ENGINEERS AND SURVEYORS
PAINESVILLE, OHIO 44077 #76063

SHEET 1
CONTRACT