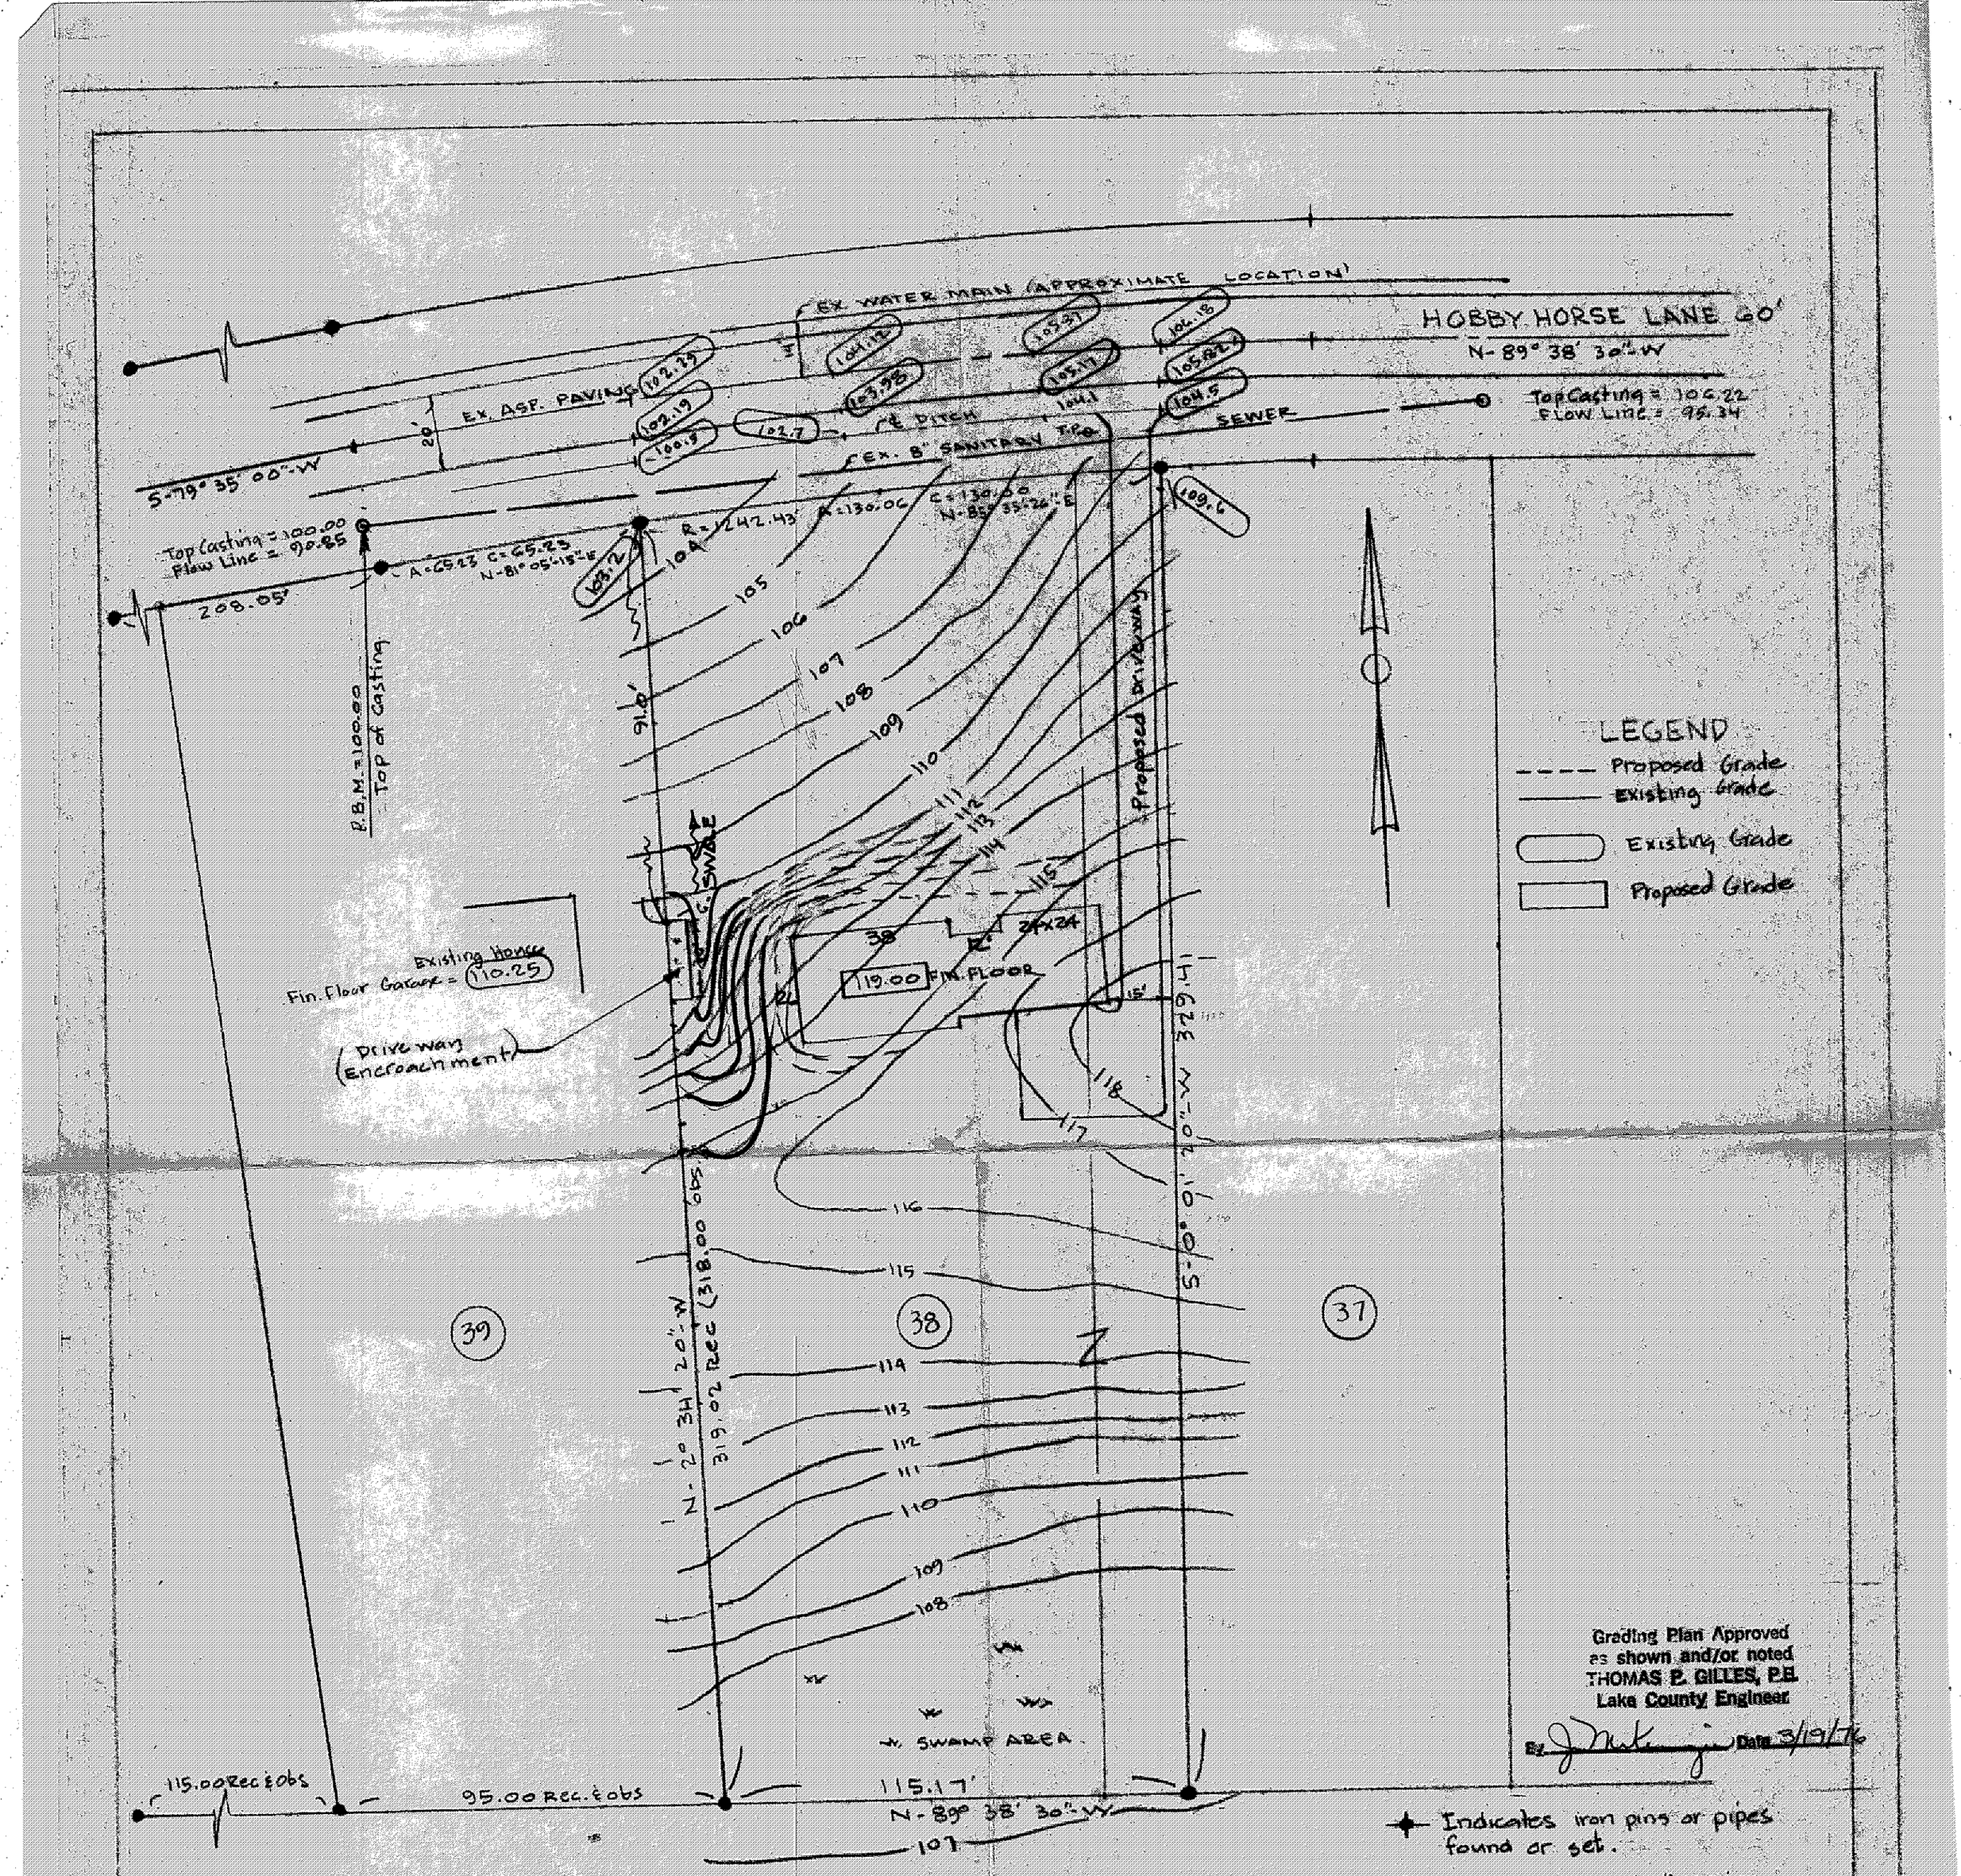

Grading Plan Approved as shown and/or noted
THOMAS P. GILLES, P.E.
Lake County Engineer
By _____ Date 3/19/76

✚ Indicates iron pins or pipes found or set.

Note: No storm sewers in subidivision.

MAP OF SURVEY & PROPOSED BUILDING LOCATION for ROY SLAYTON

MARCH-1976 Scale 1" = 30

Property being a part of sub-lot No 37 and all of sub-lot No 38 in the Hobby Horse Farms Subdivision recorded in Vol. "M" Page 104 in the Lake County Record of Plats.

Harold E Pluckys
Registered Surveyor No 5394 - Solon, Ohio

ZONING PERMIT
Approved _____
3-17-76 #2953
(CONCORD)