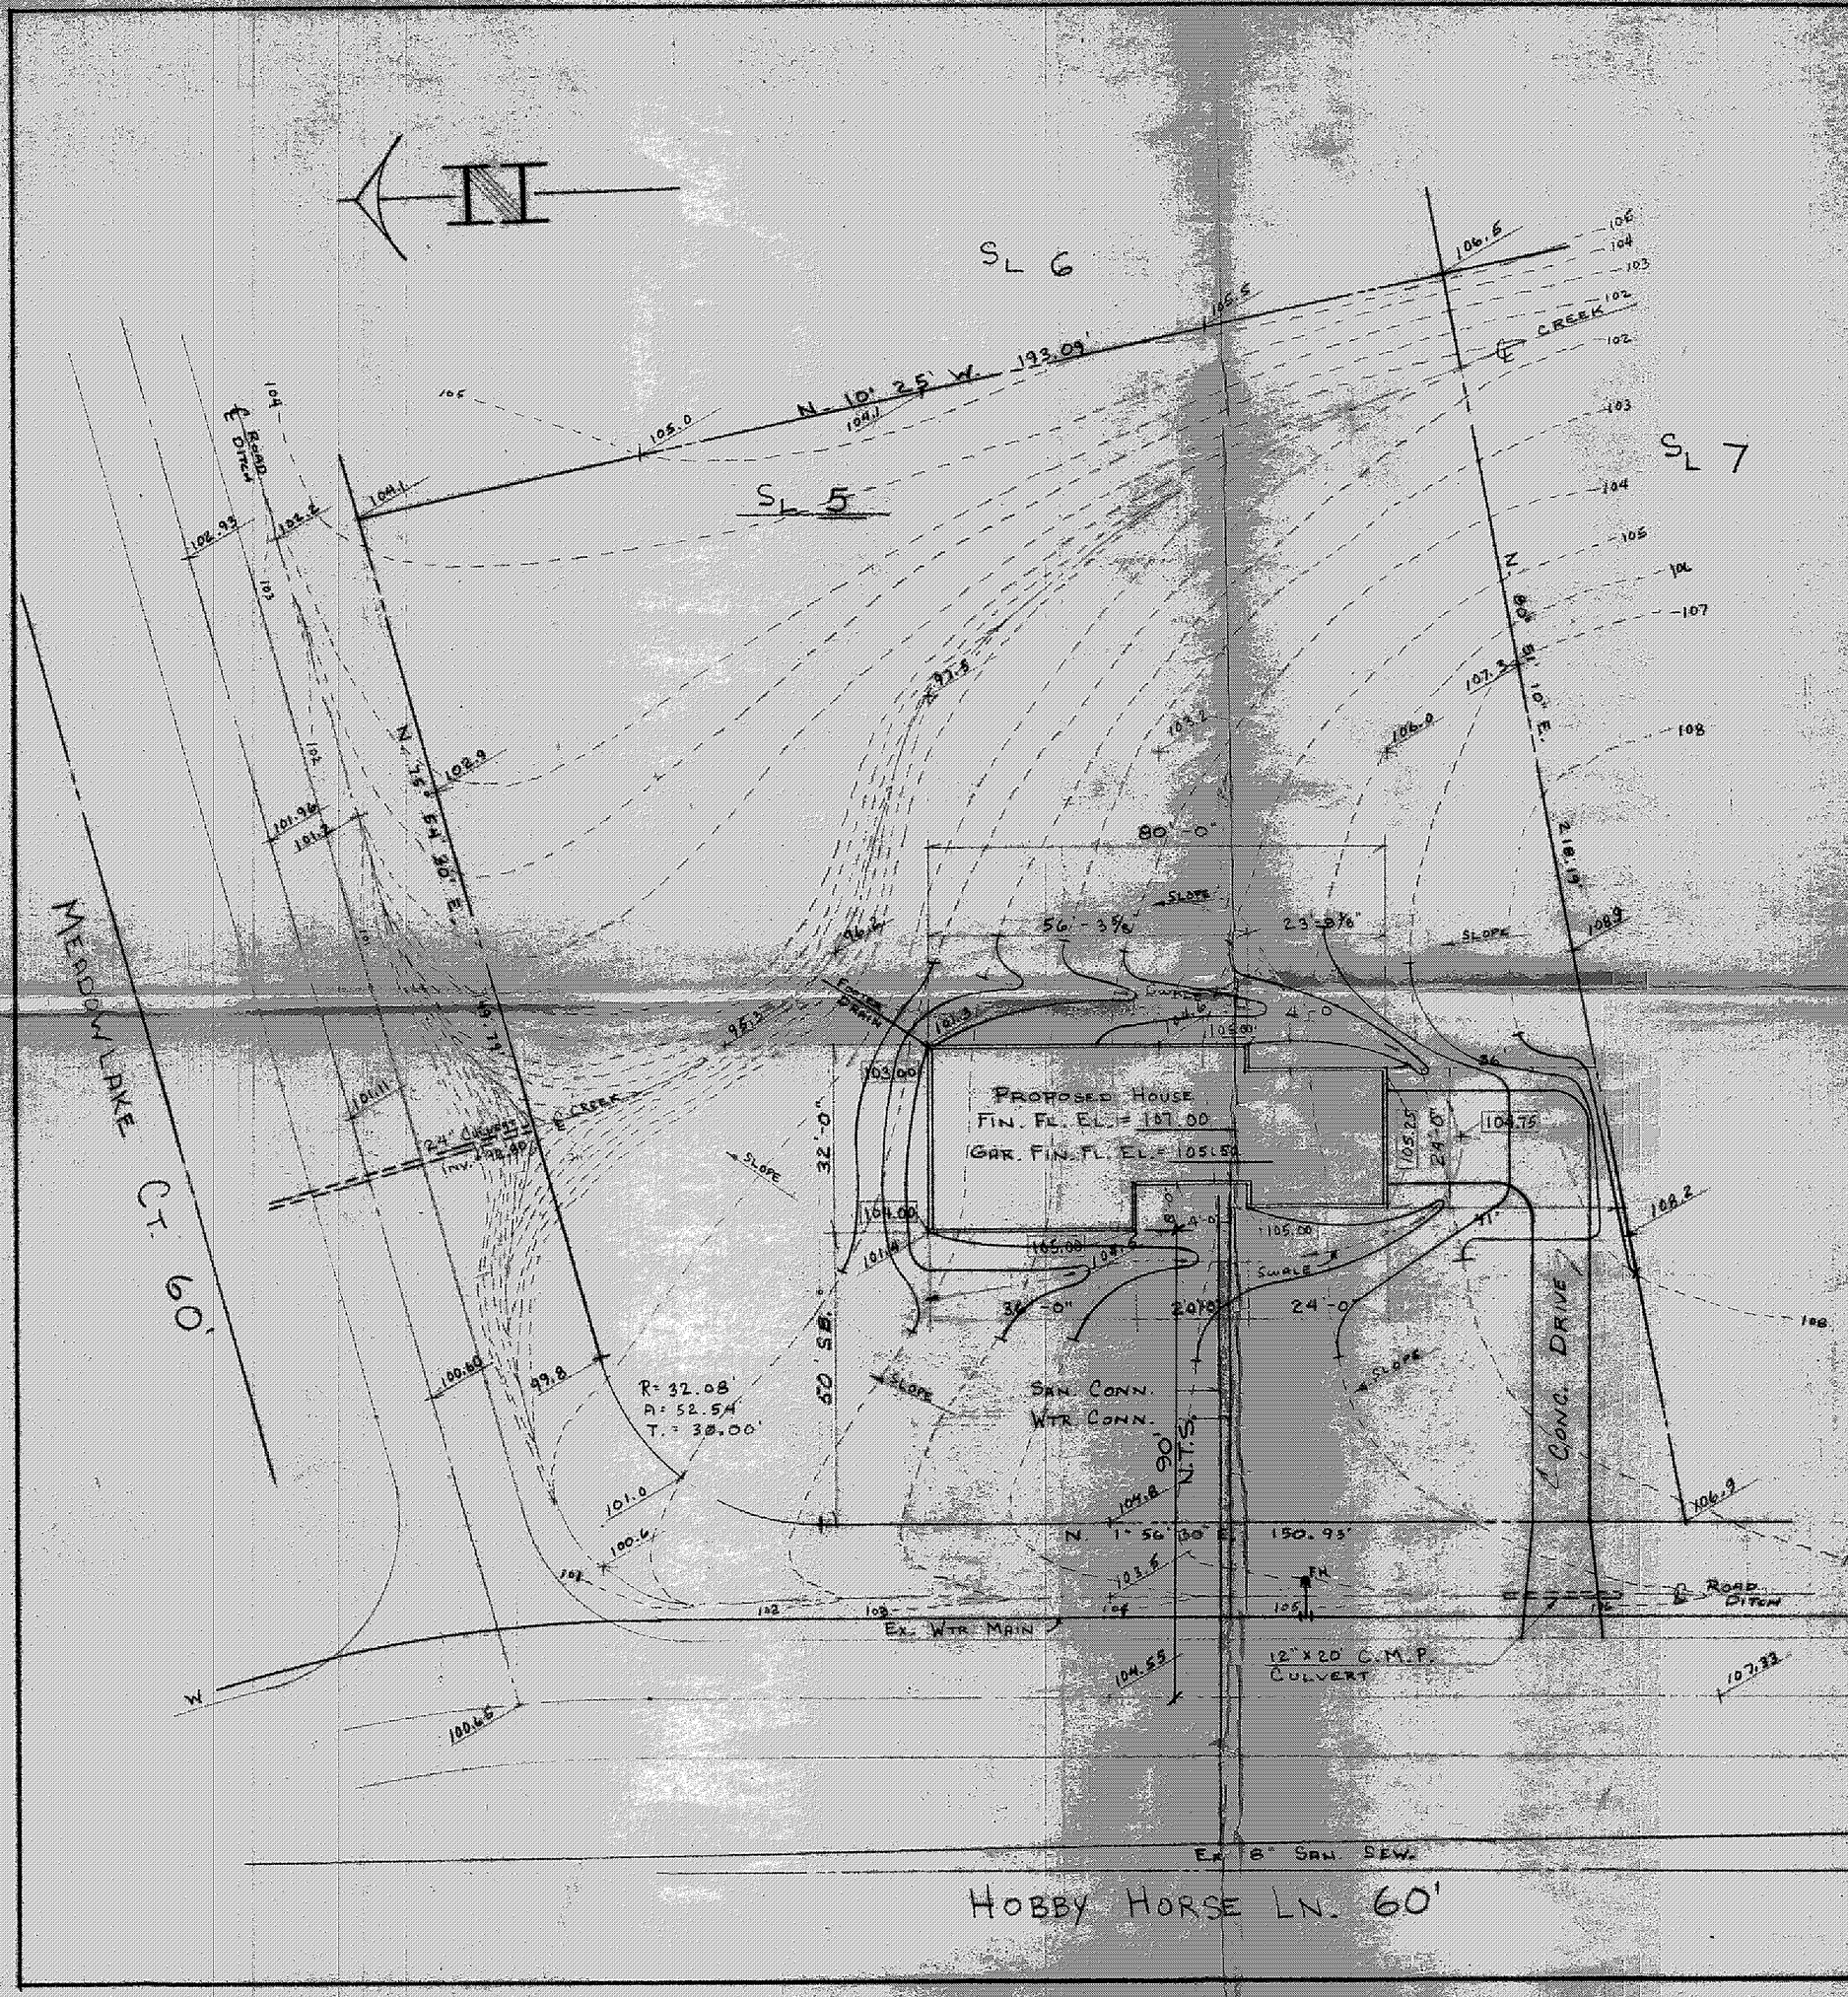

SITE PLAN FOR:

TOM RICHARDS
6158 PEPPERWOOD DR.
MENTOR, OHIO

BEING SL. #5 IN THE HOBBY HORSE FARMS SUBD. #4 IN CONCORD TWP., OHIO.

PREPARED BY:

WM. R. GRAY ASSOC. INC.
7547 MENTOR AVE.
MENTOR, OHIO
DATE: JULY 19, 1976 SCALE: 1" = 20'

CERTIFICATION:

I HEREBY CERTIFY THAT THIS PLAT IS CORRECT TO THE BEST OF MY KNOWLEDGE.

BY: Wm. R. Gray
WM. R. GRAY R.S. # 2752

STATE OF OHIO
WM. R. GRAY
2752
REGISTERED PROFESSIONAL SURVEYOR

Grading Plan Approved as shown and/or noted
THOMAS P. GILLES, P.E.
Lake County Engineer
By [illegible] Date 8/2

ZONING PER
#30