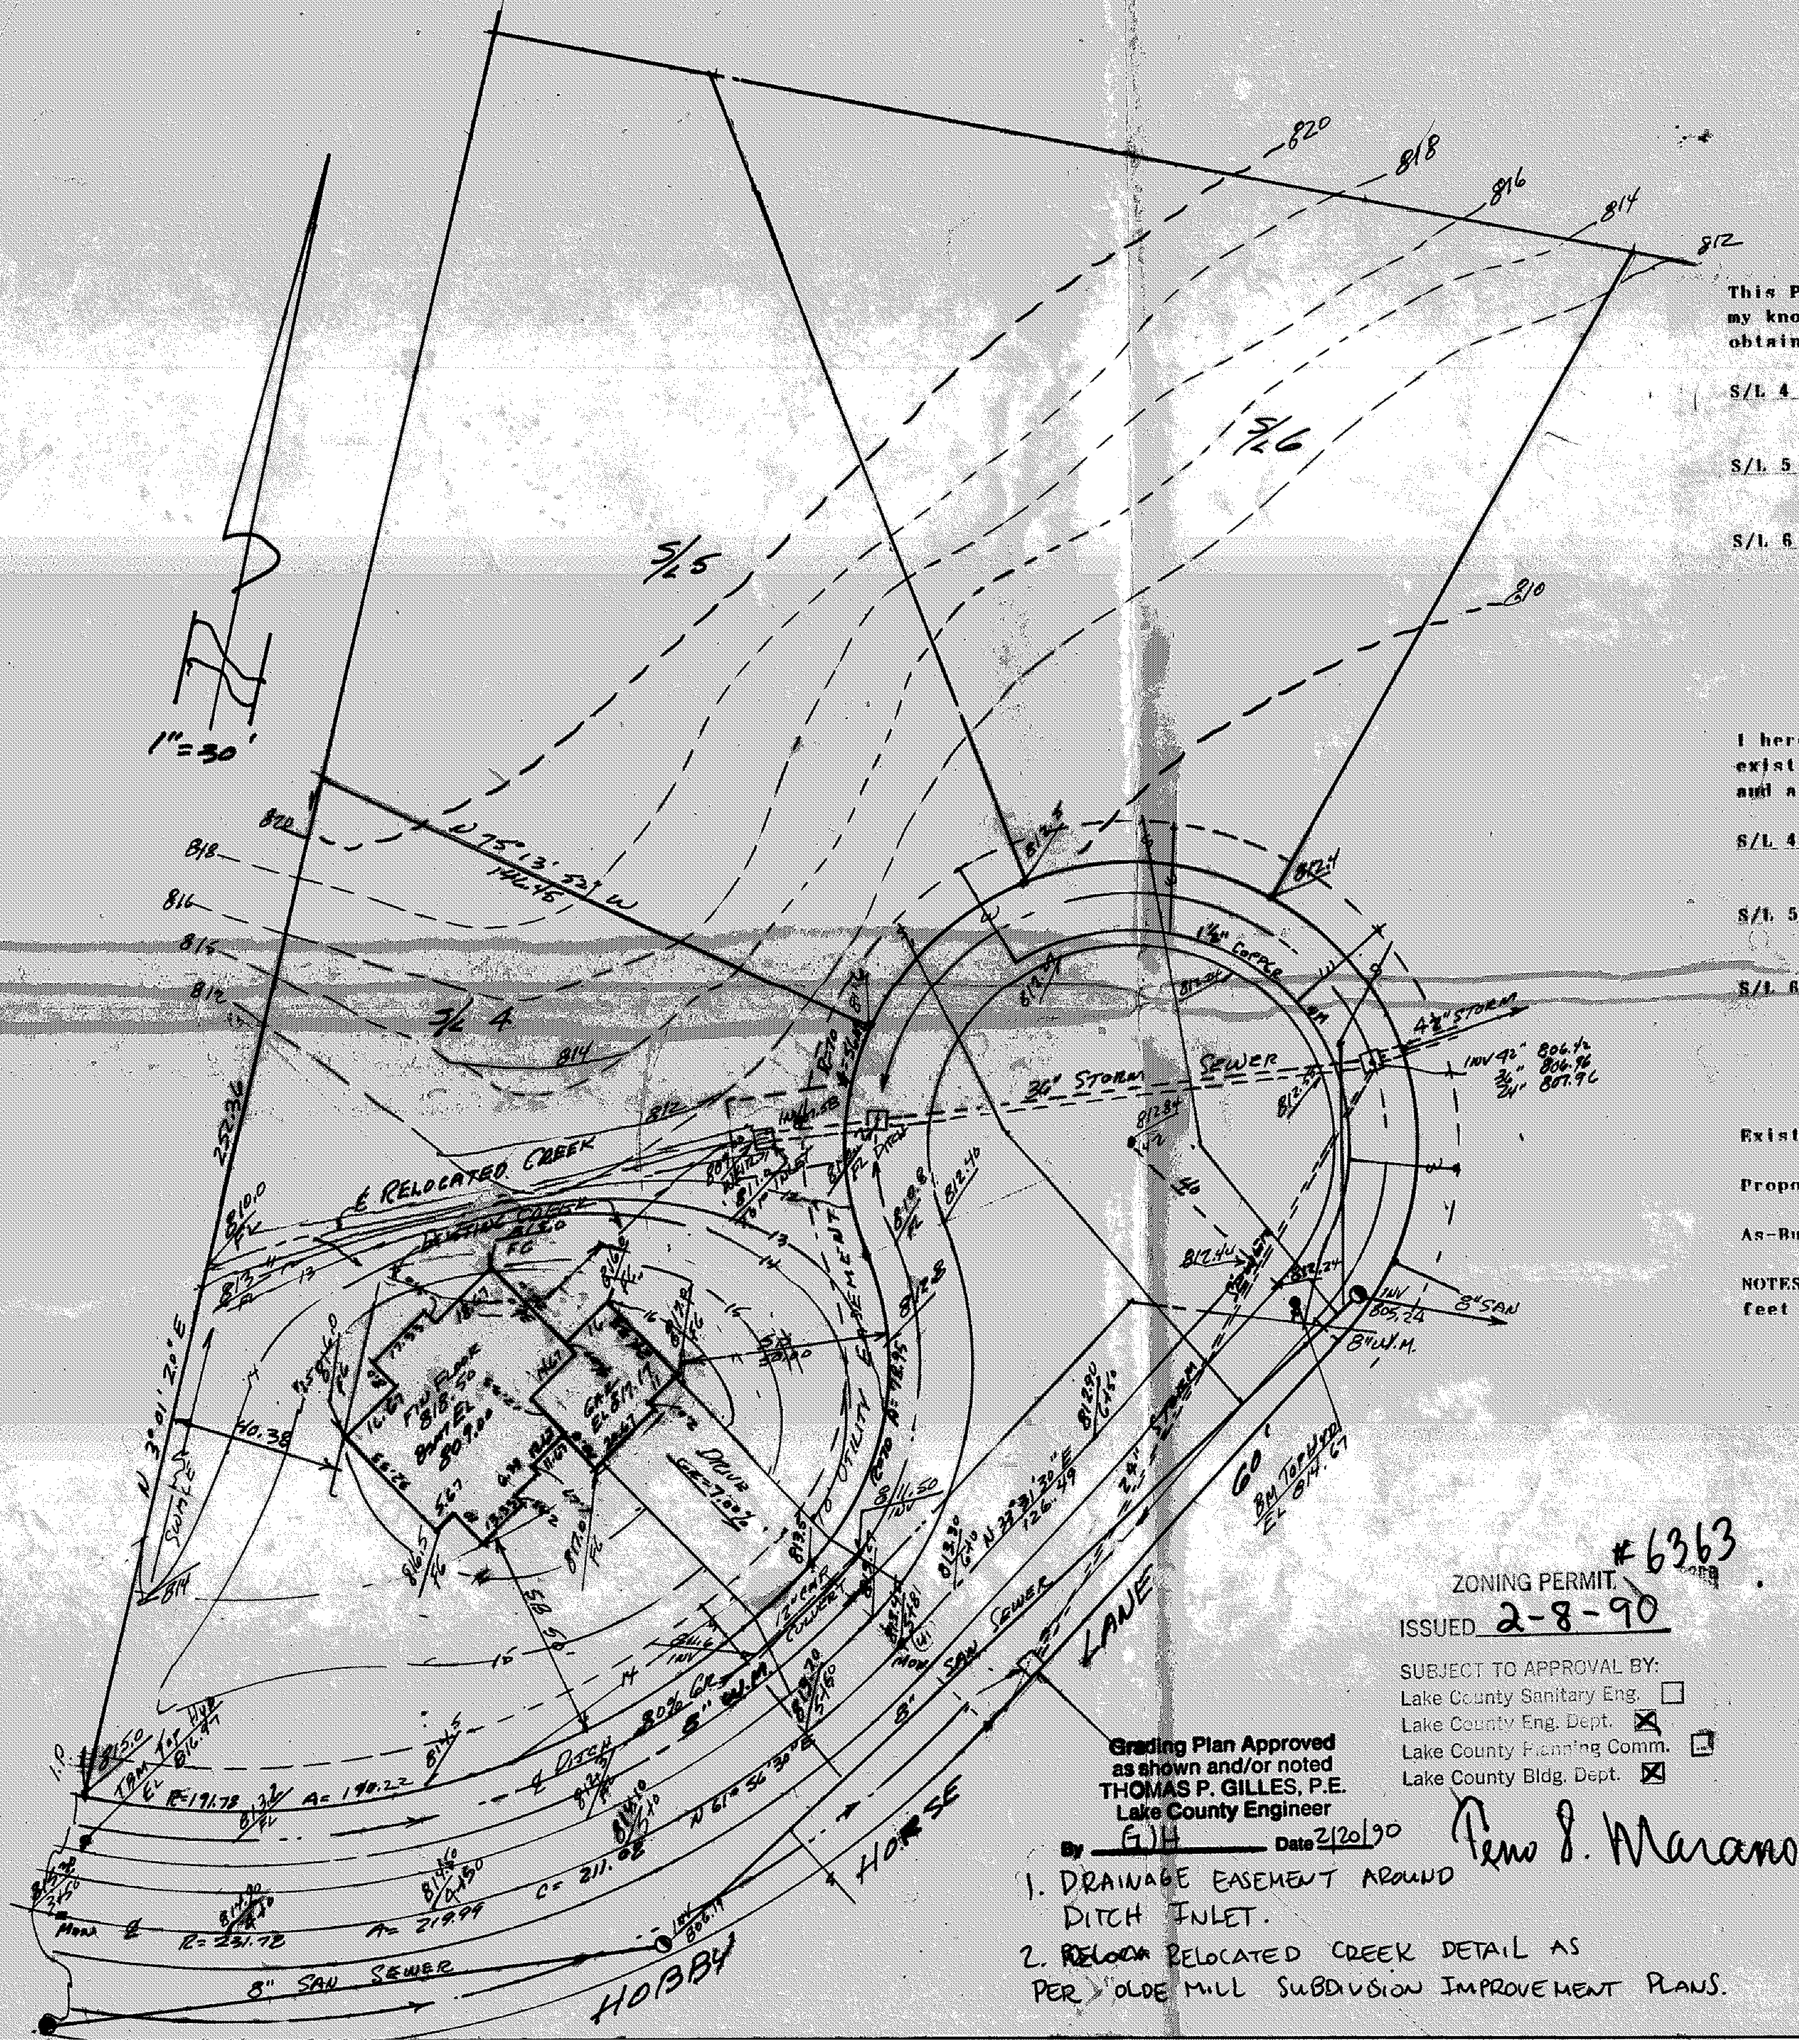

DESIGN CERTIFICATION

This Plat was prepared by me, and is correct to the best of my knowledge and belief. All boundary data shown hereon was obtained from public records.

S/L 4 Edward L Aitkever 4514 2/5/90
Registered Surveyor's Signature Reg. No. Date

S/L 5 ____________________
Registered Surveyor's Signature Reg. No. Date

S/L 6 ____________________
Registered Surveyor's Signature Reg. No. Date

"AS BUILT" CERTIFICATION

I hereby certify that the circled grades shown hereon are existing finished grades checked in the field on date shown and are correct to the best of my knowledge and belief.

S/L 4 ____________________
Registered Surveyor's Signature Reg. No. Date

S/L 5 ____________________
Registered Surveyor's Signature Reg. No. Date

S/L 6 ____________________
Registered Surveyor's Signature Reg. No. Date

LEGEND

Existing Elevation:	Existing Contour:
Proposed Elevation:	Proposed Contour:
As-Built Elevation:	

NOTES: Set Driveway culvert 15" below edge of pavement, 24 feet off centerline. Use 12" CMP, 12 gauge culvert pipe.

SITE PLAN

For Ray Zirkle
5865 Shore Drive, PO Box 25
Madison, Ohio 44057
Phone (216) 428-2058

Of Sublot Nos 4,5,& 6
OLDE MILL SUBDIVISION
Concord Township,
Lake County, Ohio

Prepared By:

Debevec-Salo & Associates, Inc.
860 Bryn Mawr Avenue
Wickliffe, Ohio 44092
Phone (216) 944-2589

Scale: 1"=30'

February 1990

ZONING PERMIT #6363
ISSUED 2-8-90

SUBJECT TO APPROVAL BY:
Lake County Sanitary Eng. ☐
Lake County Eng. Dept. ☒
Lake County Planning Comm. ☐
Lake County Bldg. Dept. ☒

Pero 8. Marano

Grading Plan Approved as shown and/or noted THOMAS P. GILLES, P.E. Lake County Engineer
By GJH Date 2/20/90

1. DRAINAGE EASEMENT AROUND DITCH INLET.
2. ~~RELOCA~~ RELOCATED CREEK DETAIL AS PER OLDE MILL SUBDIVISION IMPROVEMENT PLANS.

860089-4