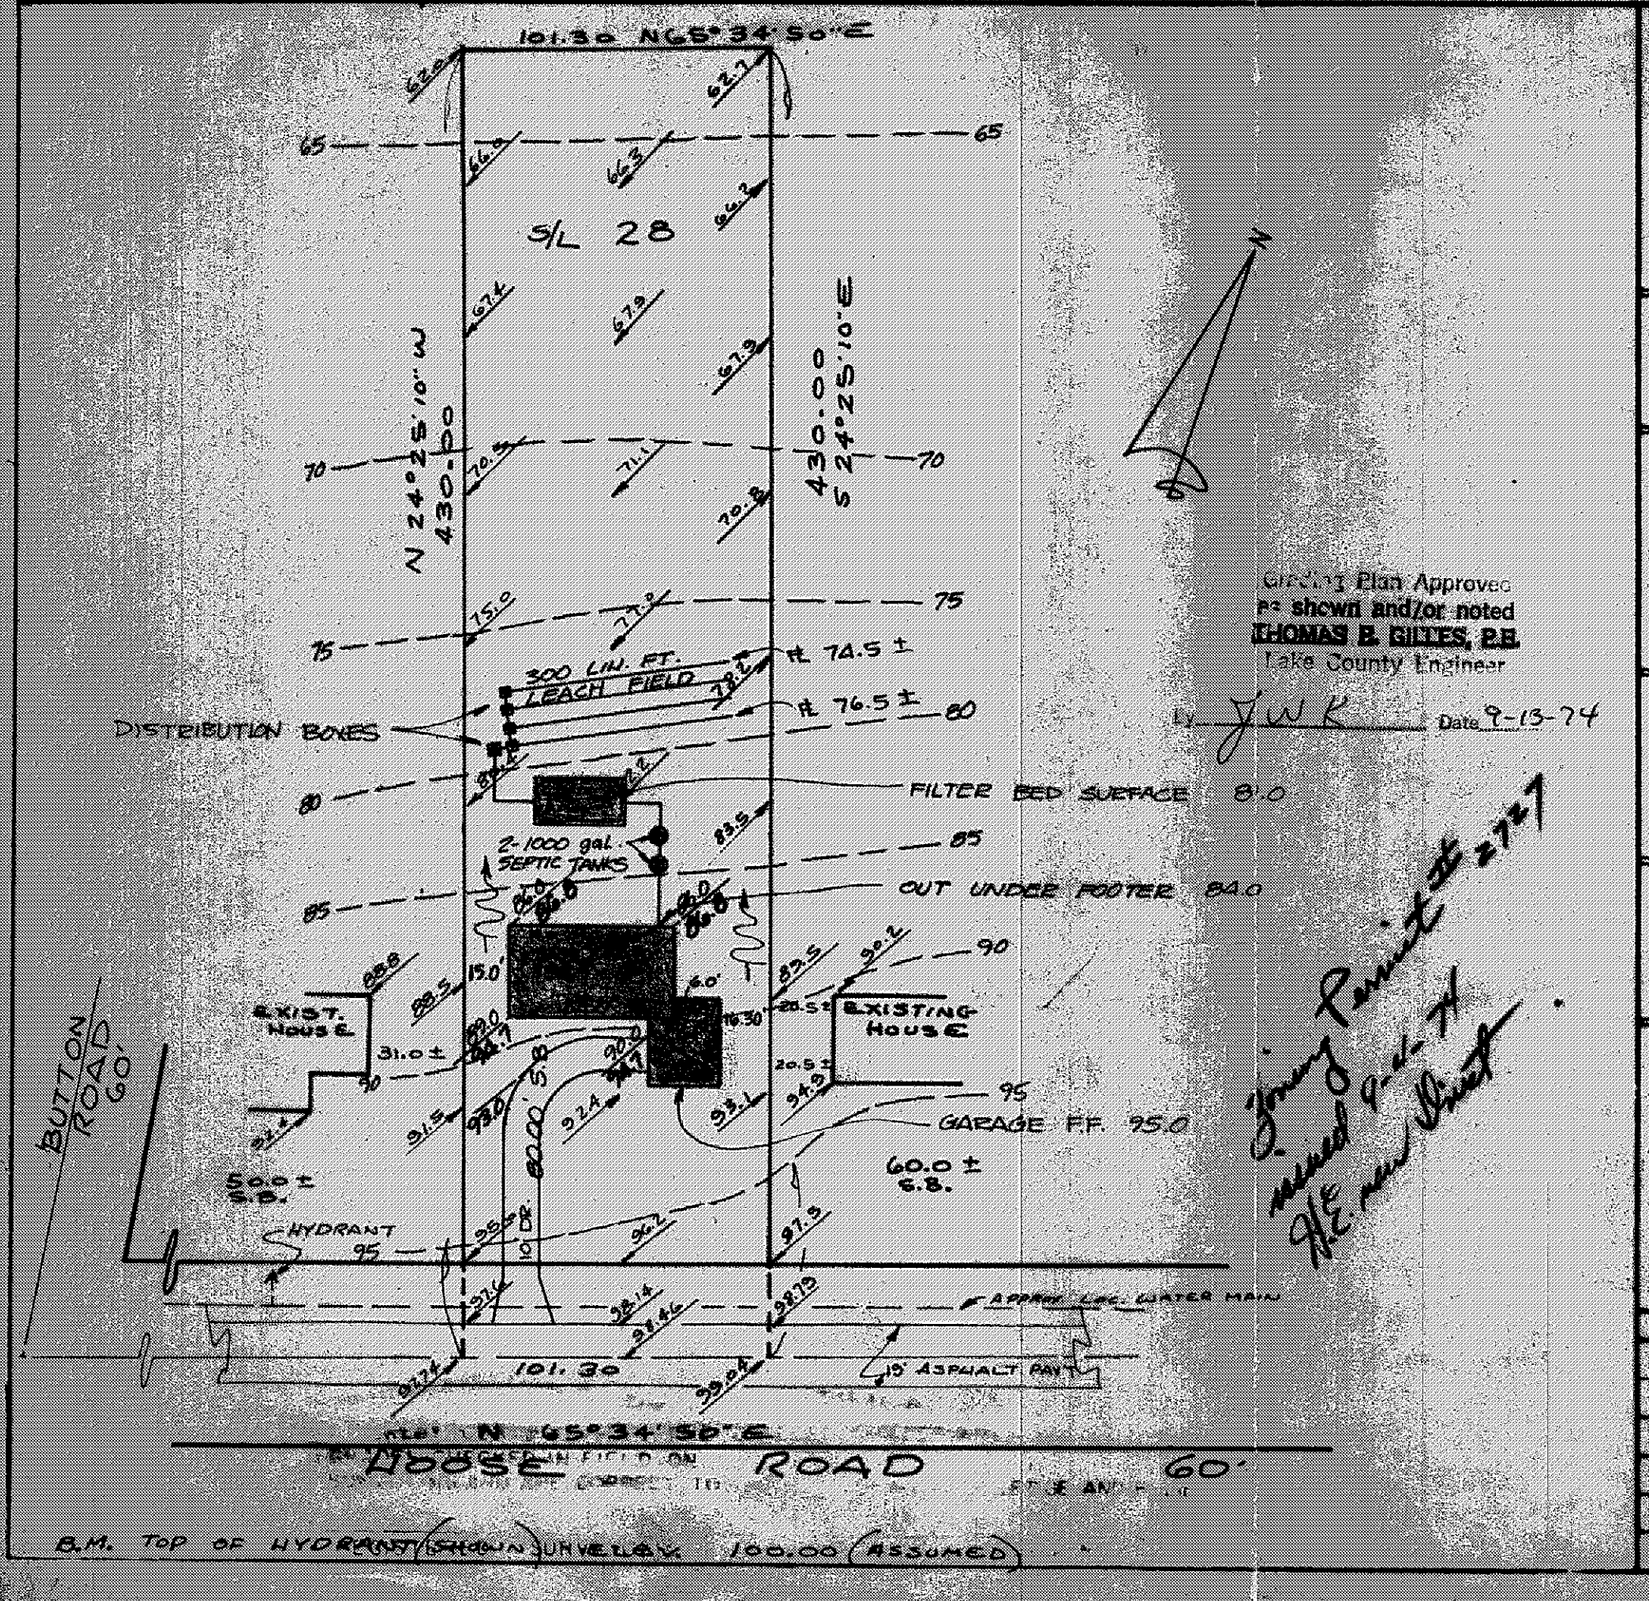

Grading Plan Approved
as shown and/or noted
THOMAS B. GILTES, P.E.
Lake County Engineer
By JWK Date 9-13-74

Zoning Permit #27-74
issued 9-24-74
NE corner Lot

SITE PLAN

CONCORD TOWNSHIP LAKE COUNTY, OHIO

for: EDWARD & NORMA GALASKA
CLIENT OWNER

ADDRESS STREET CITY ZIP

HOBBY HORSE FARMS SUBDIVISION NAME
K-11 VOL - PG
28 SUBLOT NO
HOOSE ROAD STREET

LOT TRACT
VOLUME PAGE
BENCH MARK # STREET

LEGEND

SANITARY MANHOLE
STORM MANHOLE
INLET OR CATCH BASIN
HYDRANT
EXISTING CONTOURS
PROPOSED CONTOURS
EXIST ELEV ±100.0
100.0 PROP ELEV

WATER VALVE (GAS)
WATER METER (GAS)
AS BUILT ELEVATION
INDICATES DIRECTION OF SURFACE DRAINAGE

REMARKS

ALL BOUNDARY DATA SHOWN WAS OBTAINED FROM DEEDS RECORDED SUBDIVISION PLAT OR OTHER PUBLIC RECORDS.

DESIGN CERTIFICATION

THIS PLAT WAS PREPARED BY ME, AND IS CORRECT TO THE BEST OF MY KNOWLEDGE AND BELIEF

NAME SURVEYOR REGISTRATION NO PS # 5244

CHECK LIST

DIMENSIONS
BEARINGS
TIE TO NEAREST STREET
SUBLOT NO PARCEL NO
SURROUNDING OWNERS
BLDG DIMENSIONS FIN GR
BLDG TIES FLR GRADES
APRON TYPE WIDTH THICKNESS
SIDEWALK TYPE WIDTH THICKNESS
CULVERT TYPE DIA LENGTH

WATER MAIN SIZE LOCATION
SAN SEWER SIZE % GR LOC
SAN MH CAST ELEV INV ELEV
SAN CONN SIZE LOC DEPTH
STORM SEWER SIZE % GR LOC
STORM MH CAST ELEV INV ELEV
PAVT TYPE GRADE CURBS
GAS LINE LOC SIZE PRESSURE
SEPTIC TANK SIZE LOC
WELL LOCATION

REVISIONS		
NO	DATE	BY
1	8-10-74	RJB
2		
3		
4		
5		

PLAN PREPARED BY:
DEBEVEC SALO & ASSOC., INC.
NAME
130 EAST JACKSON ST. PAINESVILLE
ADDRESS

DRAWN BY RJB	SCALE 1" = 50	PHONE NO
CHK'D	DATE MAY 21, 74	DRAWING NO 3940-28
CREW CHIEF	APP'D	