SITE PLAN

CONCORD TOWNSHIP, LAKE COUNTY, OHIO

for: RYAN HOMES CLIENT / OWNER

ADDRESS STREET CITY ZIP

CONCORD HILLS # 3 SUBDIVISION NAME		LOT	TRACT
1169 VOL. PG.	HOOSE STREET	VOLUME	PAGE
SUBLOT NO.		PERM. PARCEL NO.	STREET

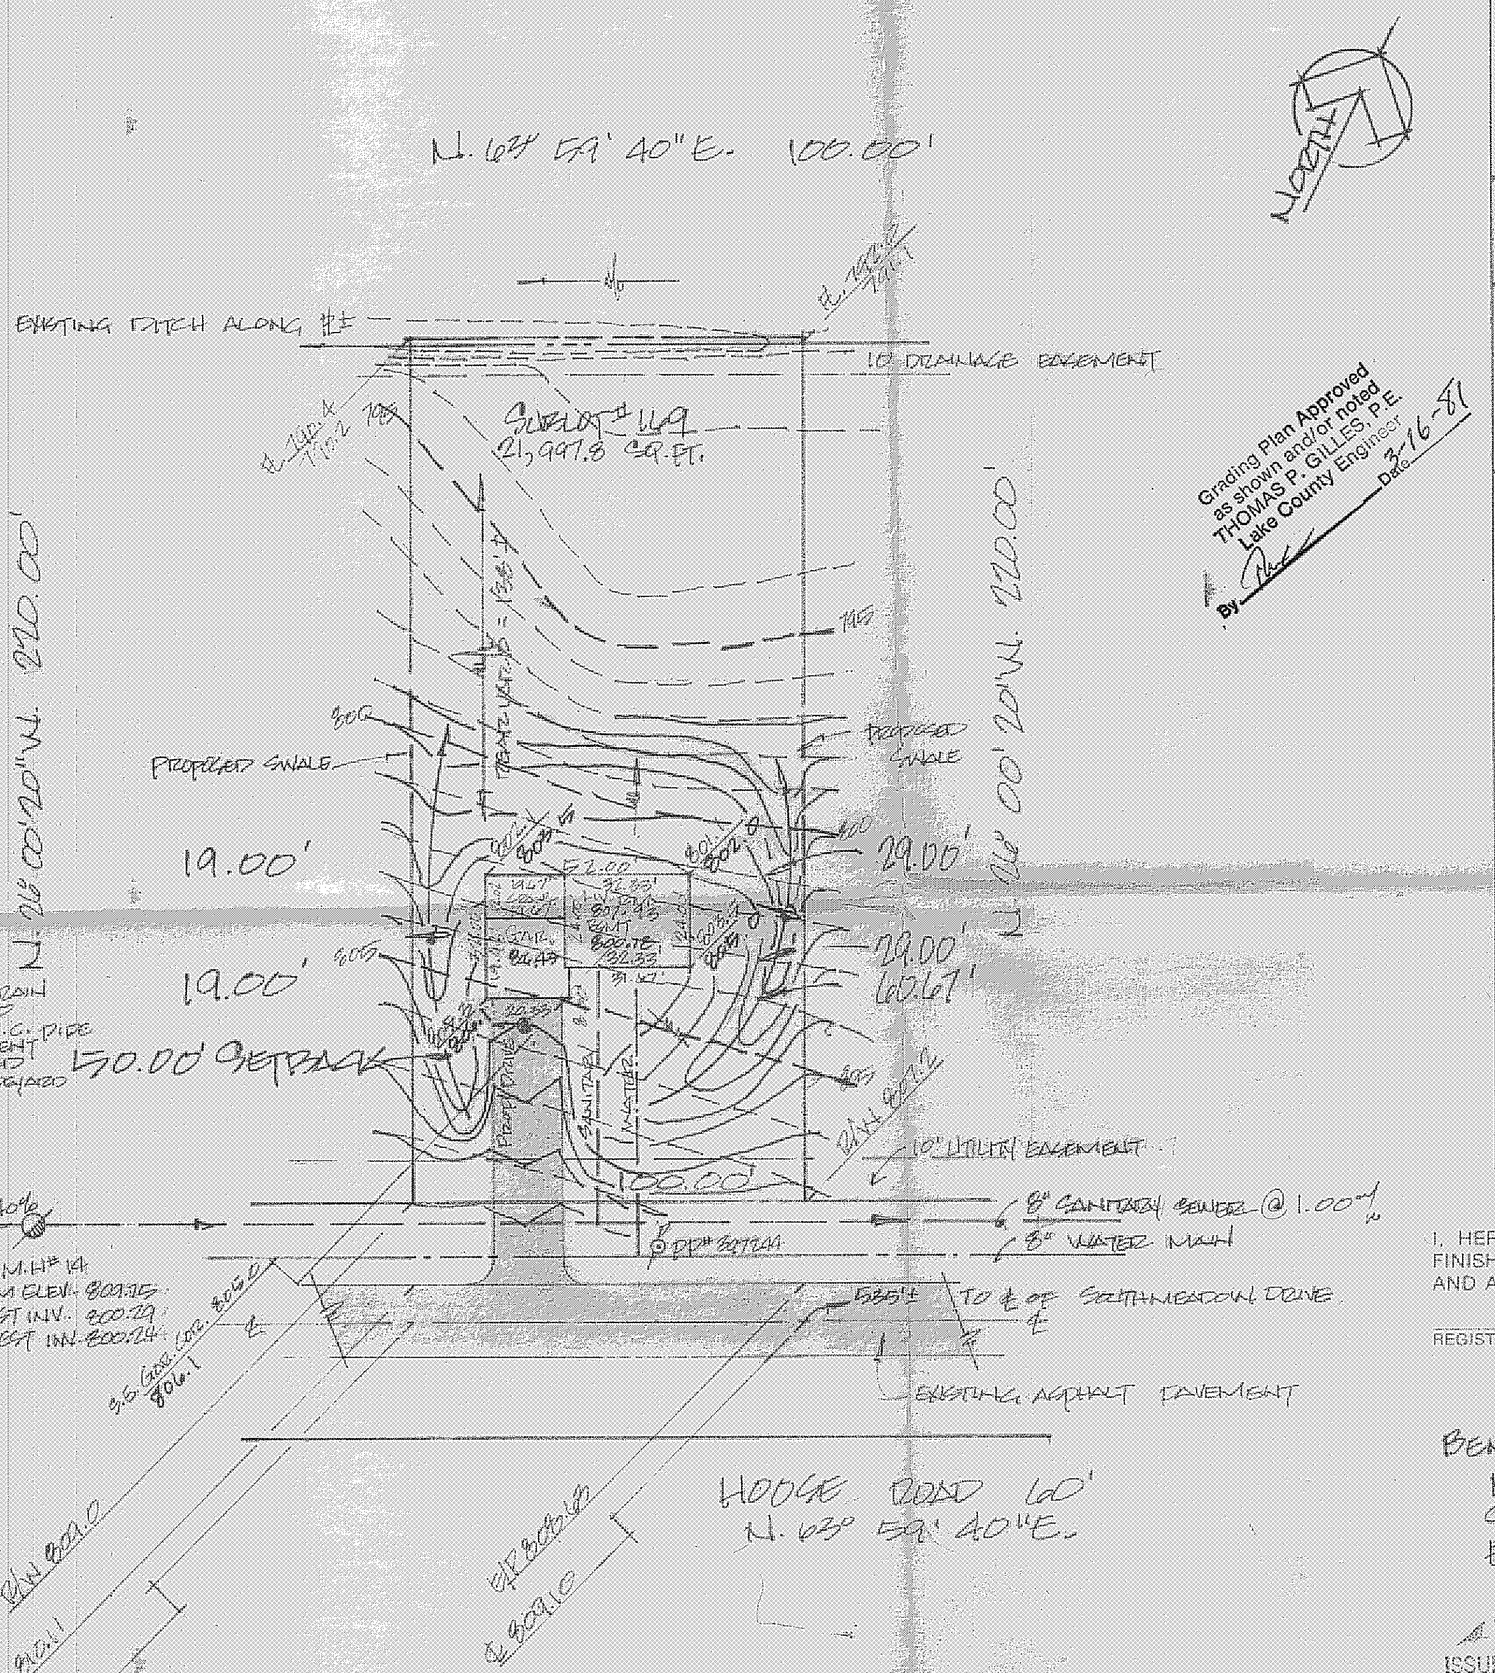

Grading Plan Approved as shown and/or noted
THOMAS P. GILLES, P.E.
Lake County Engineer
By _____ Date 3-16-81

LEGEND

SANITARY MANHOLE		WATER VALVE (GAS)	
STORM MANHOLE		WATER METER (GAS)	
INLET OR CATCH BASIN		AS BUILT ELEVATION	100.0
HYDRANT		INDICATES DIRECTION OF SURFACE DRAINAGE	
EXISTING CONTOURS			
PROPOSED CONTOURS			
EXIST. ELEV. 100.0 / PROP. ELEV. 100.0			

REMARKS

ALL BOUNDARY DATA SHOWN WAS OBTAINED FROM (DEEDS, RECORDED SUBDIVISION PLAT OR OTHER PUBLIC RECORDS)

LOCATIONS AS SHOWN OF ADJACENT WELLS AND SEPTIC TANKS OBTAINED FROM LAKE COUNTY HEALTH DEPARTMENT

DESIGN CERTIFICATION

THIS PLAT WAS PREPARED BY ME, AND IS CORRECT TO THE BEST OF MY KNOWLEDGE AND BELIEF.

Gary Kern — 5671

NAME SURVEYOR REGISTRATION NO.

CHECK LIST

NO. OF BEDROOMS
DIMENSIONS
BEARINGS
TIE TO NEAREST STREET
SUBLOT NO. PARCEL NO.
SURROUNDING OWNERS
BLDG. DIMENSIONS FIN. GR.
BLDG. TIES F.F.R. GRADES
APRON TYPE WIDTH THICKNESS
SIDEWALK TYPE WIDTH THICKNESS
CULVERT TYPE DIA., LENGTH
ROCK OUTCROPPINGS

WATER MAIN SIZE, LOCATION
SAN. SEWER SIZE % GR. LOC.
SAN. MH. CAST. ELEV. INV. ELEV.
SAN. CONN. SIZE, LOC. DEPTH
STORM SEWER SIZE % GR. LOC.
STORM MH. CAST ELEV. INV. ELEV.
PAVT. TYPE GRADE-CURBS
GAS LINE LOC. SIZE PRESSURE
SEPTIC TANK LOCATION & DUPLICATION AREA
WELL LOCATION
ISOLATION RADIUS FROM WELL

REVISIONS			PLAN PREPARED BY:		
NO.	DATE	BY	DEBEVEC • SALO & ASSOCIATES, INC.		
1			126 E. ERIE ST. PAINESVILLE, OHIO		
2			DRAWN BY: KELLY	SCALE: 1" = 30'	PHONE NO. 352-9250
3			CHK'D. KELLY	DATE: 3/7/81	DRAWING NO. 4820-169
4			CREW CHIEF C.C.	APP'D. —A—	
5					

"AS BUILT" CERTIFICATION

I, HEREBY CERTIFY THAT THE CIRCLED GRADES ARE EXISTING FINISH GRADES CHECKED IN THE FIELD ON _____, 19____ AND ARE CORRECT TO THE BEST OF MY KNOWLEDGE AND BELIEF.

REGISTERED SURVEYOR REG. NO.

BENCHMARK - TOP OF SANITARY MANHOLE # 14 IN FRONT OF S/L # 1168.
ELEVATION - 809.75

ZONING PERMIT #4287

ISSUED 3-11-81

SUBJECT TO APPROVAL BY:

Lake County Sanitary Eng. ☐
Lake County Eng. Dept. ☒
Lake County Planning Comm. ☐
Lake County Bldg. Dept. ☒

MAR 9 1981

Tom J Marano 4820-169