NO OF UNITS PER BUILDING = 2 UNITS

TOTAL NO. OF UNITS = 10 UNITS.

SAN. SEW. LATERALS TO BE MAINTAINED BY HOMEOWNERS ASSOCIATION (SAN SEW ON SITE)

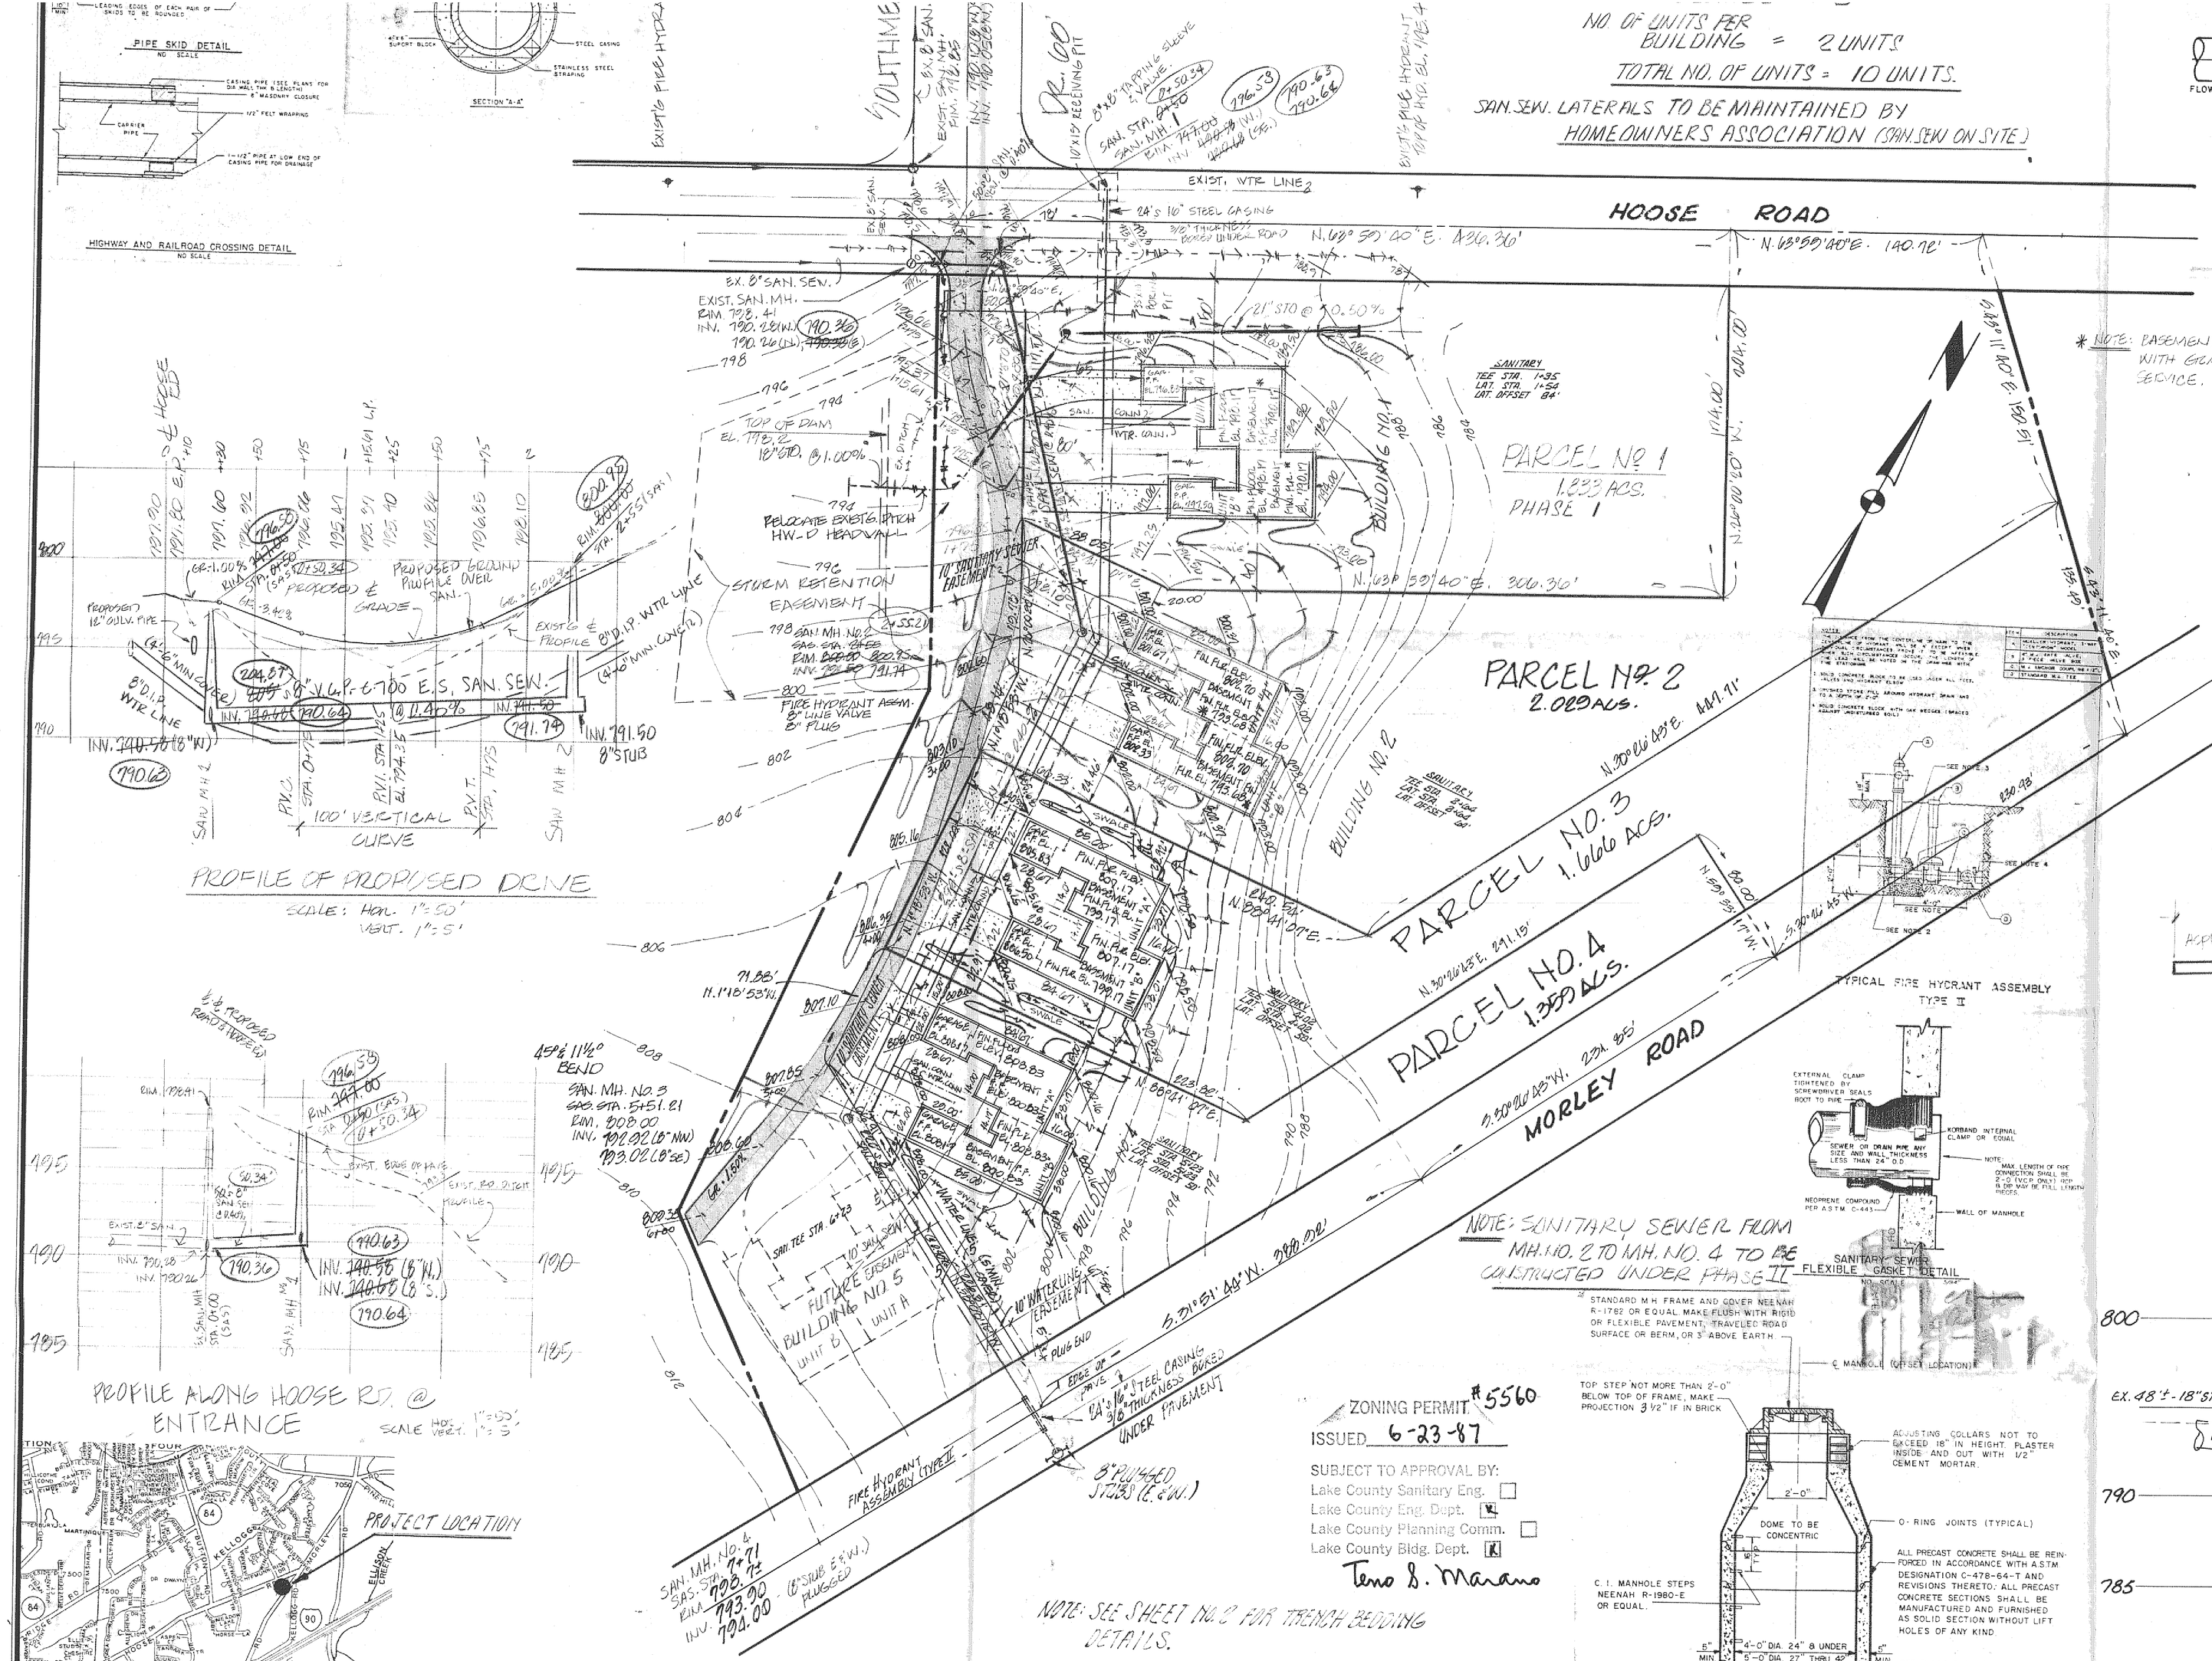

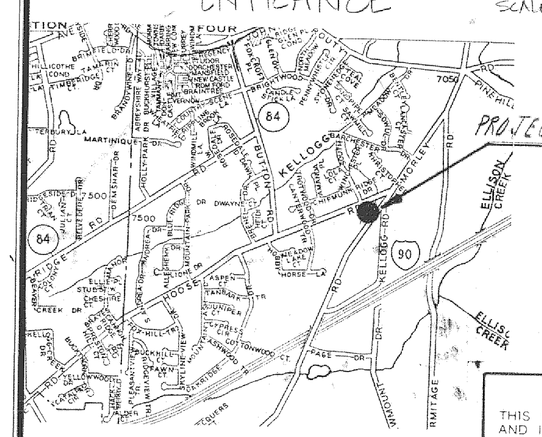

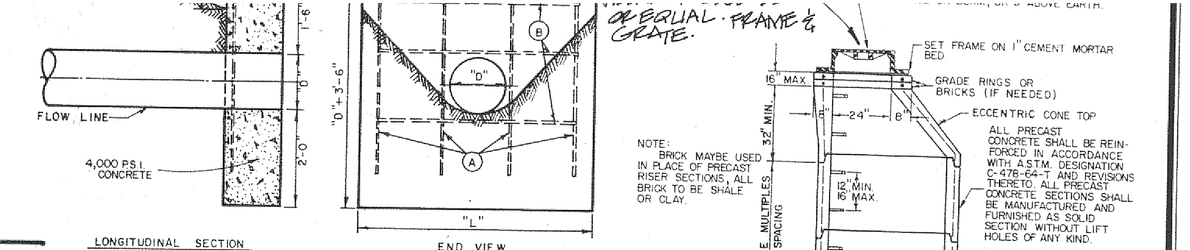

"D" DIAM. OF PIPE	"L" LENGTH OF HEADWALL	QUANTITIES IN ONE HEADWALL					
		A BARS		B BARS		STEEL	CONC.
		NO.	LENGTH	NO.	LENGTH	LBS.	C.Y.
21"	6'-9"	4	4'-9"	14	6'-3"	30	1.2

HW-D HEADWALL DETAIL
NO SCALE 7/94

* NOTE: EASEMENT CAN NOT BE SERVED WITH GRAVITY FLOW SANITARY SEWER.

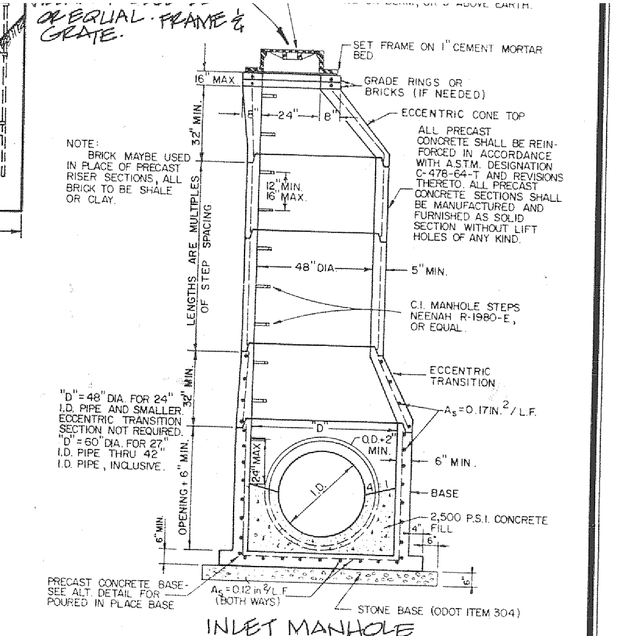

INLET MANHOLE
STANDARD PRECAST STORM MANHOLE
NO SCALE 3/94

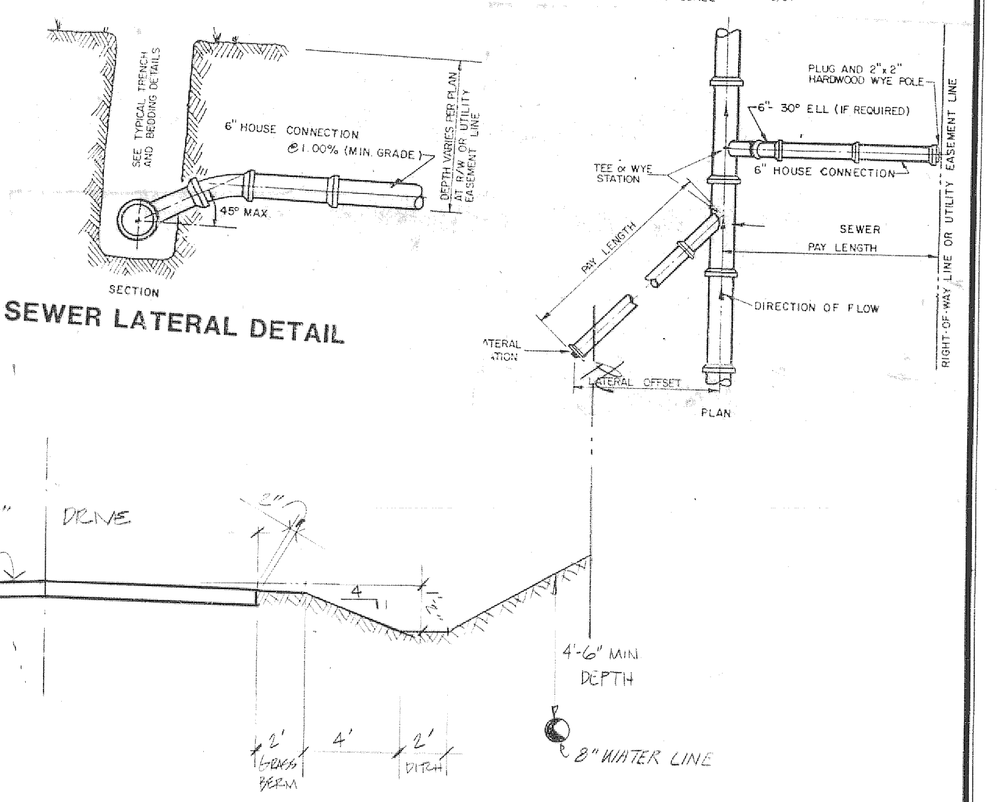

NOTE: SANITARY SEWER FROM MH. NO. 2 TO MH. NO. 4 TO BE CONSTRUCTED UNDER PHASE II

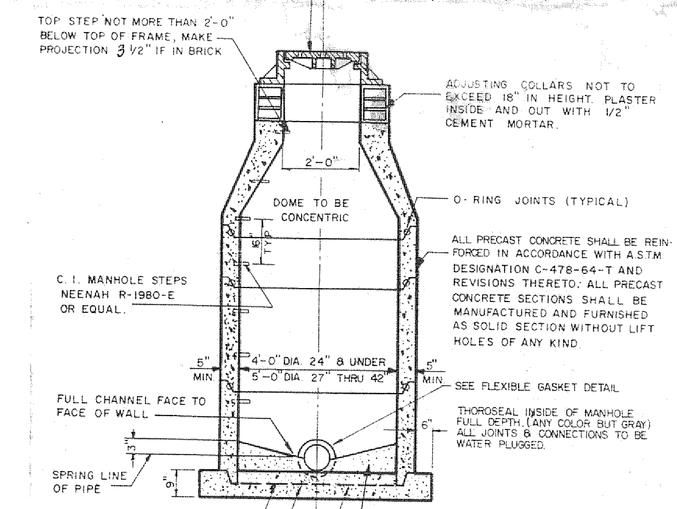

STANDARD CONCENTRIC PRECAST SANITARY MANHOLE
NO SCALE 5/94

ZONING PERMIT # 5560
ISSUED 6-23-87

SUBJECT TO APPROVAL BY:
- Lake County Sanitary Eng. ☐
- Lake County Eng. Dept. ☒
- Lake County Planning Comm. ☐
- Lake County Bldg. Dept. ☒

Tena S. Marano

Grading Plan Approved as shown and/or noted
THOMAS P. GILLES, P.E.
Lake County Engineer
By _____ Date 6-25-87

APPROVED ON ___ DAY OF _____, 1986, BY THE LAKE COUNTY DEPT. OF UTILITIES FOR SANITARY SEWER ONLY.

LAKE COUNTY SANITARY ENGINEER

CERTIFICATION
THIS PLAT WAS PREPARED BY ME AND IS CORRECT TO THE BEST OF MY KNOWLEDGE AND BELIEF
REG. SURVEYOR NO. _____

COLPETZER-THOMAS, INC.
AN ENGINEERING GROUP
WILLOUGHBY • MENTOR • NORTH CANTON • STEUBENVILLE • LORAIN

STATE OF OHIO — J. DAVID WILES 50281 — REGISTERED PROFESSIONAL ENGINEER

REV NO	DESCRIPTION	DATE	BY	CHK'D
1	REVISED STORM SEW.	9/16/85	CB	
2	ADDED SAN. SEW PROFILE	3/11/86	CB	
3	SAN. SEW. REVISION & WTR LINE REVISION	7/16/86	CB	
4	SITE PLAN FOR PARCEL NO. 2	8/21/86	CB	
5	ADDED [illegible]	[illegible]		

EAST POINT CONDOMINIUM
HOOSE ROAD, CONCORD TWP., OHIO.

DATE 11/8/85
DRAWN BY _____
CHECKED BY _____

SITE PLAN FOR PARCEL NO. 3
NORMANDY DEVELOPMENT
CONCORD TWP., OHIO.

SCALES
HOR 1"=50'
VERT
CONTRACT No. 85-411