NOTE: SANITARY SEWER FROM MH 110.2 TO MH 110.4 TO BE CONSTRUCTED UNDER PART II

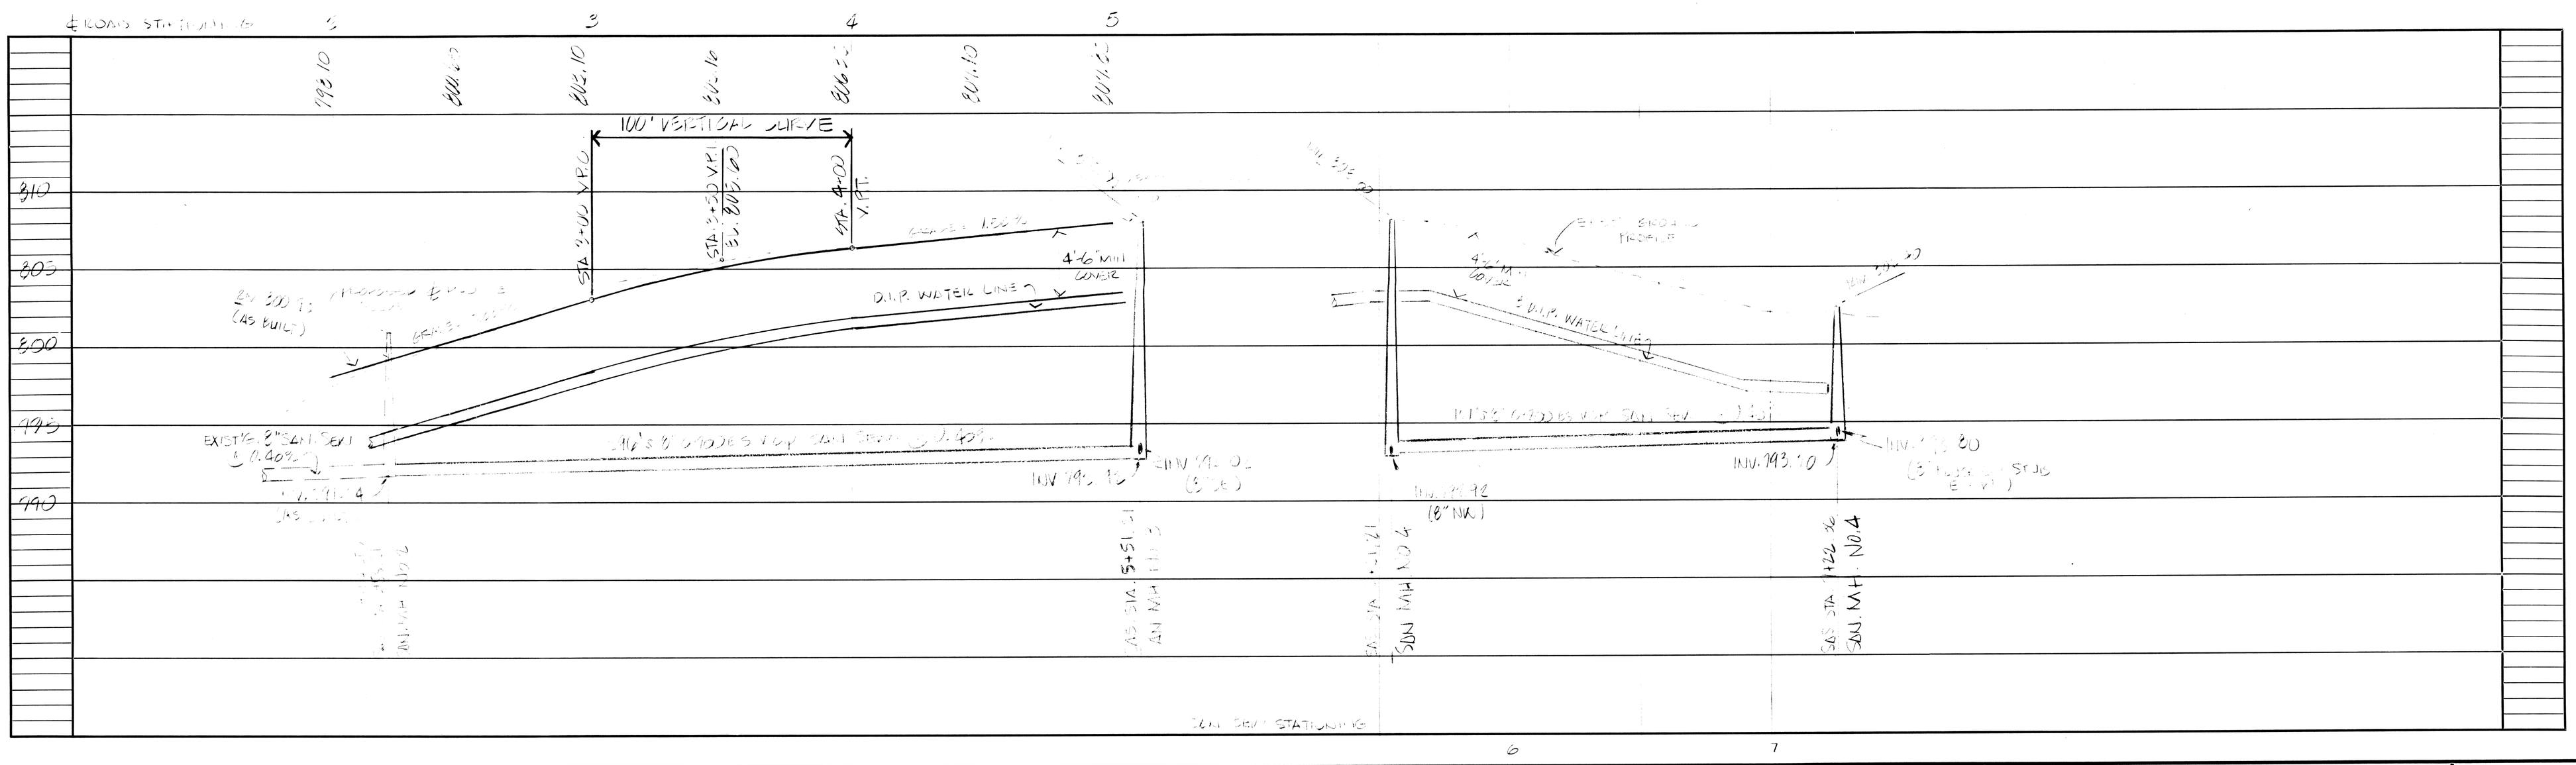

COLPETZER-THOMAS, INC.
AN ENGINEERING GROUP

REV. NO.	DESCRIPTION	DATE	BY	CH'K'D
1	[illegible]	[illegible]	[illegible]	

EAST POINT CONDOMINIUM
HOUSE ROAD CONCORD TWP OHIO

DATE: AUG 22 1986
DRAWN BY: CB
CHECKED BY:

SITE PLAN FOR PARCEL NO. 2
NORMANDY DEVELOPMENT
CONCORD TWP OHIO.

SCALES
HOR. 1"=30'
VERT. 1"=5'
CONTRACT No.
85-291