OFFICE: 354-4100 RES.: 354-8908

Grading Plan Approved as shown and/or noted
THOMAS P. GILLES, P.E.
Lake County Engineer
By JWK Date 5-24-74

JOSEPH D. HADDEN
Registered Surveyor
130 E. JACKSON STREET
PAINESVILLE, OHIO 44077

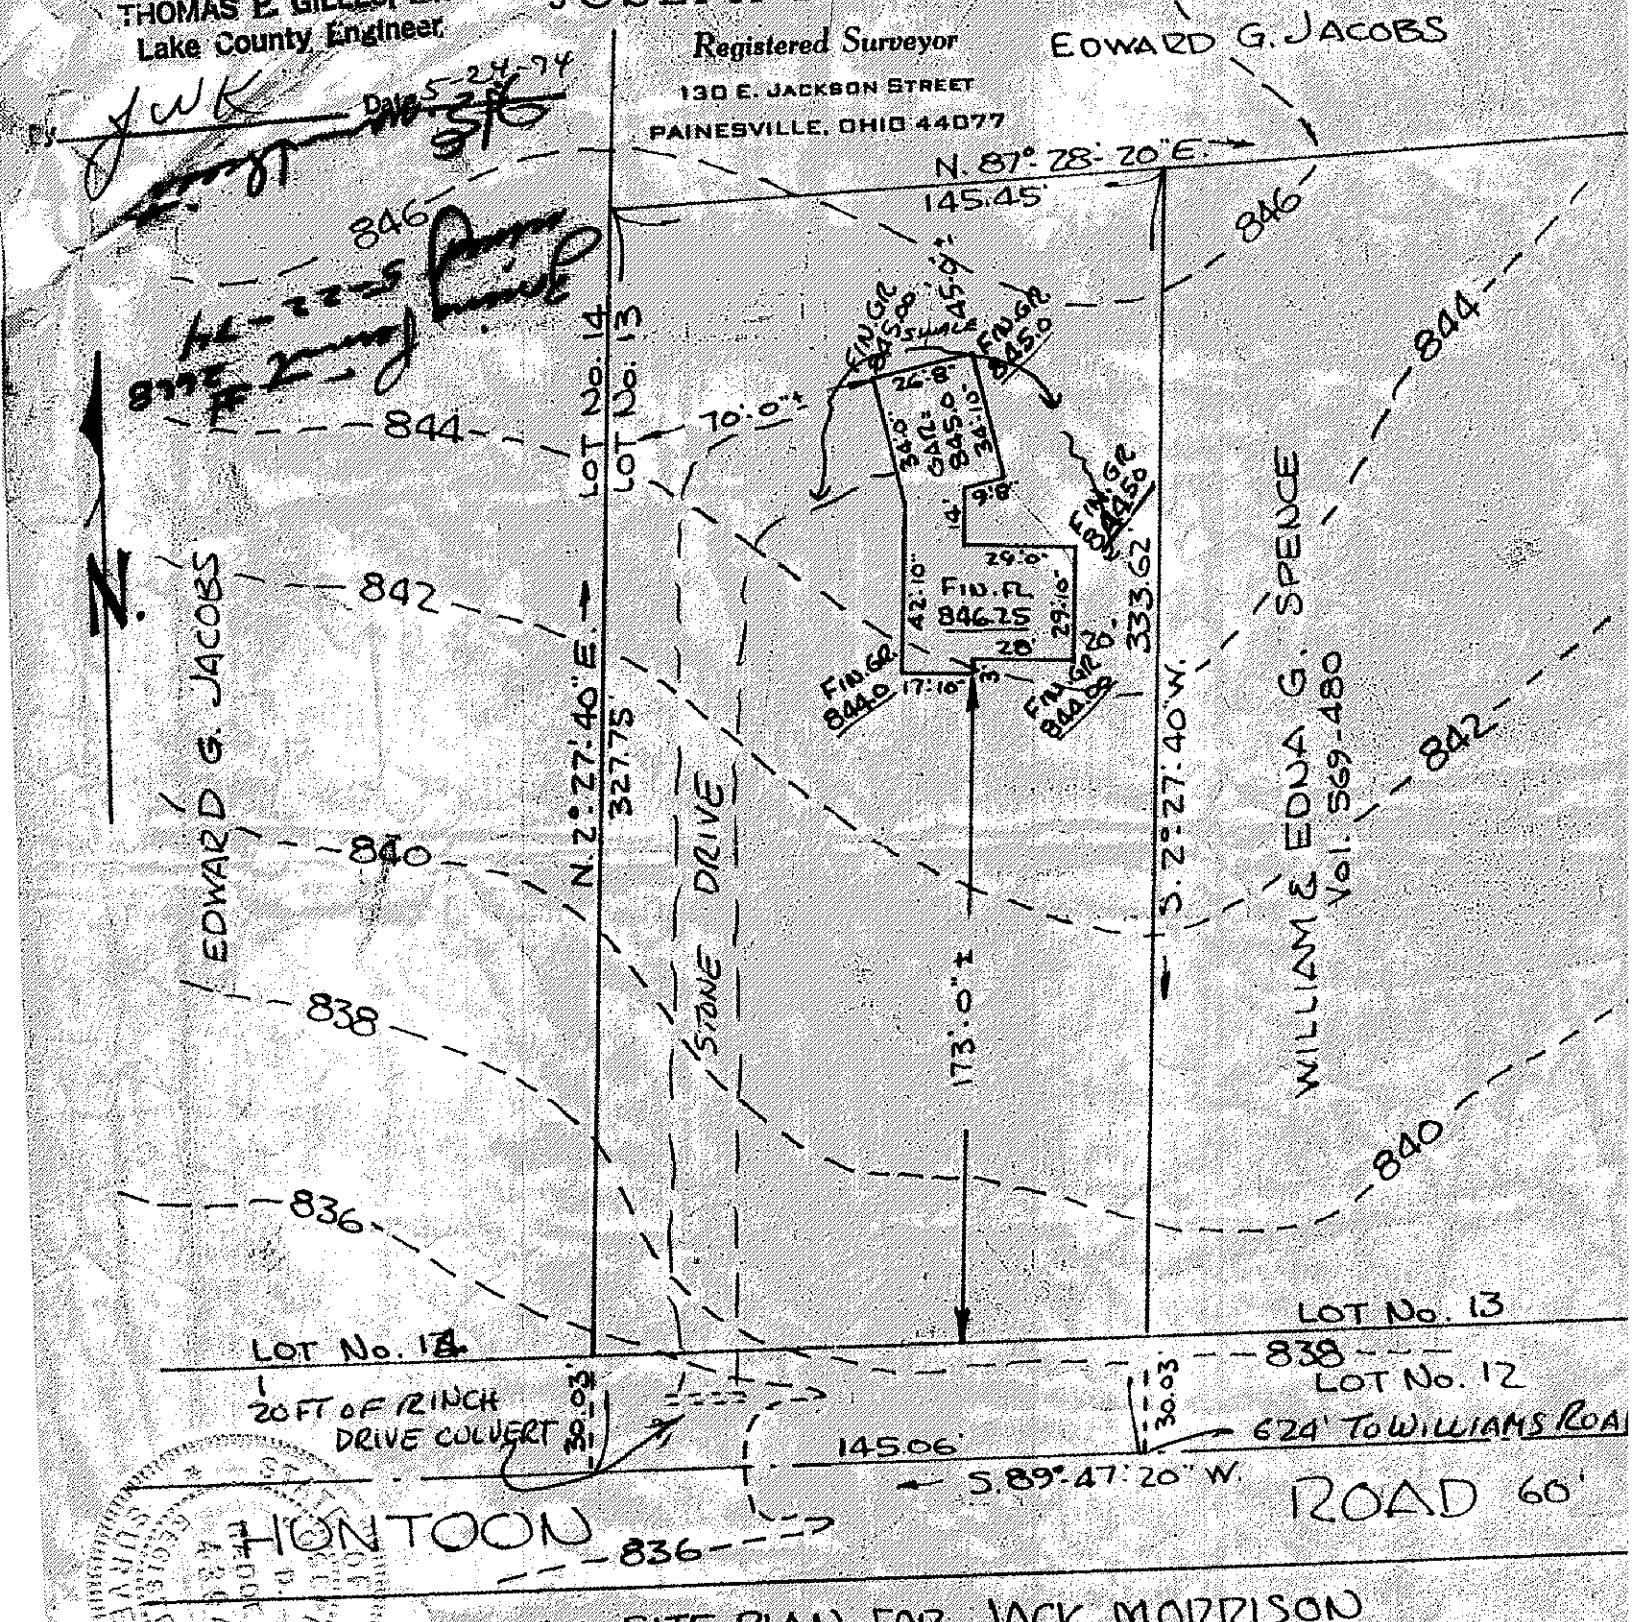

BUILDING SITE PLAN FOR JACK MORRISON
LOT No. 13 - TRACT No. 1 - CONCORD TWP - LAKE CO.
Scale 1" = 50' MAY 20, 1974 - Joseph D. Hadden - Reg. Surveyor

Joseph D. Hadden