SITE PLAN FOR:
RYAN HOMES
8141 TYLER BLVD
MENTOR, OHIO
BEING SUBLOT No. 61 IN
THE FAR HILLS ESTATES SUBDIVISION
IN CONCORD TOWNSHIP, OHIO

Grading Plan Approved as shown and/or noted
THOMAS P. GILLES, P.E.
Lake County Engineer
By _____ Date 4/6/78

PREPARED BY:
WM. R GRAY ASSOC. INC.
7547 MENTOR AVE
MENTOR, OHIO
SCALE: 1"=30'
DATE: JULY 21, 1978

ZONING PERMIT
3219
ISSUED 5-2-78
Steve Ward
SUBJECT TO APPROVAL BY:
Lake County Sanitary Eng. ☐
Lake County Eng. Dept. ☒
Lake County Planning Comm. ☐
Lake County Bldg. Dept. ☒

CERTIFICATION:
I HEREBY CERTIFY THAT
THIS PLAT IS CORRECT TO THE
BEST OF MY KNOWLEDGE
BY: Wm R Gray
WM. R. GRAY REG. SURV. #2752

STATE OF OHIO
WM. R. GRAY
2752
REGISTERED
PROFESSIONAL SURVEYOR
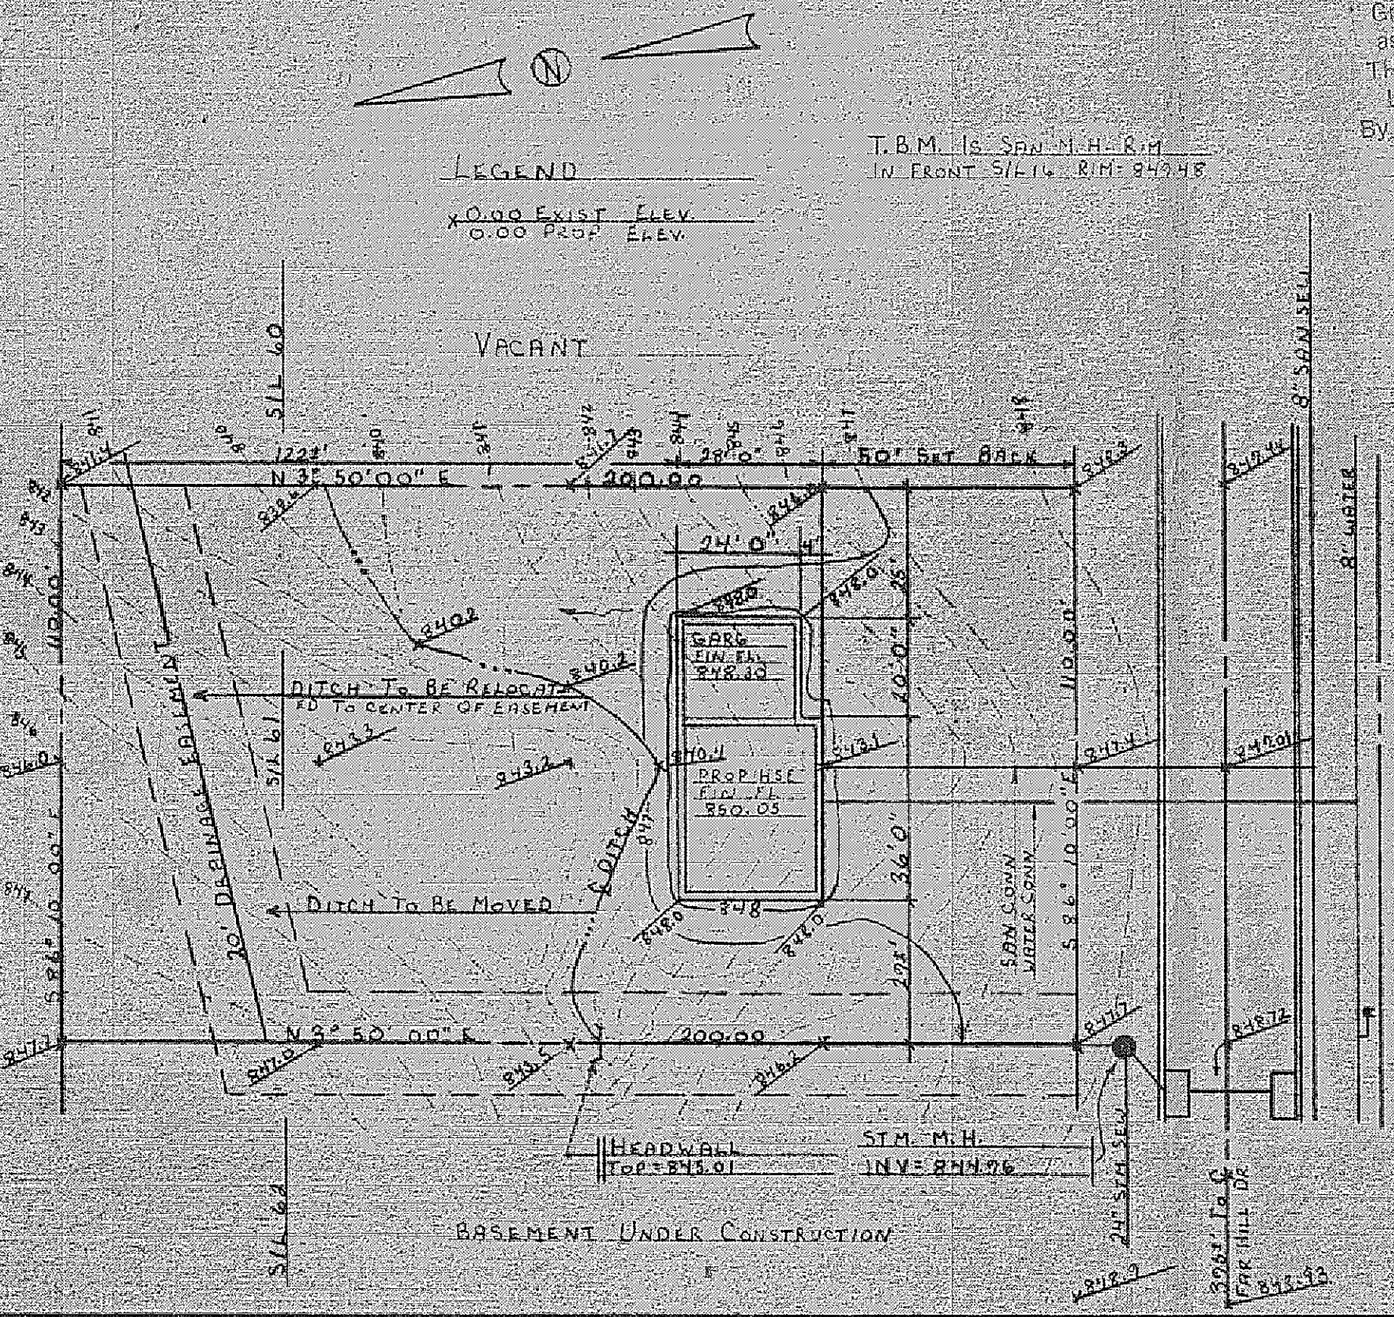
BUXTON F.B. 83-