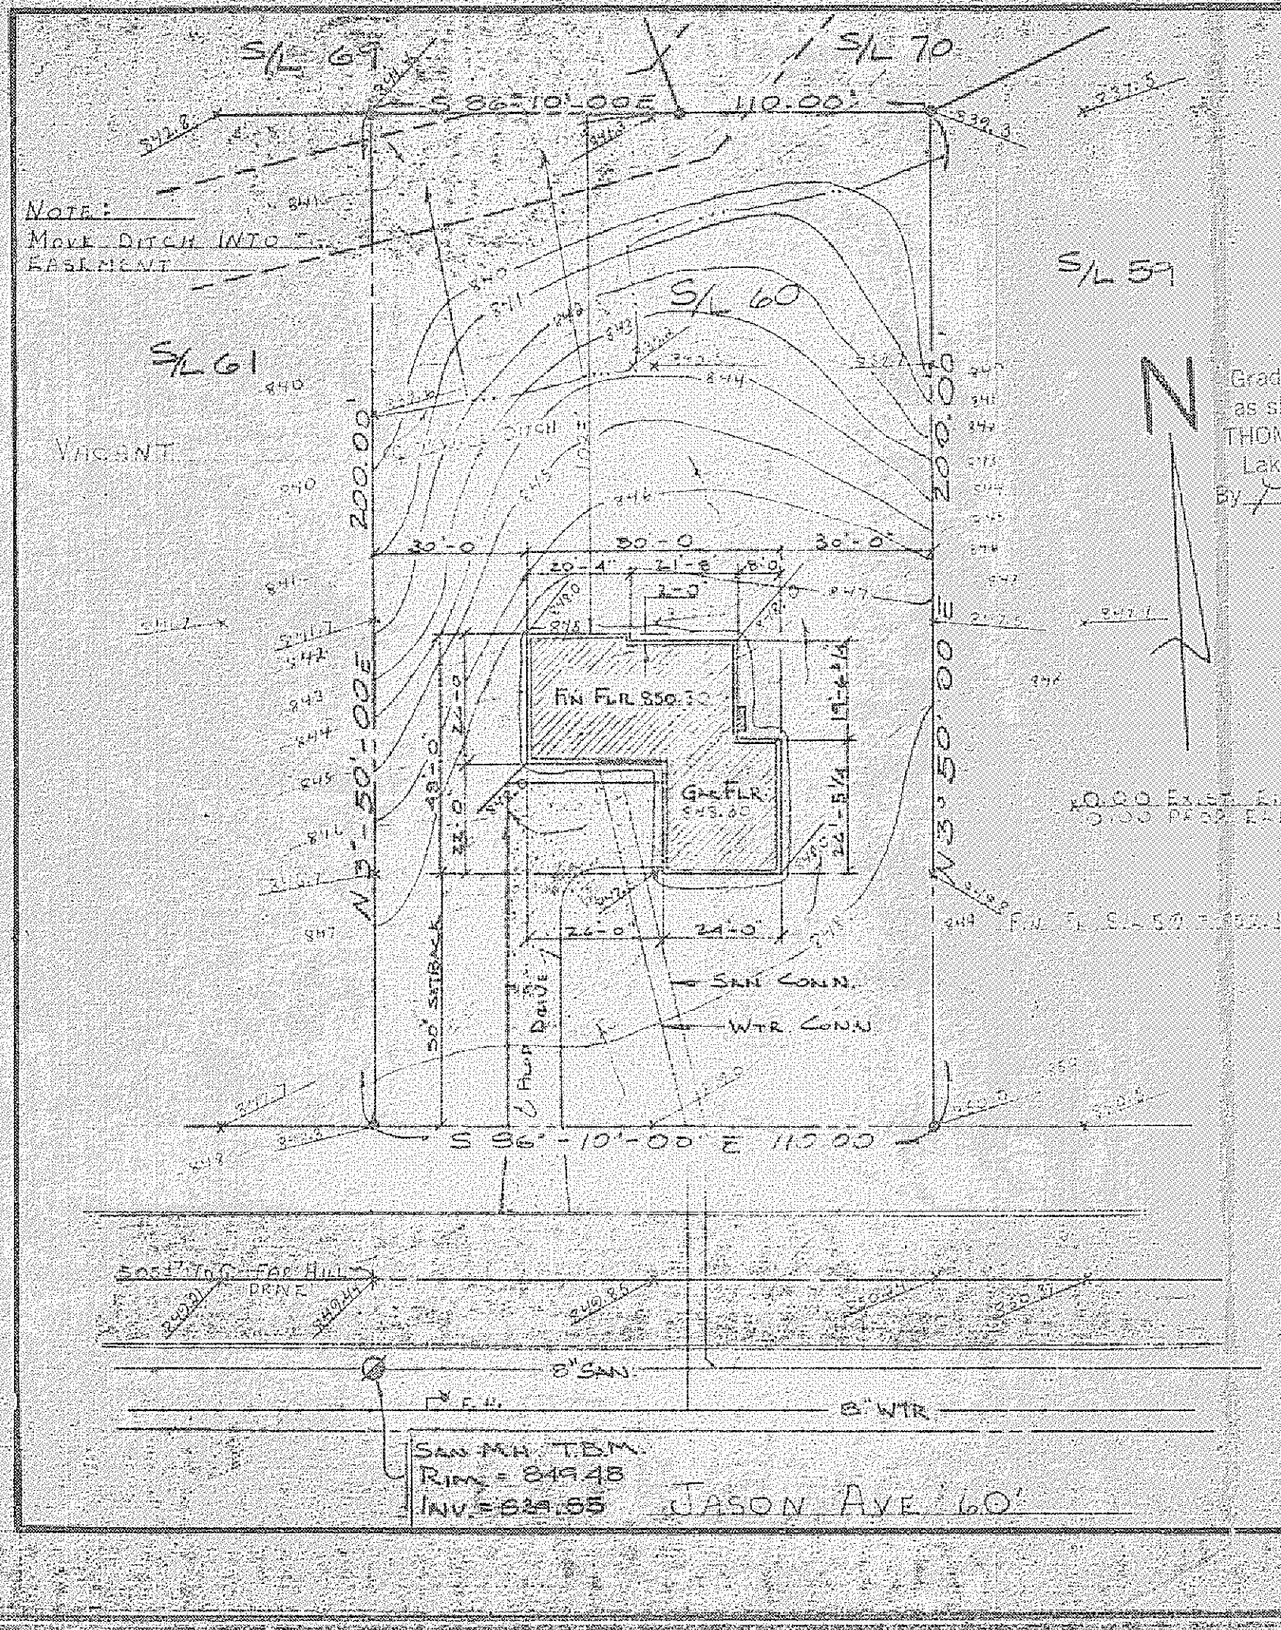

SITE PLAN:

RYAN HOMES

8141 TYLER BLVD MENTOR OHIO

SITUATED IN THE TOWSHIP OF CONCOIRD COUNTY OF LAKE AND STATE OF OHIO AND BEING SUBLOT No 60 IN FAR HILLS ESTATES No 2

Grading Plan Approved as shown and/or noted
THOMAS P. GILLES, P.E.
Lake County Engineer
By _____ Date 6-20-78

PREPARED BY:

WM. R GRAY ASSOC. INC.

7547 MENTOR AVE MENTOR OHIO

SCALE: 1"=30' DATE: MAY 31, 1978

CERTIFICATION:

I HEREBY CERTIFY THAT THIS PLAT IS CORRECT TO THE BEST OF MY KNOWLEDGE

By: Wm. R. Gray

Wm R. Gray Reg Surv. # 2752

STATE OF OHIO
WM. R. GRAY
2752
REGISTERED PROFESSIONAL SURVEYOR

COVINGTON ELL 251 F.B. 81-53