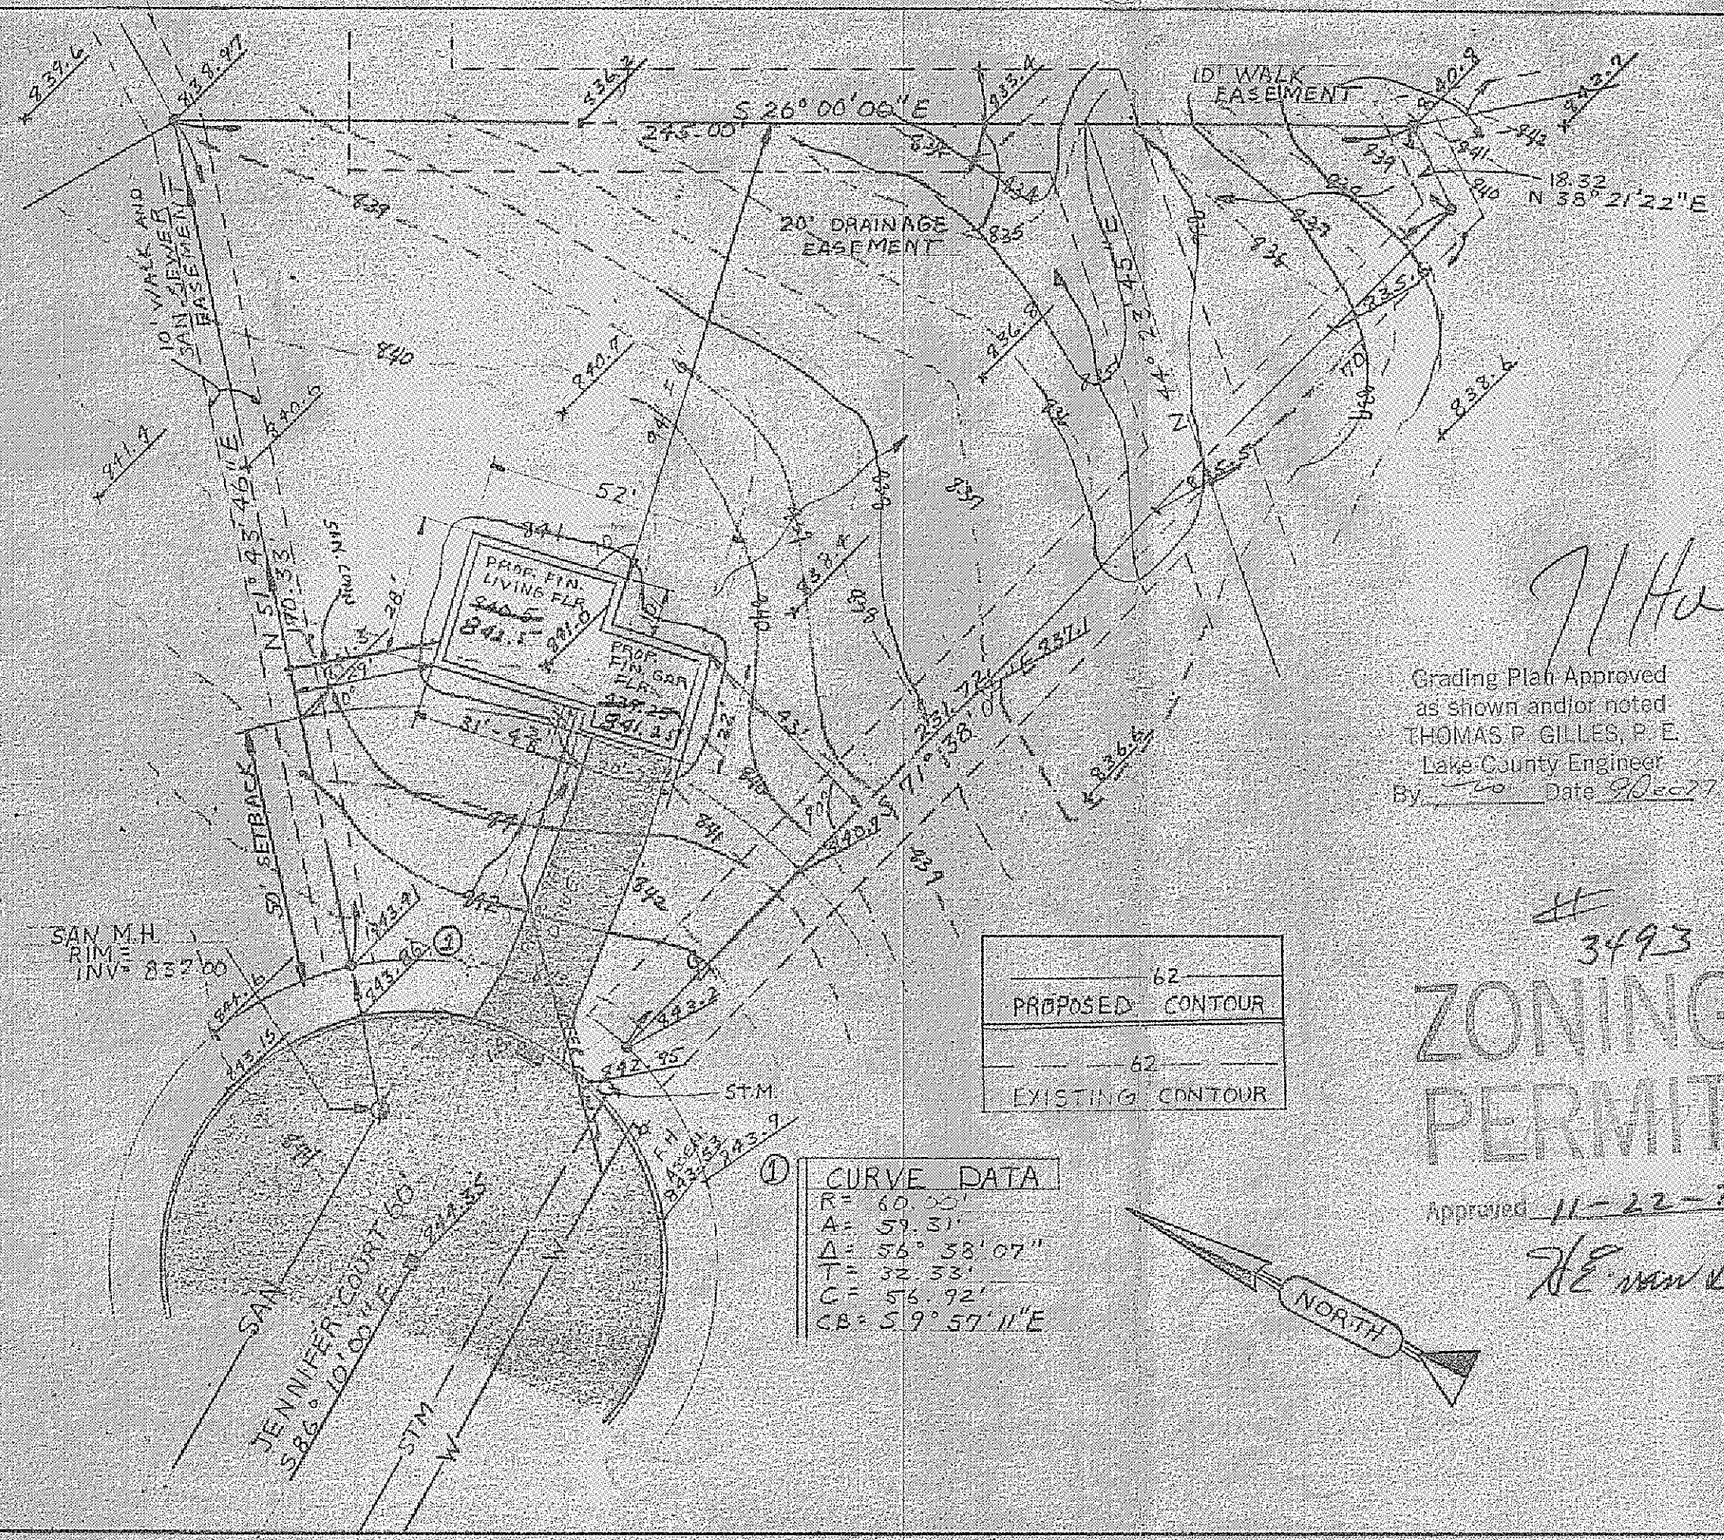

SITE PLAN FOR:

RYAN HOMES
8141 TYLER BLVD.
MENTOR, OHIO

BEING SUBLOT NO. 71 IN THE FAR HILLS SUBDIVISION LOCATED IN THE CITY OF CONCORD, COUNTY OF LAKE AND STATE OF OHIO.

Grading Plan Approved
as shown and/or noted
THOMAS P. GILLES, P. E.
Lake County Engineer
By _____ Date 9 Dec 77

PREPARED BY:

WM. A. GRAY ASSOC. INC.
7547 MENTOR AVE.
MENTOR, OHIO

SCALE: 1" = 30'
DATE: NOV. 18, 1977

ZONING PERMIT

3493

Approved 11-22-77

CERTIFICATION:

I HEREBY CERTIFY THAT THIS PLAT IS CORRECT TO THE BEST OF MY KNOWLEDGE.

By: Wm R. Gray
WM. A. GRAY JR. SURV. 2752

STATE OF OHIO
WM. R. GRAY
2752
REGISTERED
PROFESSIONAL SURVEYOR