SITE PLAN FOR:

RYAN HOMES
8141 TYLER BLVD.
MENTOR, OHIO
BEING SUBLOT No. 69 IN THE
FAR HILLS SUBDIVISION IN
CONCORD TOWNSHIP, OHIO

Grading Plan Approved as shown and/or noted
THOMAS P. GILLES, P.E.
Lake County Engineer
By: [illegible] Date 12 Dec 77

PREPARED BY:

WM GRAY ASSOC. INC.
7547 MENTOR AVE.
MENTOR, OHIO
SCALE: 1" = 30'
DATE: NOV. 14, 1977

CERTIFICATION:

I HEREBY CERTIFY THAT THIS PLAT IS CORRECT TO THE BEST OF MY KNOWLEDGE.
BY: Wm. R. Gray
WM. R. GRAY REG. SURV. #2752

69 Hut

STATE OF OHIO
WM. R. GRAY
2752
REGISTERED SURVEYOR

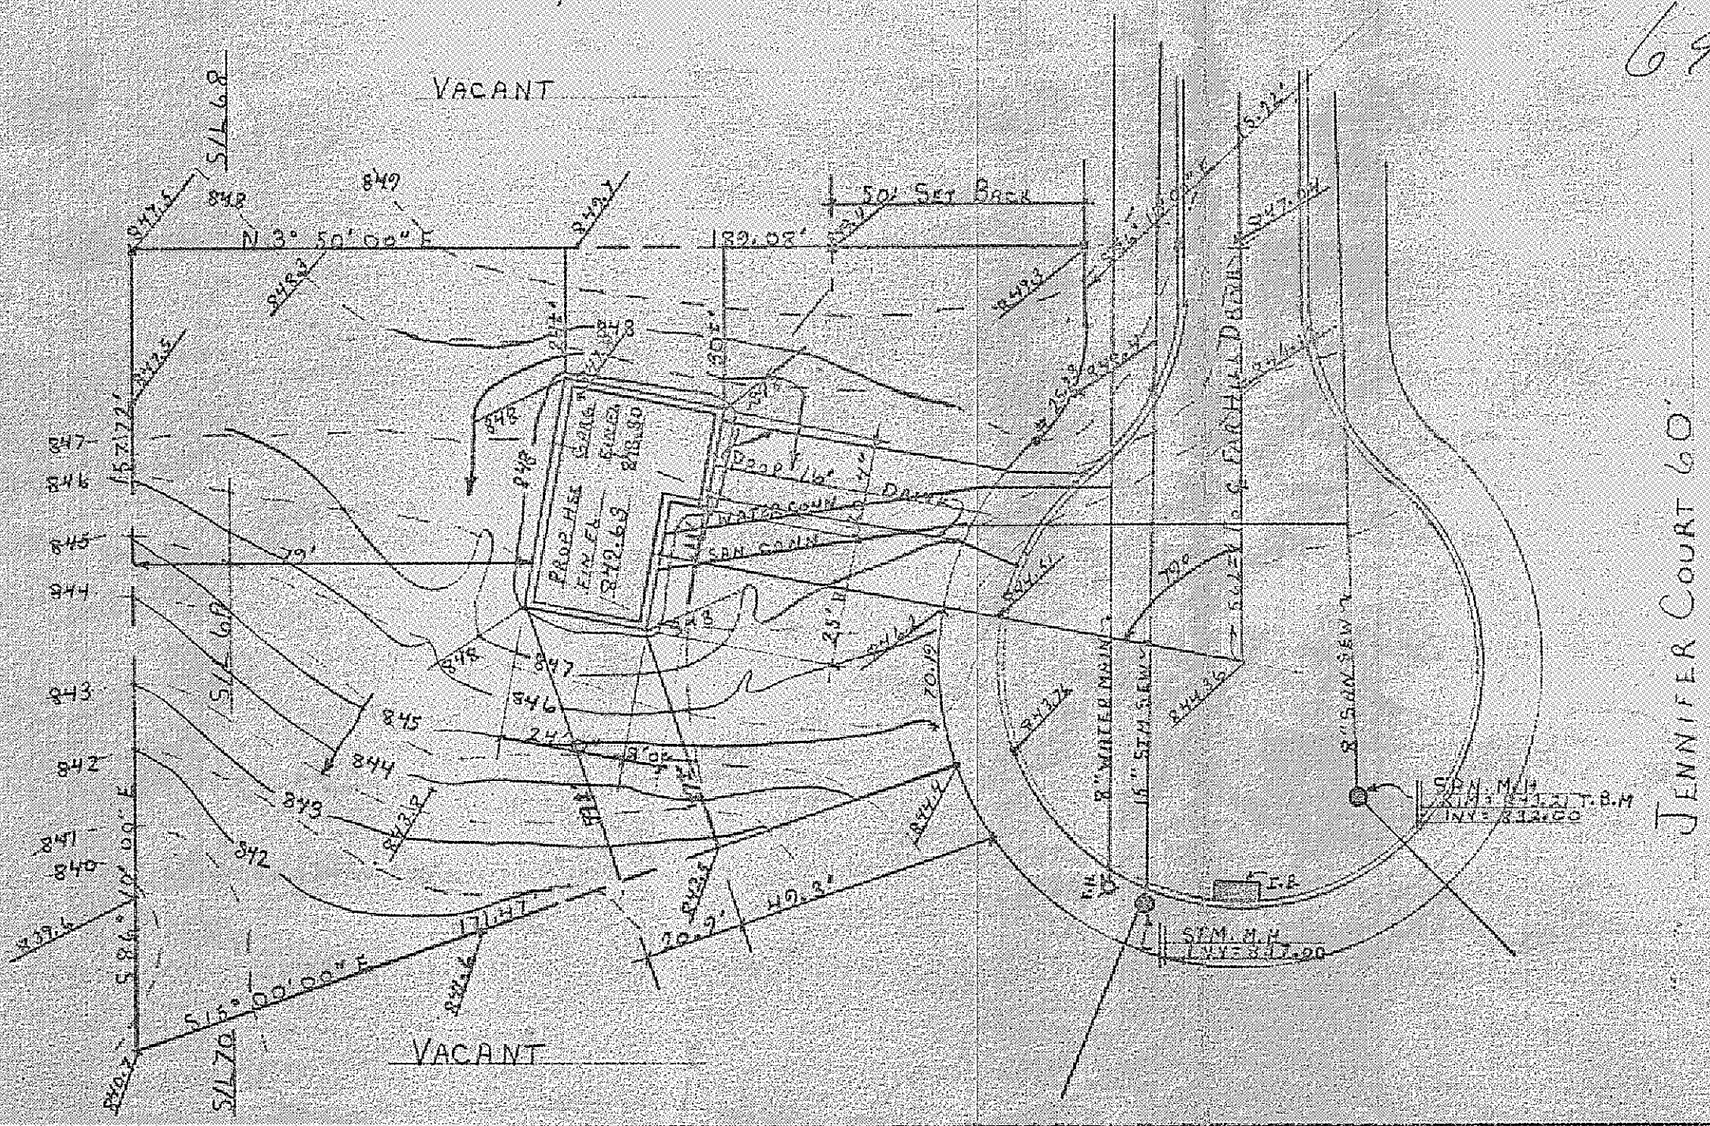

* CURVE DATA
R = 60.00'
Δ = 67° 01' 23"
A = 70.19'
T = 39.73'
C = 66.25'
S 71° 27' 05" E

# CURVE DATA
R = 30.00'
Δ = 48° 11' 23"
A = 25.23'
T = 13.42'
C = 24.49'
S 62° 04' 15" E

#3492

ZONING PERMIT

Approved 11-22-77
0.00 EXIST. ELEV.
0.00 PROP. ELEV.