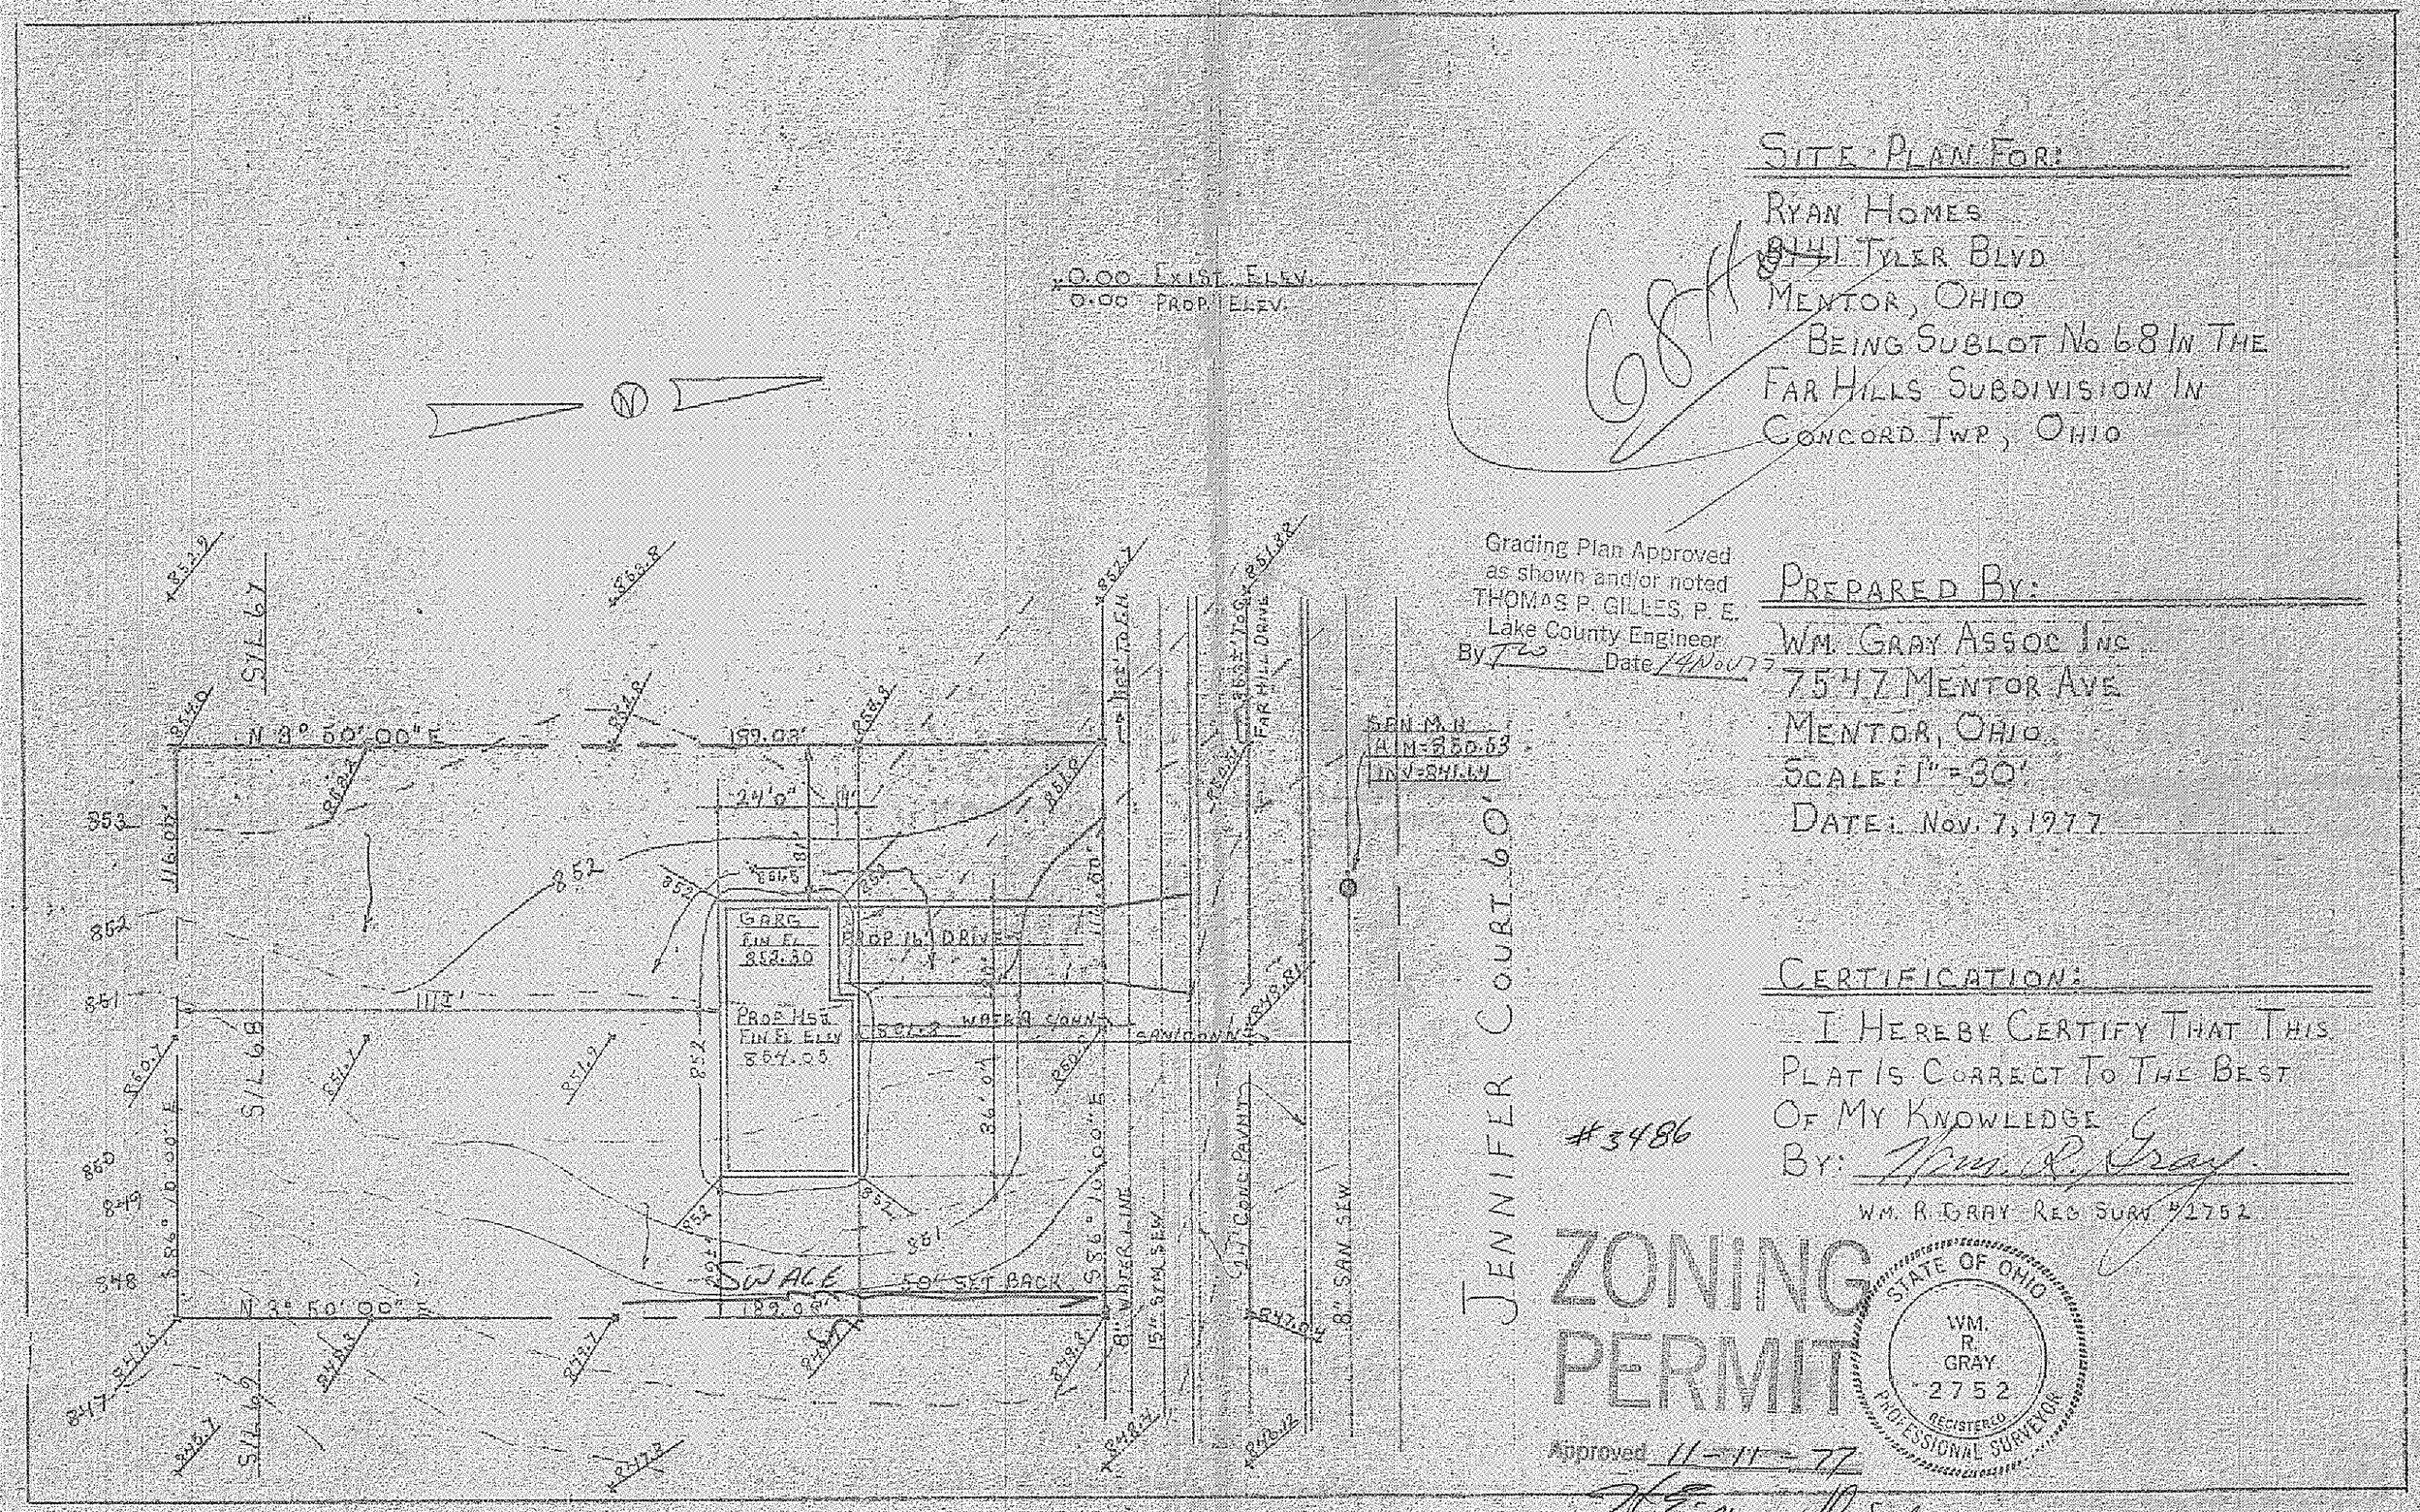

SITE PLAN FOR:

RYAN HOMES
8141 TYLER BLVD
MENTOR, OHIO
BEING SUBLOT NO. 68 IN THE
FAR HILLS SUBDIVISION IN
CONCORD TWP., OHIO

68

Grading Plan Approved
as shown and/or noted
THOMAS P. GILLES, P. E.
Lake County Engineer
By _____ Date 14 Nov 77

PREPARED BY:

WM. GRAY ASSOC INC.
7547 MENTOR AVE
MENTOR, OHIO
SCALE: 1" = 30'
DATE: Nov. 7, 1977

CERTIFICATION:

I HEREBY CERTIFY THAT THIS
PLAT IS CORRECT TO THE BEST
OF MY KNOWLEDGE
BY: Wm. R. Gray

WM. R. GRAY REG SURV #2752

#3486

ZONING
PERMIT

STATE OF OHIO
WM.
R.
GRAY
2752
REGISTERED
PROFESSIONAL SURVEYOR

Approved 11-11-77