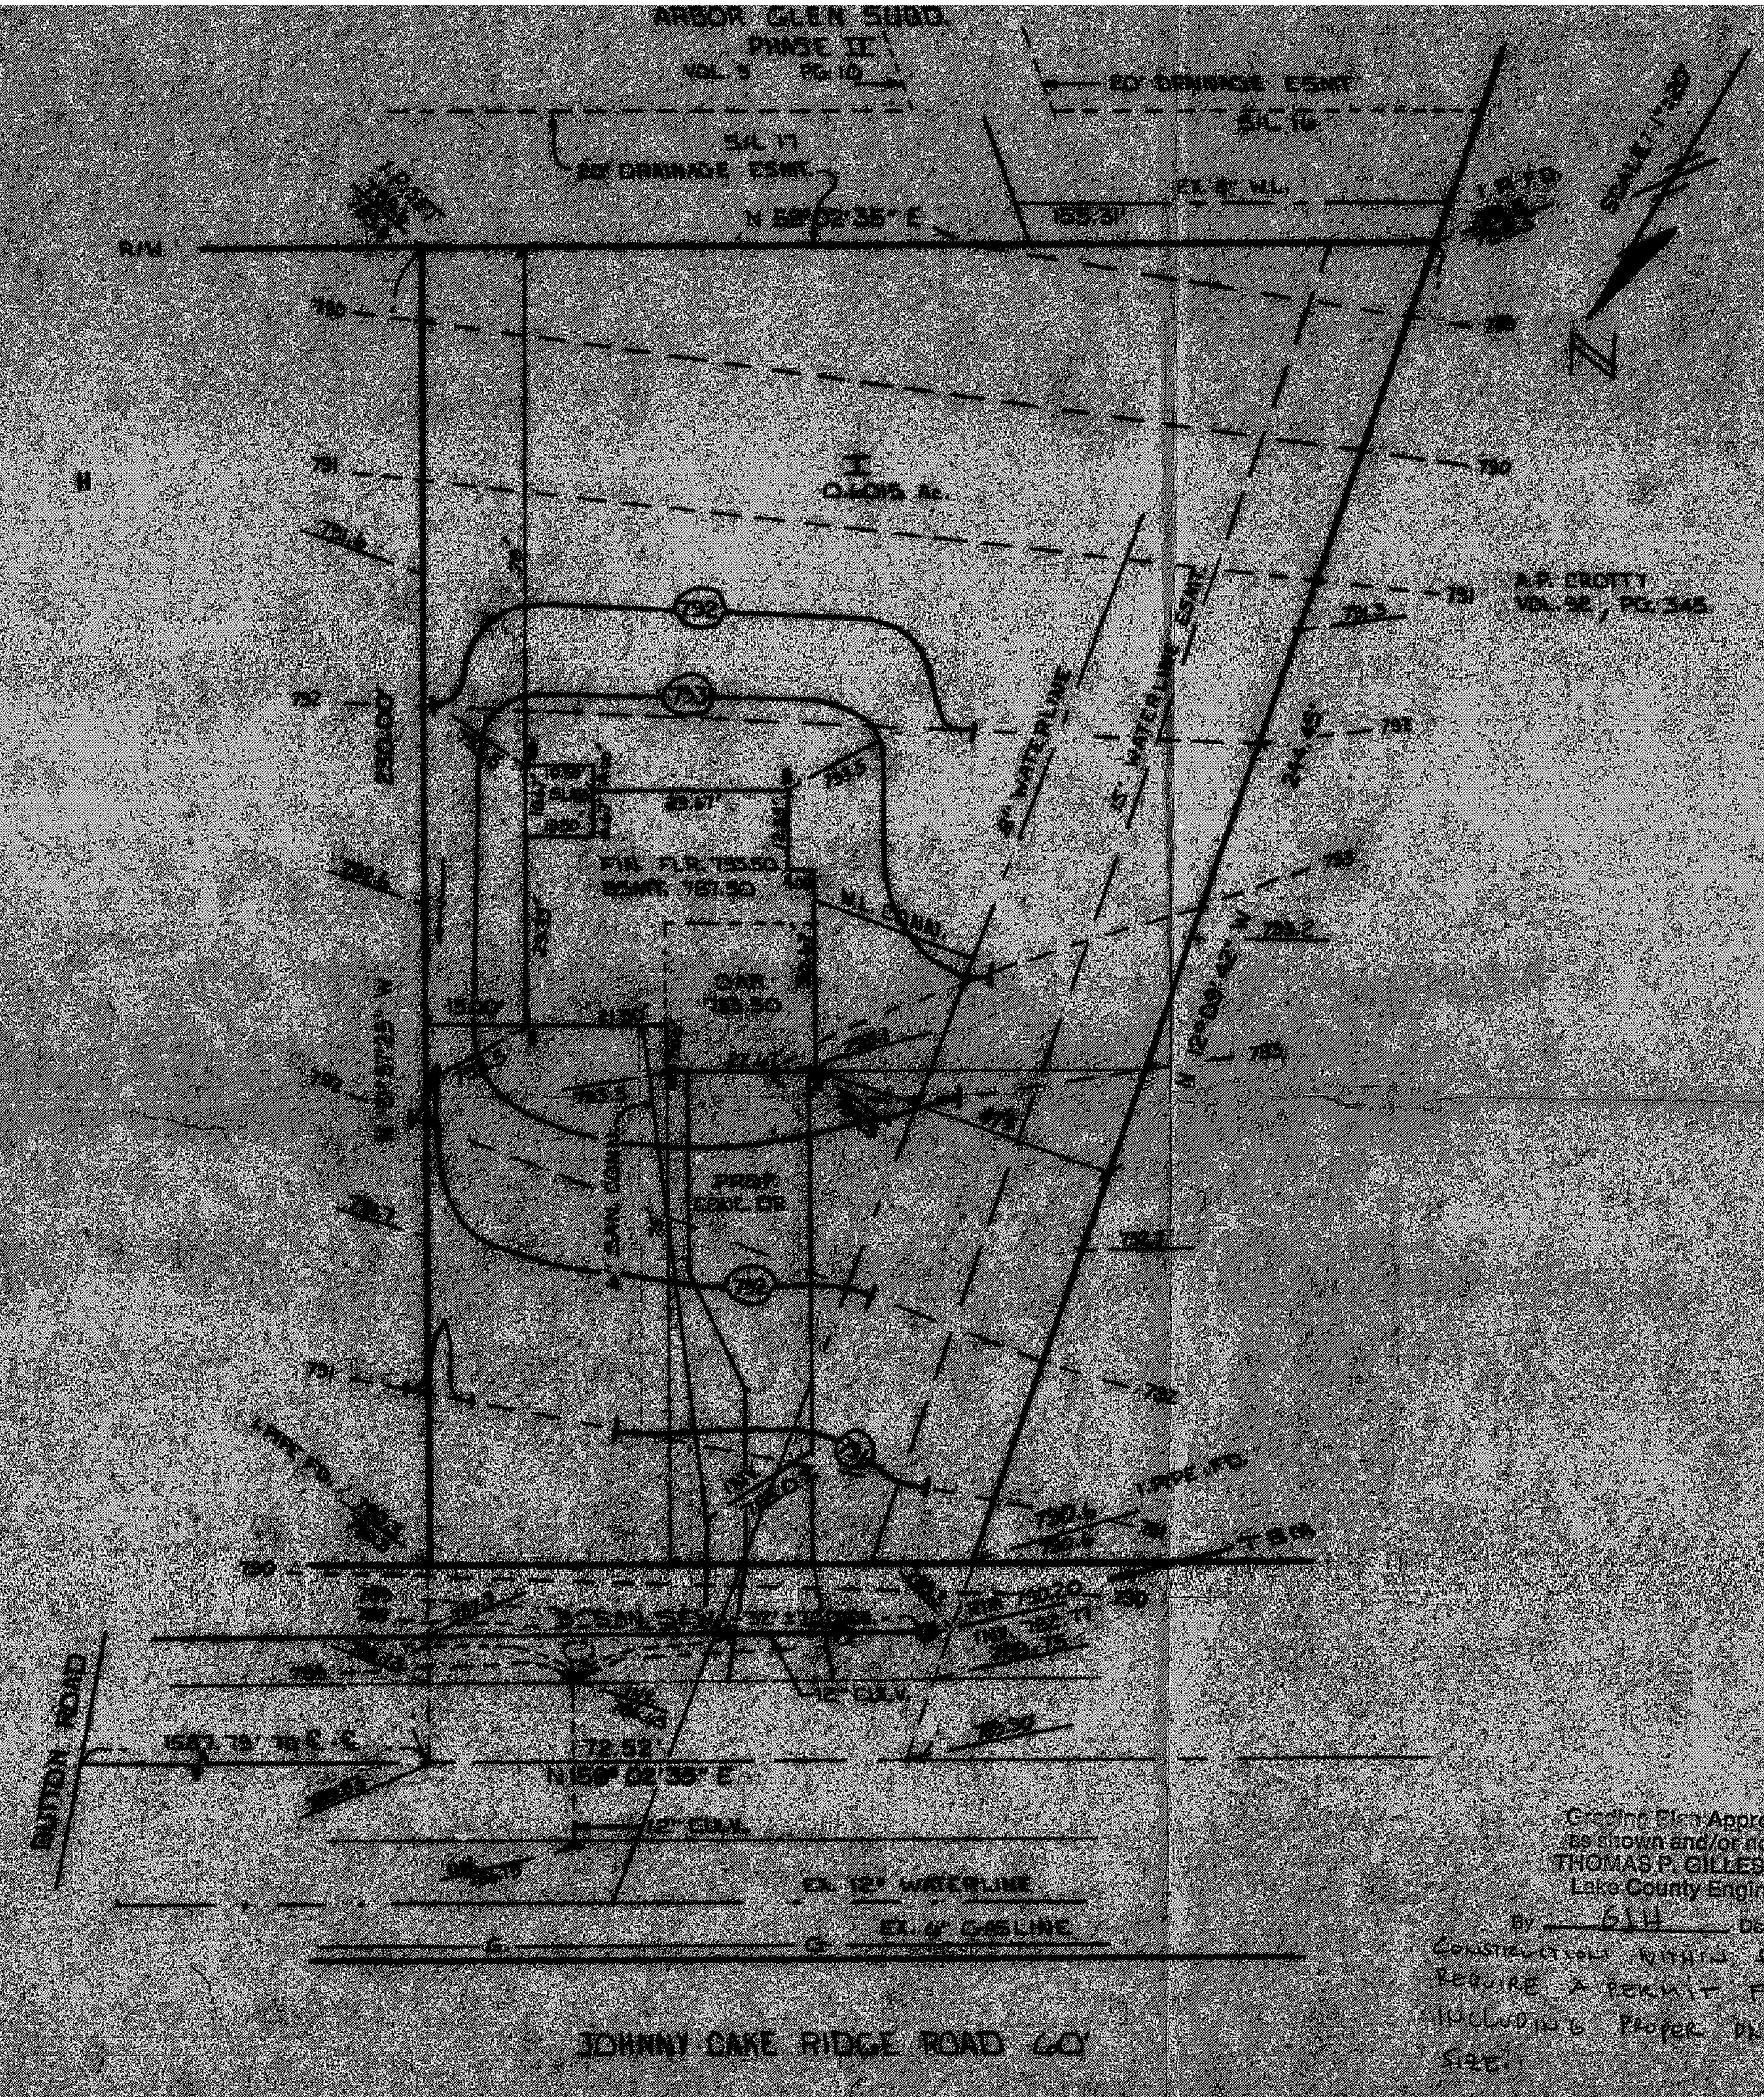

SITE PLAN

for: ANDREWS BUILDERS

35475	VINE	STREET	EASTLAKE
ADDRESS		STREET	CITY

II			
SUBDIV. No.	SUBDIVISION NAME	VOL.	PAGE
Ze. 4	CONCORD		OHIO
LOT/TRACT	TOWNSHIP		

GUTOSKEY & ASSOCIATES INC.
Civil Engineers and Surveyors
Chagrin Falls, Ohio

CHECK LIST

STATE SEAL: STATE OF OHIO — JOSEPH GUTOSKEY — REGISTERED PROFESSIONAL SURVEYOR

DESIGN CERTIFICATION
THIS PLAT WAS PREPARED BY ME AND IS CORRECT TO THE BEST OF MY KNOWLEDGE.
NAME DATE 12-2-94

"AS-BUILT" CERTIFICATION
I HEREBY CERTIFY THAT THE CIRCLED INFORMATION IS EXISTING AS OBTAINED ON THE SITE ______ 19___ AND IS CORRECT TO THE BEST OF MY KNOWLEDGE AND BELIEF.
NAME

LEGEND
STORM MANHOLE
SANITARY MANHOLE
EXISTING CONTOURS — 100 —
PROPOSED CONTOURS — (100) —
EXIST. ELEV. 100.0
100.0 PROP. ELEV.
DIRECTION OF SURFACE DRAINAGE

DRAWN BY	SCALE
MBH	1"=20'
CHK'D BY	DATE
JG	DEC. '94
REV.	
REV.	
REV.	

BENCHMARK: SAN. RIM 750.80

2 WORKING DAYS BEFORE YOU DIG
CALL TOLL FREE 800-362-2764
OHIO UTILITIES PROTECTION SERVICE

Grading Plan Approved
as shown and/or noted
THOMAS P. GILLES, P.E.
Lake County Engineer
By GLH Date 12-14-94
Construction within ZE-14 will require a permit from ODOT including proper drive culvert size.

ZONING PERMIT #1294-8036
ISSUED 12-28-94
SUBJECT TO APPROVAL BY:
Lake County Sanitary Eng. ☐
Lake County Eng. Dept. ☒
Lake County Planning Comm. ☐
Lake County Bldg. Dept. ☒

CONTRACT NO.
94-562-I