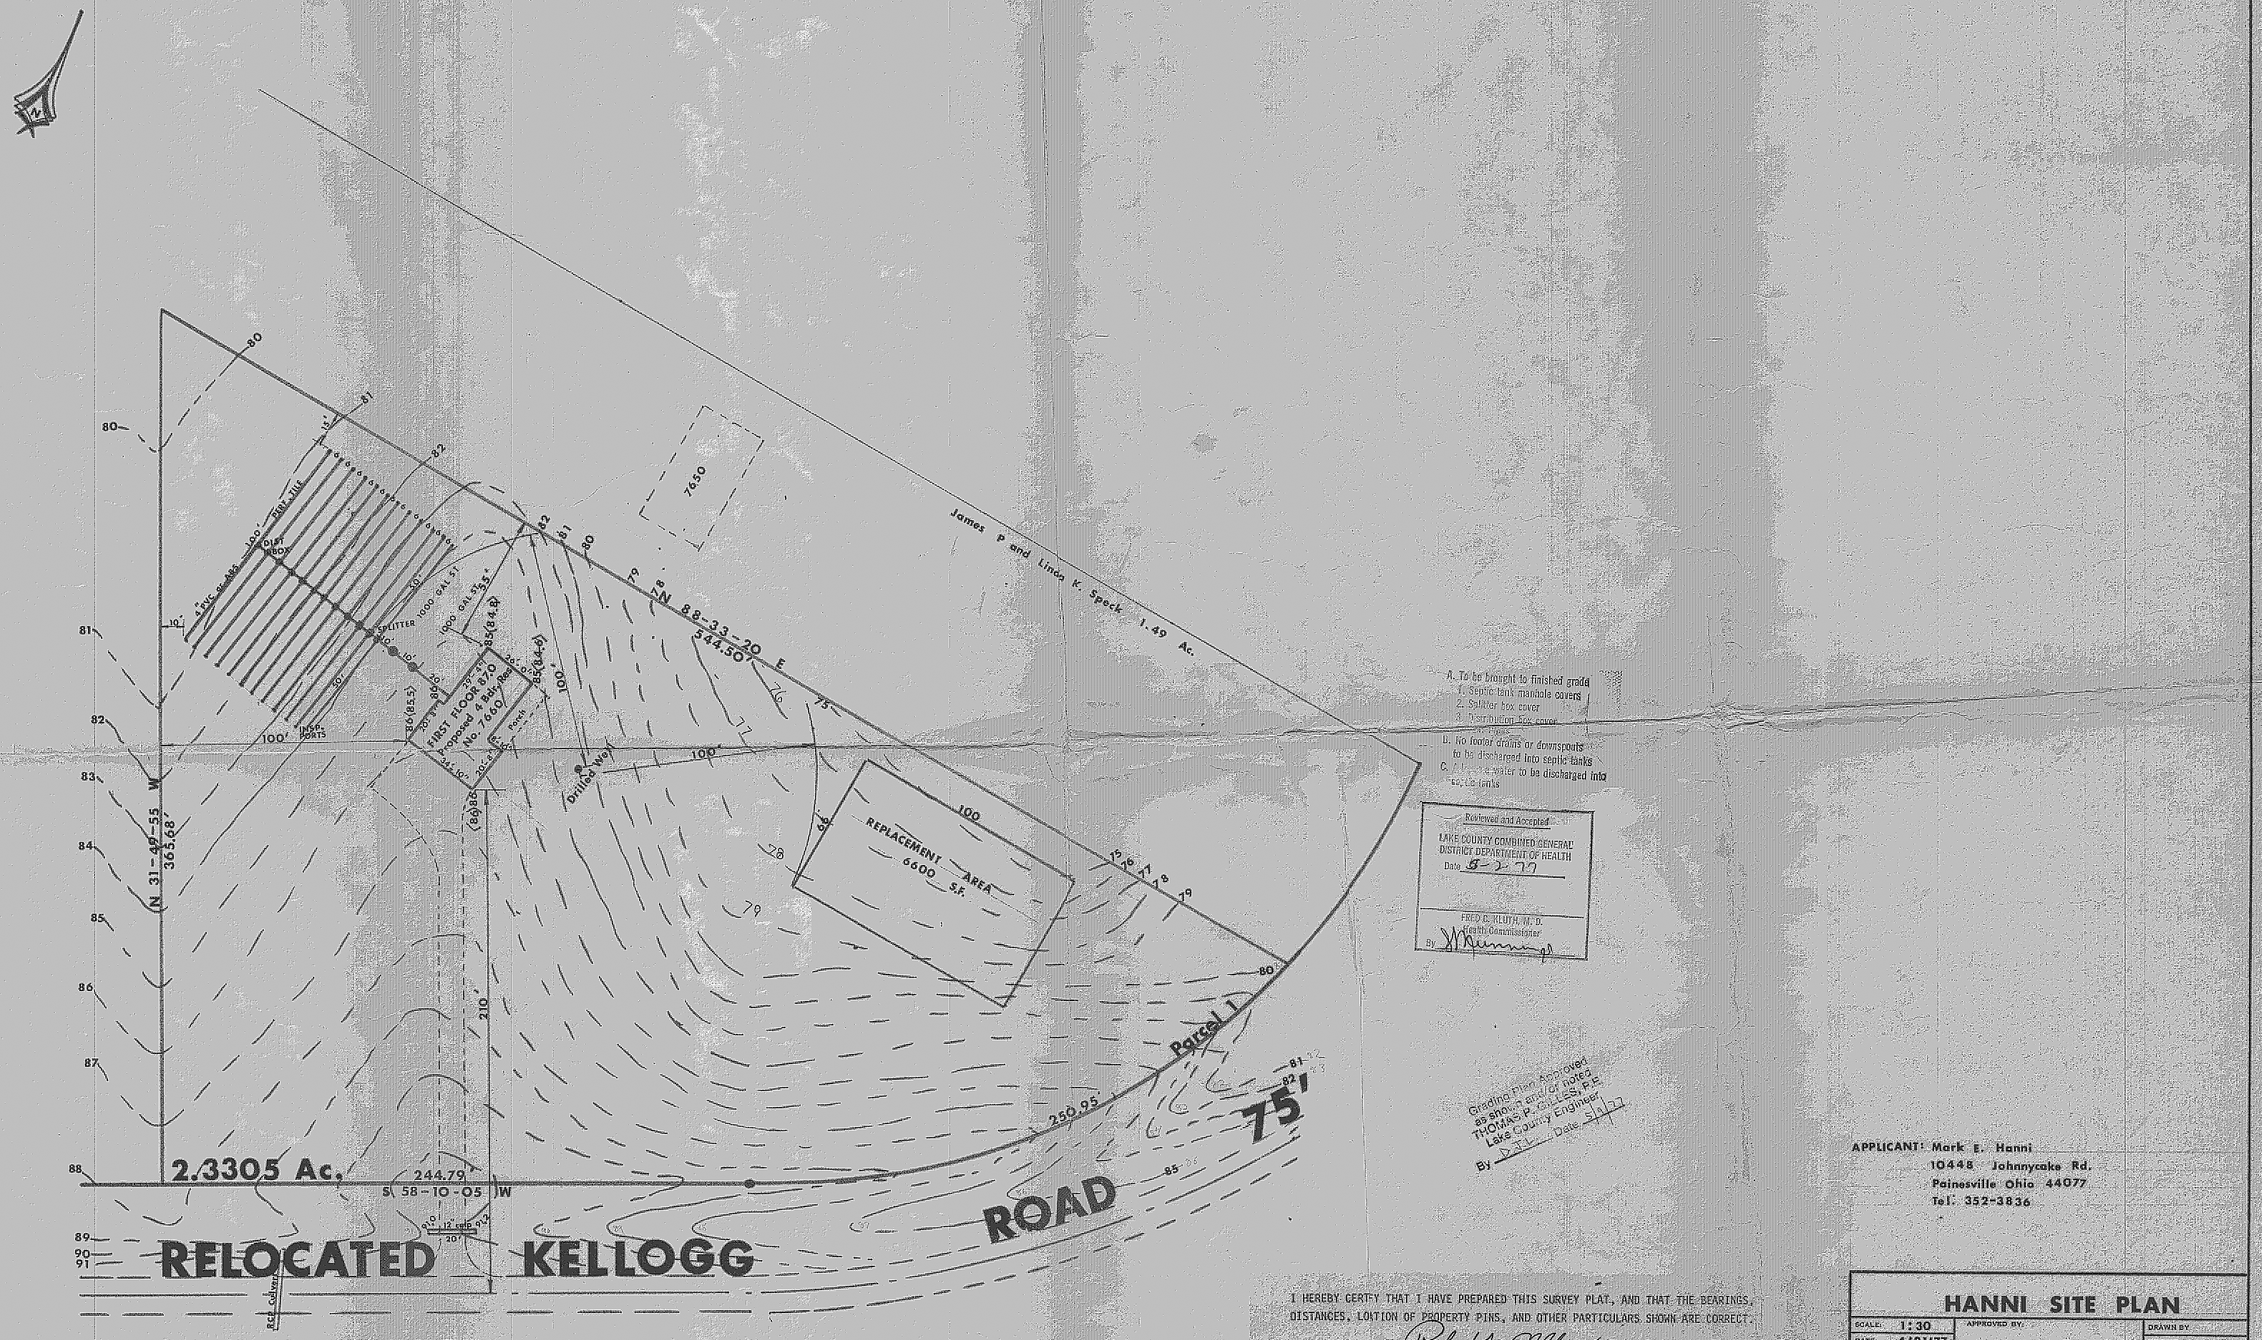

A. To be brought to finished grade
1. Septic tank manhole covers
2. Splitter box cover
3. Distribution box cover

B. No footer drains or downspouts to be discharged into septic tanks

C. [illegible] water to be discharged into septic tanks

Reviewed and Accepted
LAKE COUNTY COMBINED GENERAL DISTRICT DEPARTMENT OF HEALTH
Date 5-2-77
FRED D. KLUTH, M. D.
Health Commissioner
By [signature]

Grading Plan Approved as shown and/or noted
THOMAS P. GILLESS, P.E.
Lake County Engineer
By [signature] Date 5/11/77

APPLICANT: Mark E. Hanni
10448 Johnnycake Rd.
Painesville Ohio 44077
Tel. 352-3836

NOTE: ALL SEPTIC TANK CONSTRUCTION SHALL COMPLY WITH THE REQUIREMENTS OF THE LAKE COUNTY DEPARTMENT OF HEALTH FOR EVAPORATION-TRANSPIRATION SYSTEM.

I HEREBY CERTIFY THAT I HAVE PREPARED THIS SURVEY PLAT, AND THAT THE BEARINGS, DISTANCES, LOATION OF PROPERTY PINS, AND OTHER PARTICULARS SHOWN ARE CORRECT.

DATE: [illegible] Robert J. Albri

ROBERT J. ALBRI, REGISTERED CIVIL ENGINEER (P.E. 34873) AND LAND SURVEYOR (P.S. 5711)

HANNI SITE PLAN

SCALE: 1:30	APPROVED BY:	DRAWN BY
DATE: 4/21/77		REVISED

Concord Township · Lake County, Ohio

7660 Kellogg Road (parcel 1)

DRAWING NUMBER

OCE INDUSTRIES INC. #2319434 ELLCO VEL T/P