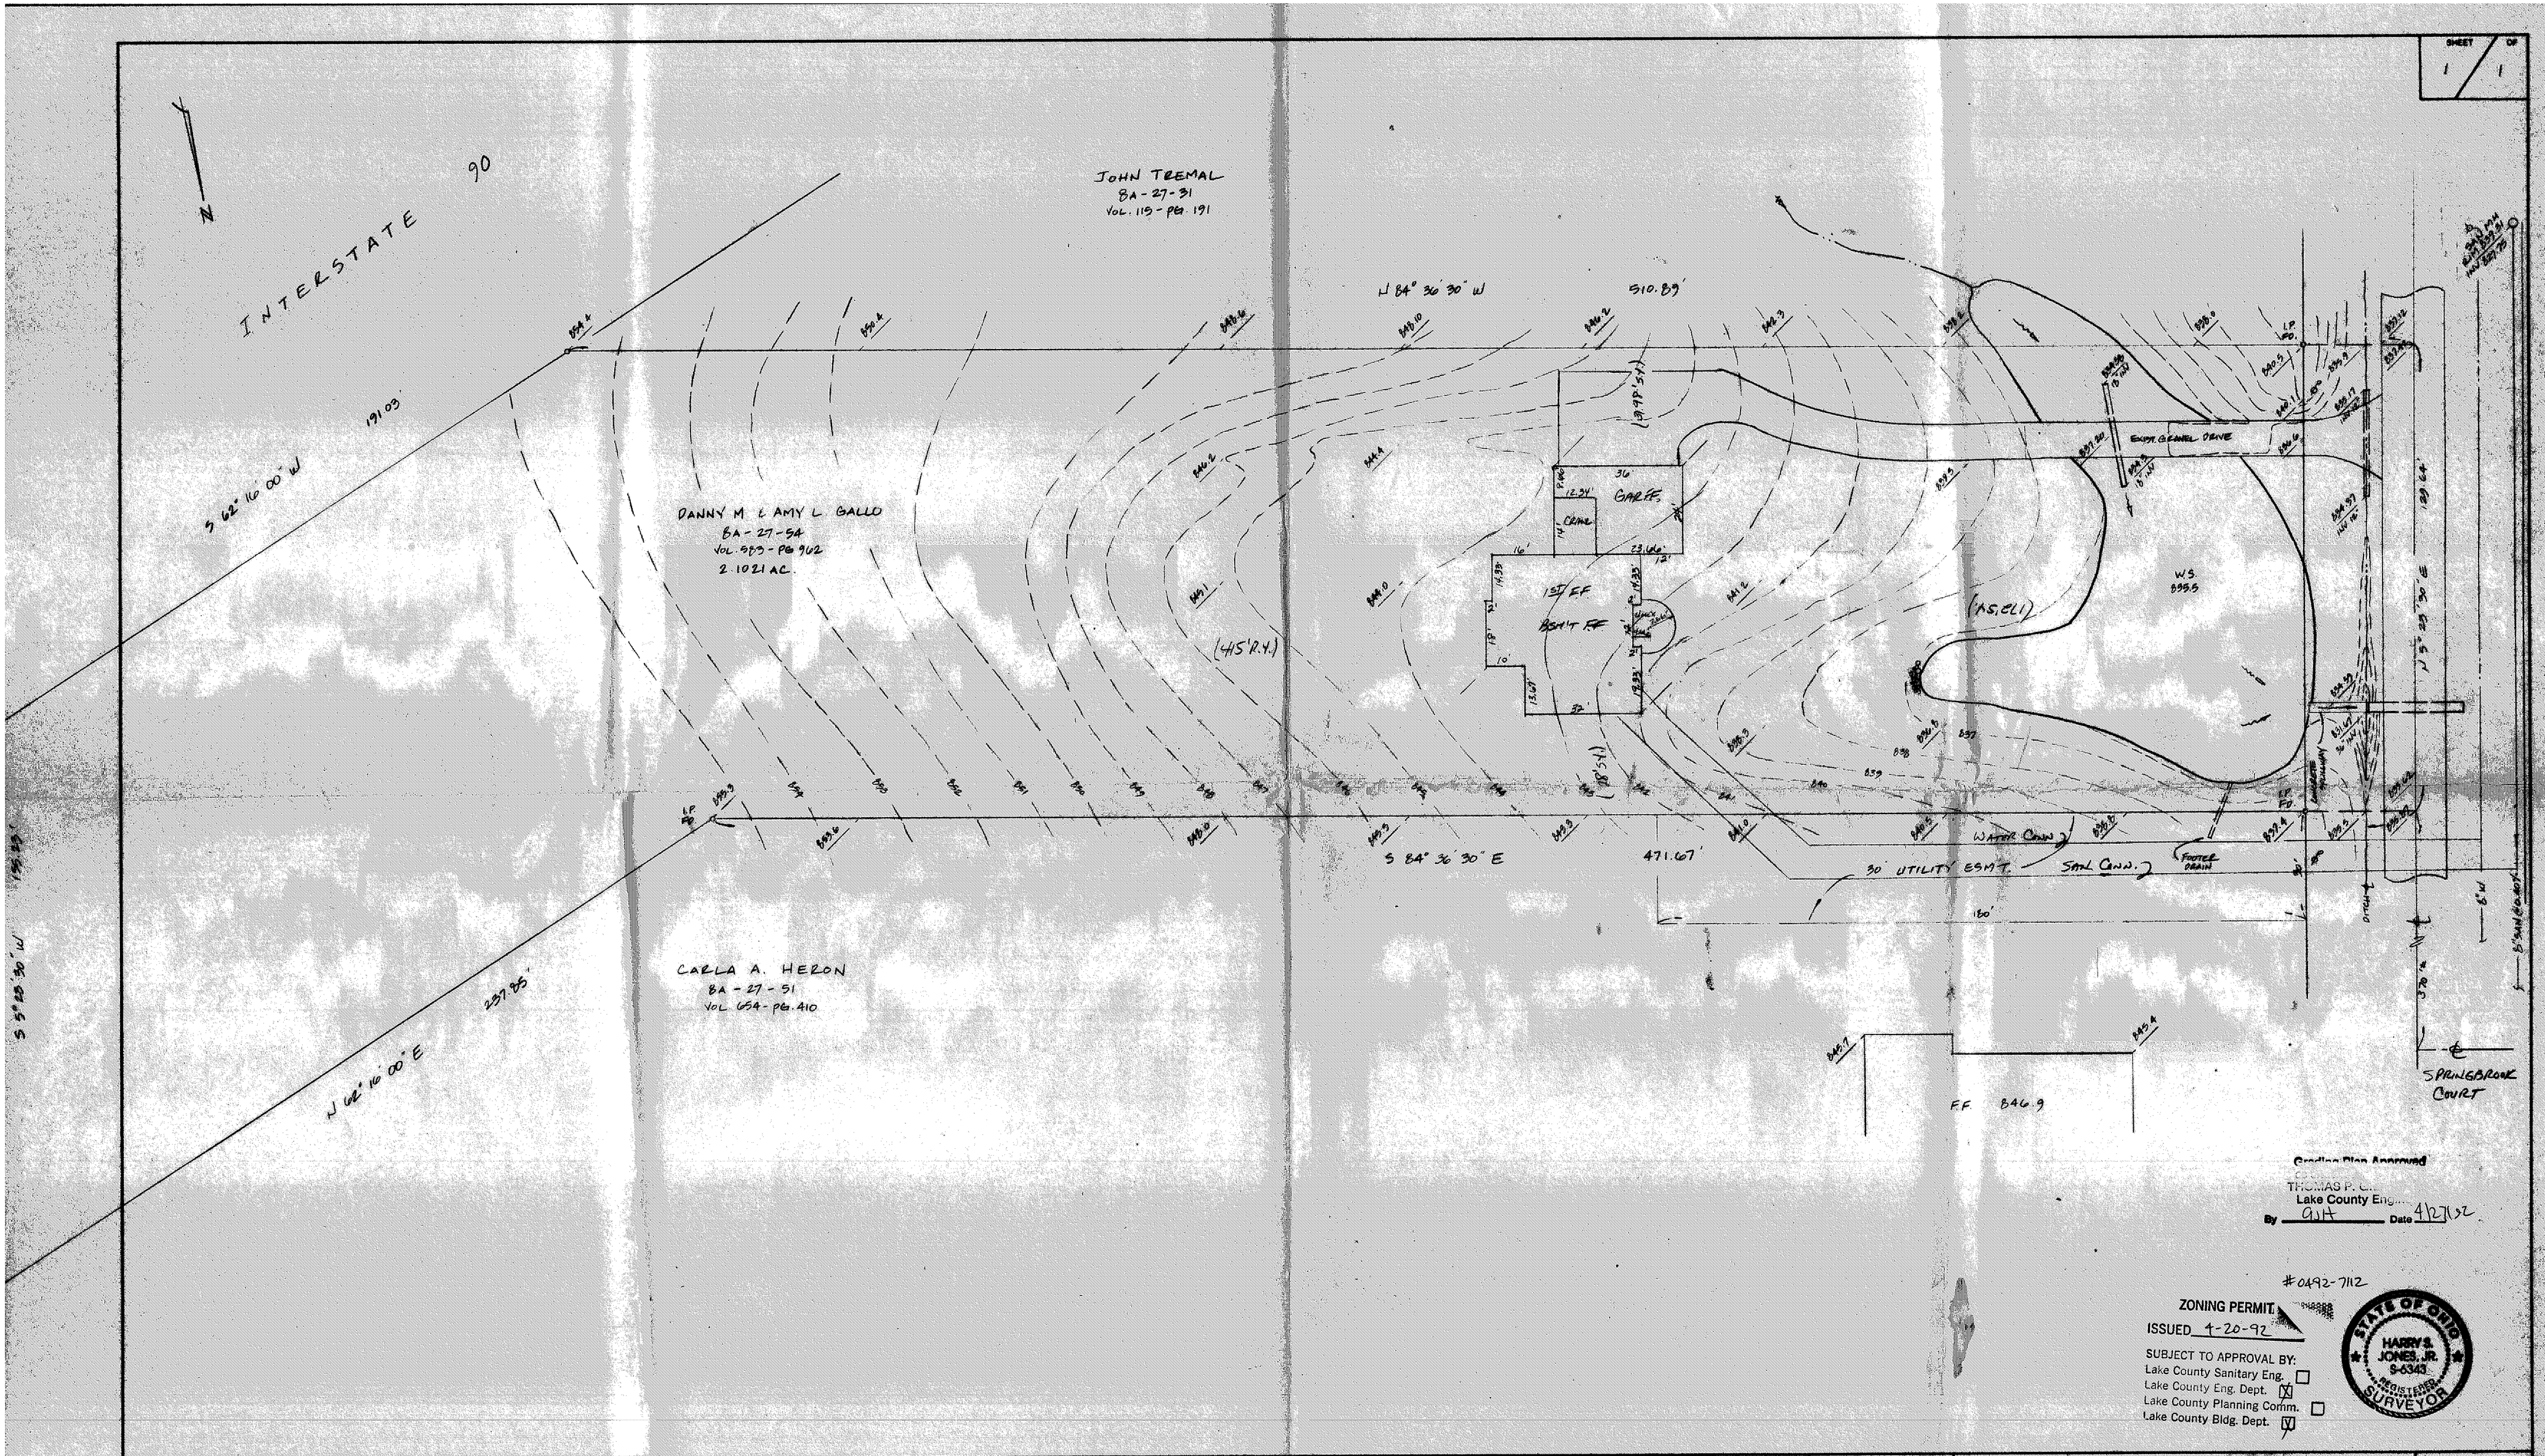

Grading Plan Approved
THOMAS P. C...
Lake County Eng...
By GJH Date 4/27/92

#0492-7112

ZONING PERMIT
ISSUED 4-20-92

SUBJECT TO APPROVAL BY:
Lake County Sanitary Eng. ☐
Lake County Eng. Dept. ☒
Lake County Planning Comm. ☐
Lake County Bldg. Dept. ☒

STATE OF OHIO
HARRY S. JONES, JR.
S-6343
REGISTERED SURVEYOR

REV NO.	DESCRIPTION	DATE	BY	CHK'D
1	REVISED SETBACK	4-8-92	HJ	HJ

SITE PLAN
FOR
NAUGHTON BUILDERS

BABCOCK, JONES AND ASSOCIATES, INC
CIVIL ENGINEERS - SURVEYORS - LAND PLANNERS
PAINESVILLE OHIO 44077

DATE MARCH 1992
DESIGN BY HJ
DRAWN BY
APPROVED BY HJ

KNOW AS BEING PART OF LOT # 28, TRACT # 4
CONCORD TWP. LAKE COUNTY OHIO
PERM. PARCEL # BA-27-54 VOL. 583 - PG. 962

SCALE 1" = 20'
JOB NO. 92-028
SHEET 1 OF 1