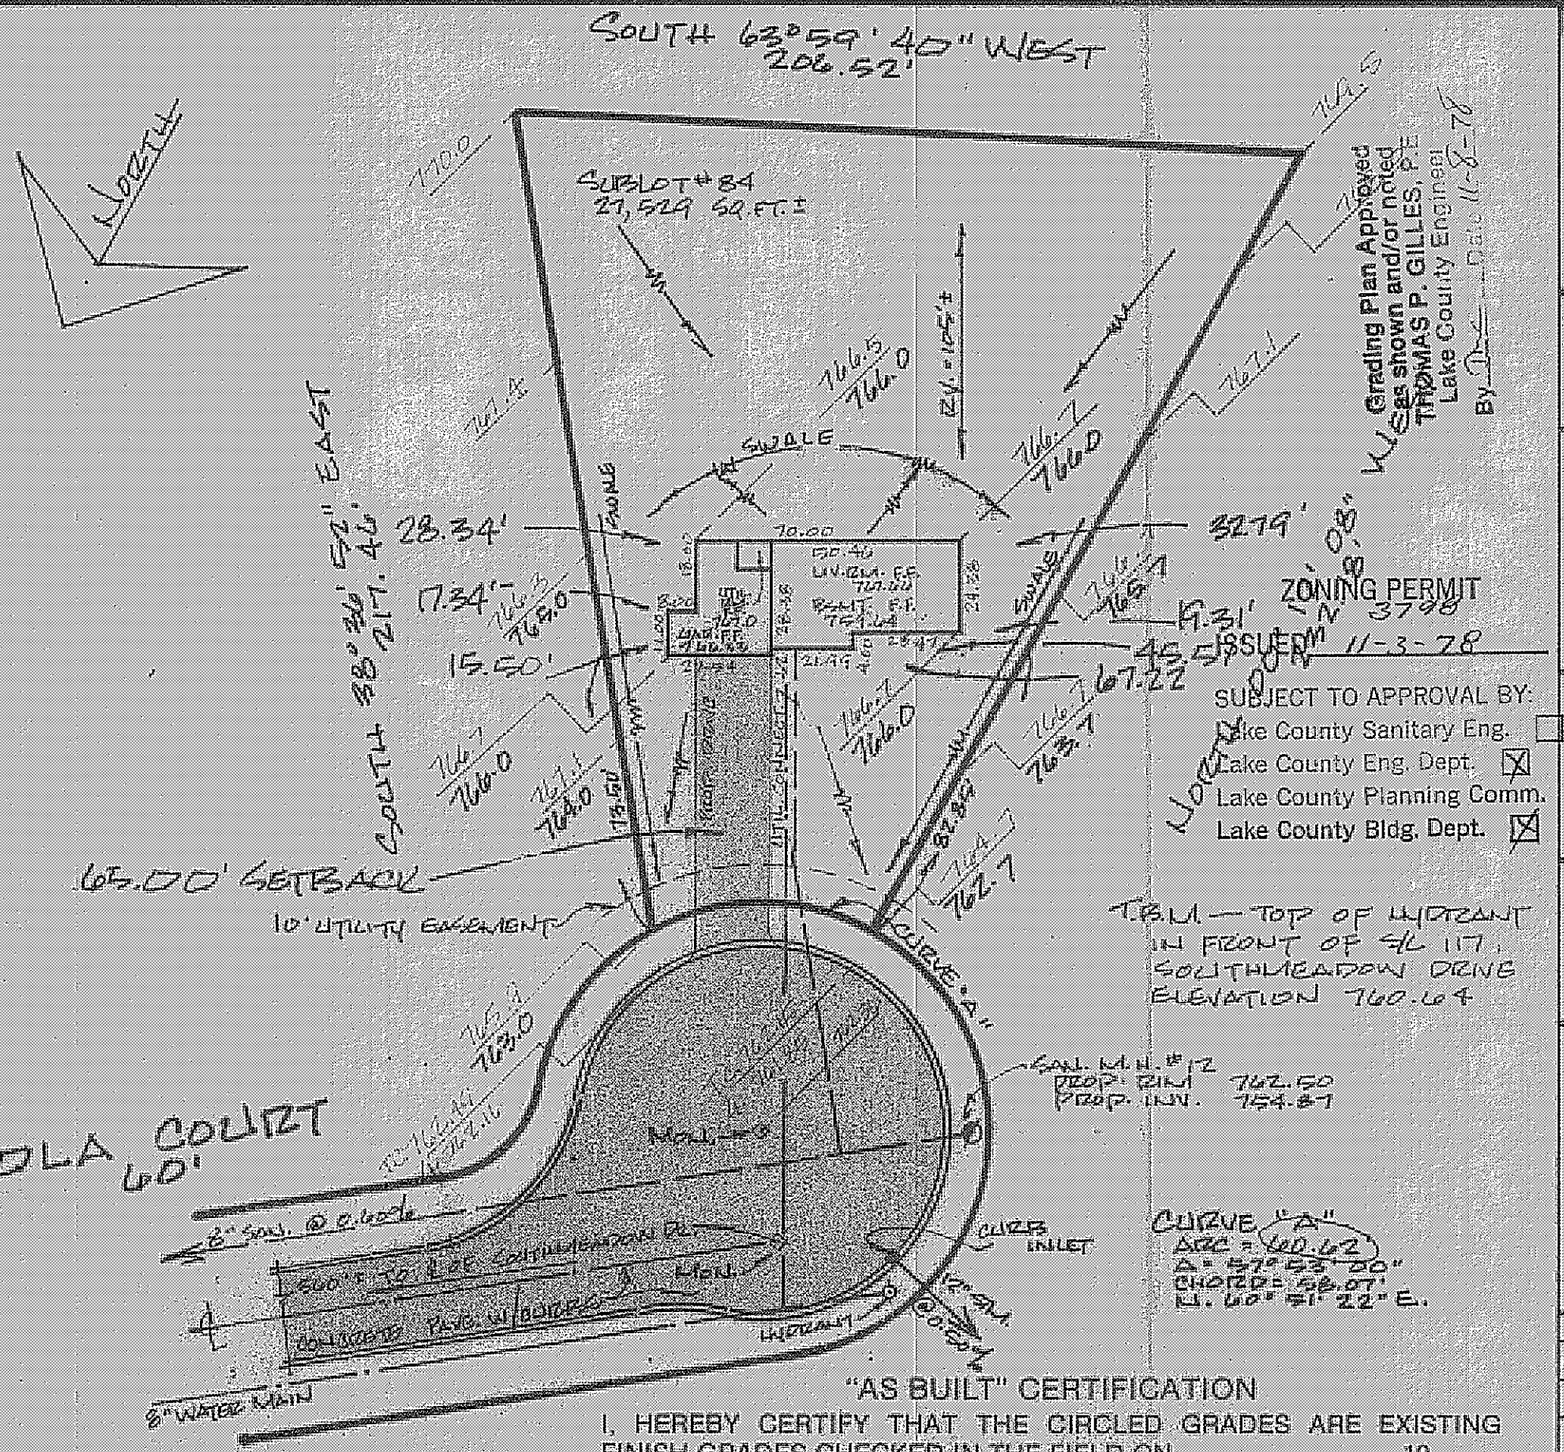
SOUTH 63°59'40" WEST
206.52'
SUBLOT # 84
27,529 SQ. FT. ±
SOUTH 88°39'52" EAST
217.45'
28.34'
17.34'
15.50'
SWALE
70.00
50.45
UNFIN. F.F. 767.20
BSMT. F.P. 757.44
21.49
4.00
13.00
8.00
13.00
8.00
13.00
8