SITE PLAN FOR:

RYAN HOMES

23600 MERCANTILE RD.
CLEVELAND, OHIO.

BEING SUBLOT NO. 24 IN THE VILLA RIO PARK SUBDIVISION IN CONCORD TWP.

PREPARED BY:

WM. R. GRAY ASSOC. INC.
7547 MENTOR AVENUE
MENTOR, OHIO 44060

DATE: JULY 18, 1975 SCALE: 1" = 20'

CERTIFICATION:

I HEREBY CERTIFY THAT THIS PLAT IS CORRECT TO THE BEST OF MY KNOWLEDGE.

BY: Wm. R. Gray.
WM. R. GRAY P.S. #2752

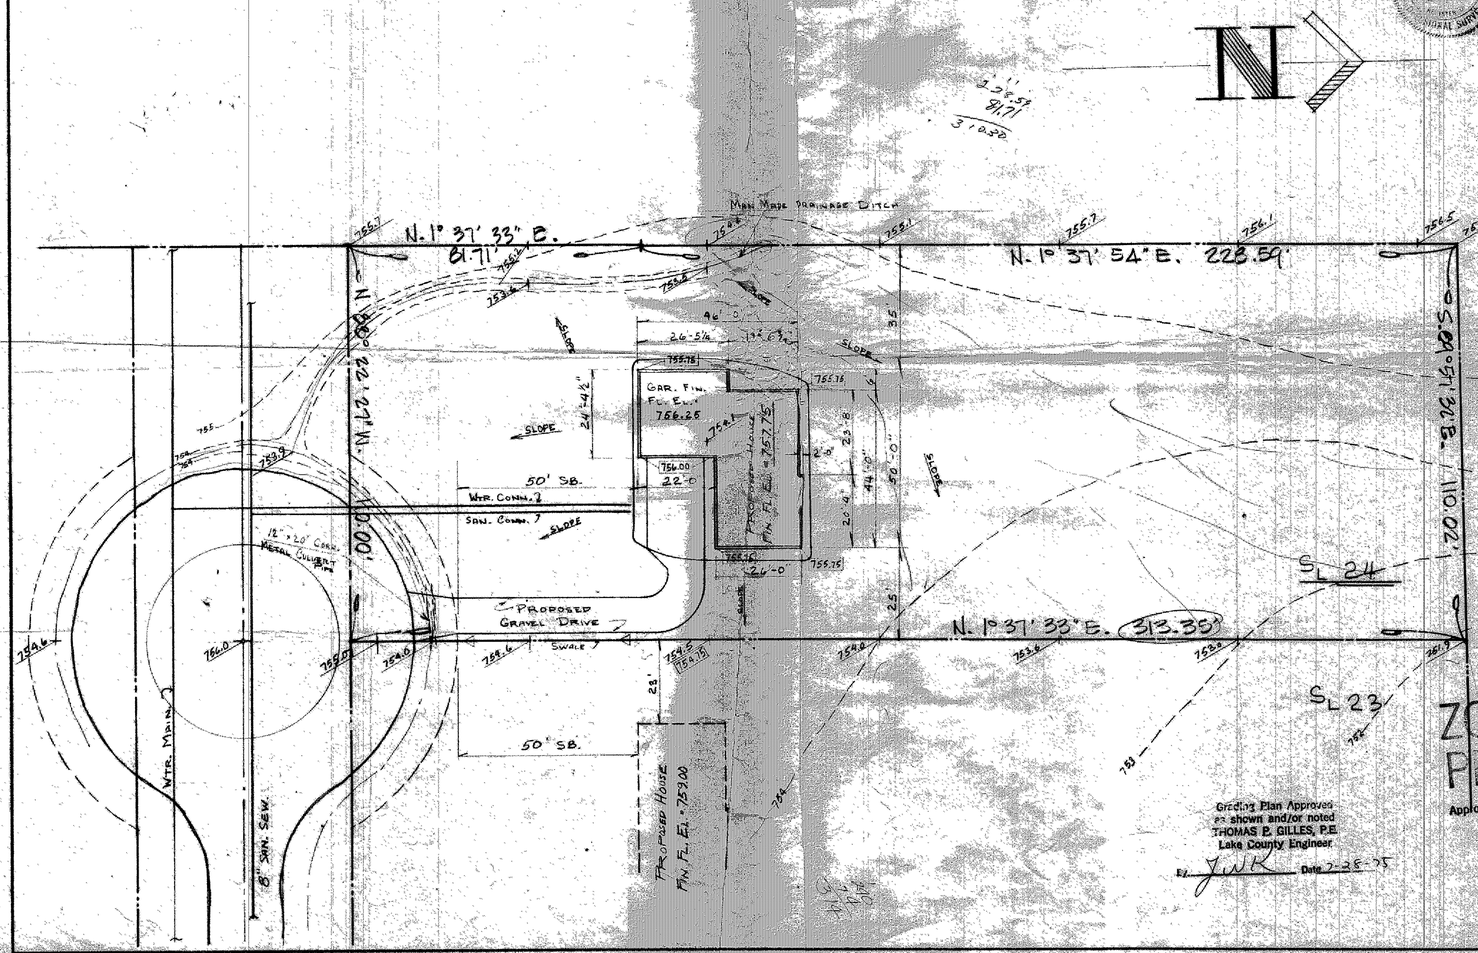

SITE PLAN FOR:

RYAN HOMES

23600 MERCANTILE RD.
CLEVELAND, OHIO.

BEING SUBLOT NO. 24 IN THE VILLA RIO PARK SUBDIVISION IN CONCORD TWP.

PREPARED BY:

WM. R. GRAY ASSOC. INC.
7547 MENTOR AVENUE
MENTOR, OHIO 44060

DATE: JULY 16 1975 SCALE: 1" = 20'
REV'D: OCT. - 1975

REVISED

Grading Plan Approved as shown and/or noted
THOMAS P. GILLES, P.E.
Lake County Engineer
By: JWR Date 10-5-75

CERTIFICATION:

I HEREBY CERTIFY THAT THIS PLAT IS CORRECT TO THE BEST OF MY KNOWLEDGE.

BY: Wm. R. Gray
WM. R. GRAY, P.S. #2752
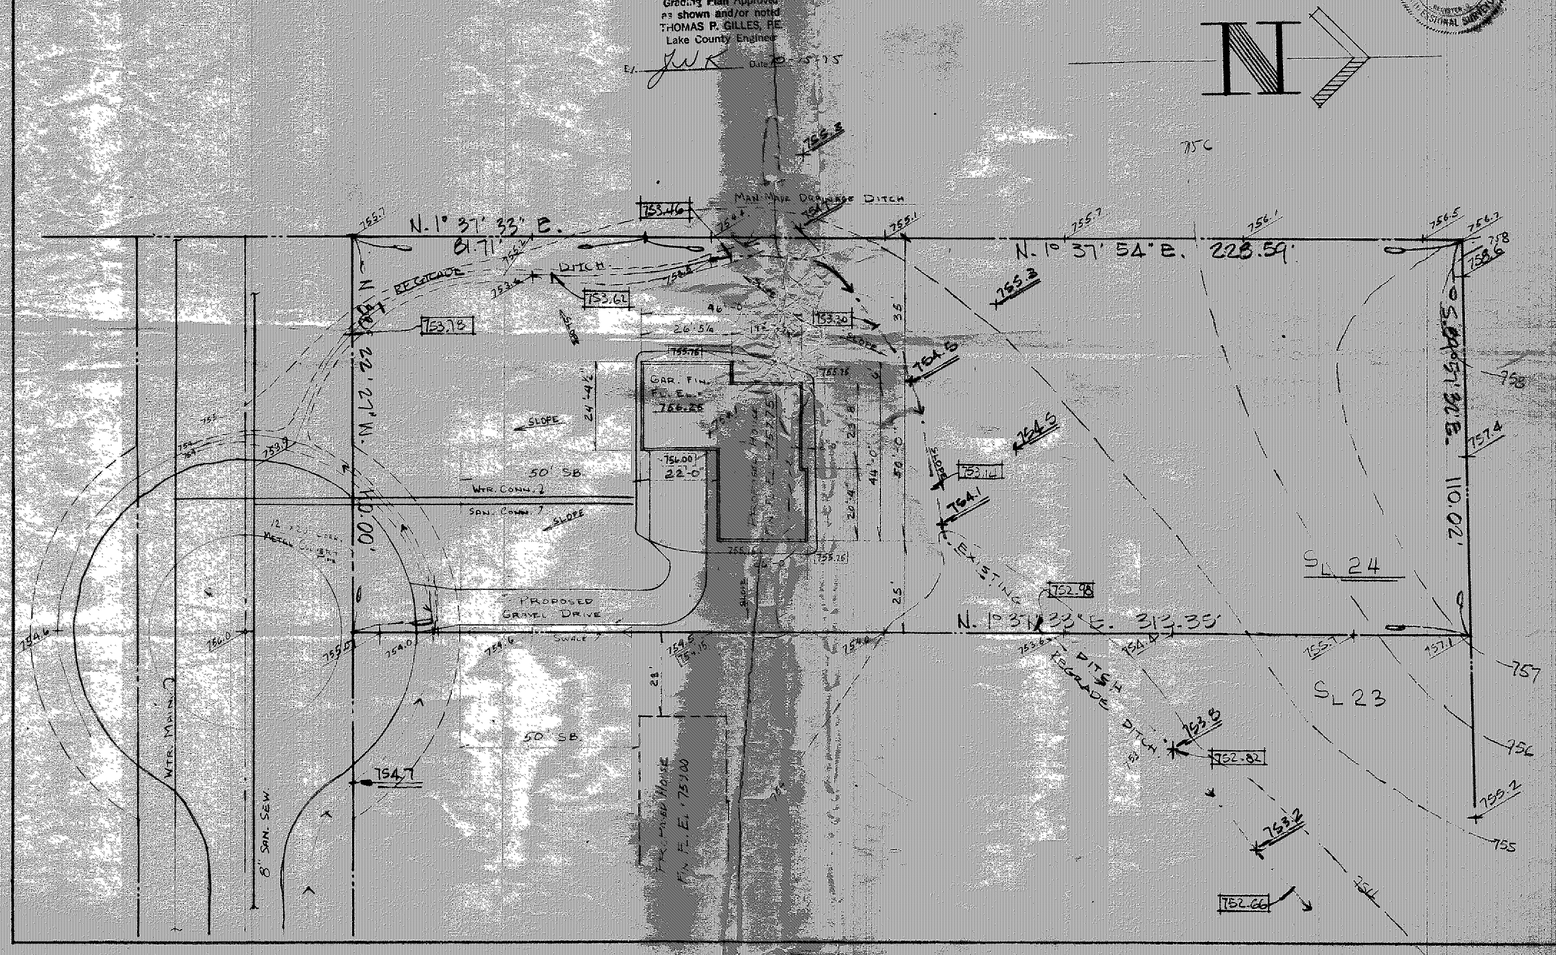
STATE OF OHIO
WM. R. GRAY
2752
REGISTERED
PROFESSIONAL SURVEYOR