SITE PLAN FOR

RYAN HOMES
23600 MERCANTILE
BEACHWOOD, OHIO
BEING SUBLOT NO 4 IN
THE MARTINIQUE ESTATES
SUBD. LOCATED IN CONCORD
TWP. OHIO.

PREPARED BY:

WM. R. GRAY ASSOC., INC.
7541 MENTOR AVE.
MENTOR, OHIO.
DATE: 6/23/75 SCALE 1" = 20'

CERTIFICATION:

I HEREBY CERTIFY
THAT THIS PLAT IS CORRECT
TO THE BEST OF MY KNOWLEDGE.

BY: Wm. R. Gray (COB)
WM. R. GRAY REG. SURV. # 2752

STATE OF OHIO
WM. R. GRAY
2752
REGISTERED
PROFESSIONAL SURVEYOR

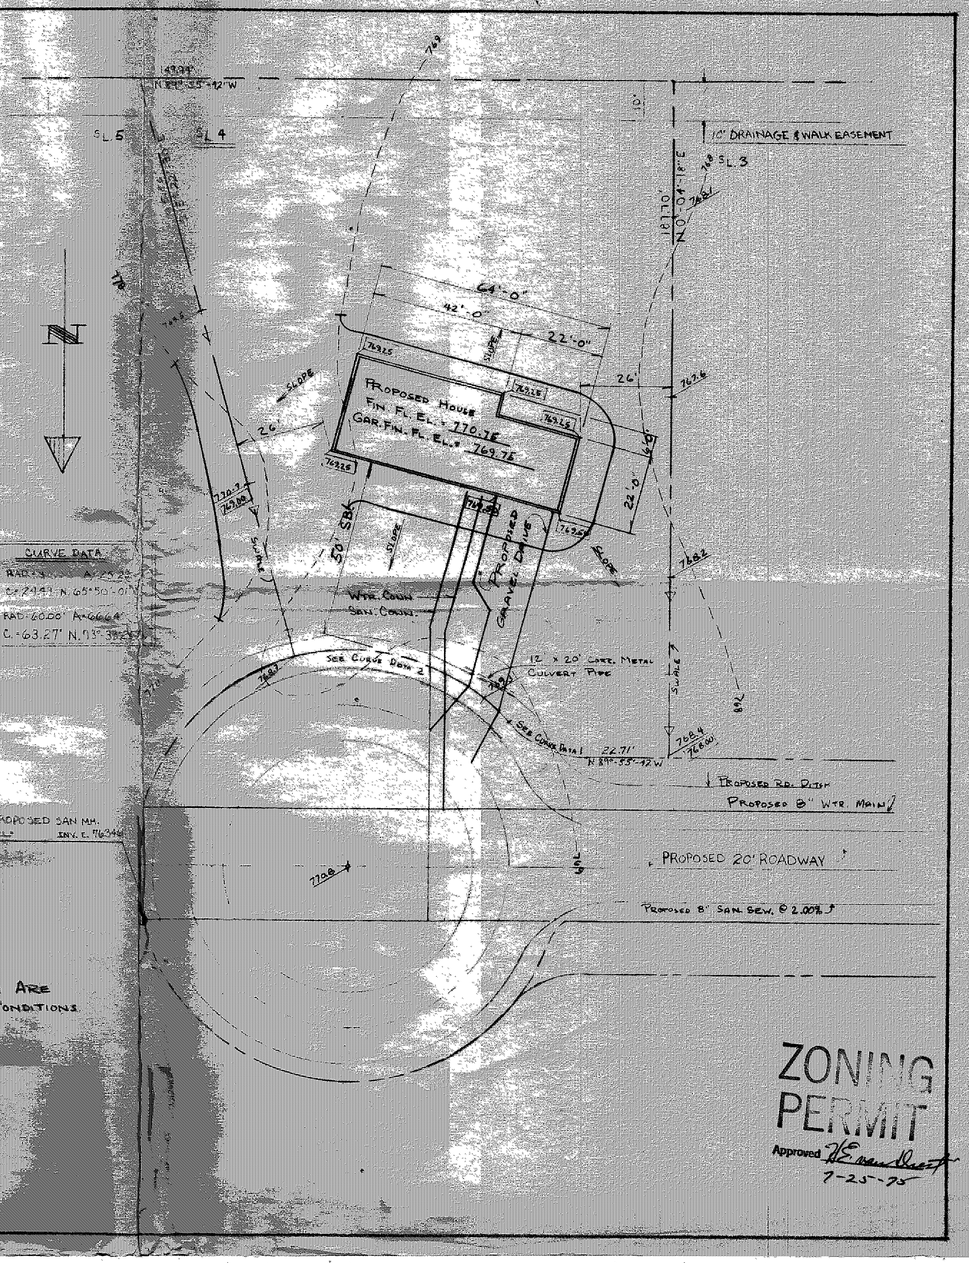

NOTE:
UTILITIES SHOWN ARE
SUBJECT TO AS-BUILT CONDITIONS.

ZONING PERMIT
Approved [signature]
7-25-75

SITE PLAN FOR

RYAN HOMES
23600 MERCANTILE
BEACHWOOD, OHIO
BEING SUBLOT NO. 4 IN
THE MARTINIQUE ESTATES
SUBD. LOCATED IN CONCORD
TWP., OHIO.

PREPARED BY:

WM. R. GRAY ASSOC. INC.
7734 MENTOR AVE.
MENTOR, OHIO
DATE 6/23/75 SCALE 1"=20'
REV'D. JULY 28, 1975

CERTIFICATION:

I HEREBY CERTIFY
THAT THIS PLAT IS CORRECT
TO THE BEST OF MY KNOWLEDGE.

BY: Wm. R. Gray (CDB)
WM. R. GRAY REG. NO. #2152

THE STATE OF OHIO
WM.
R.
GRAY
2752
REGISTERED
PROFESSIONAL SURVEYOR

TYPICAL RD. DITCH SECTION
NO SCALE

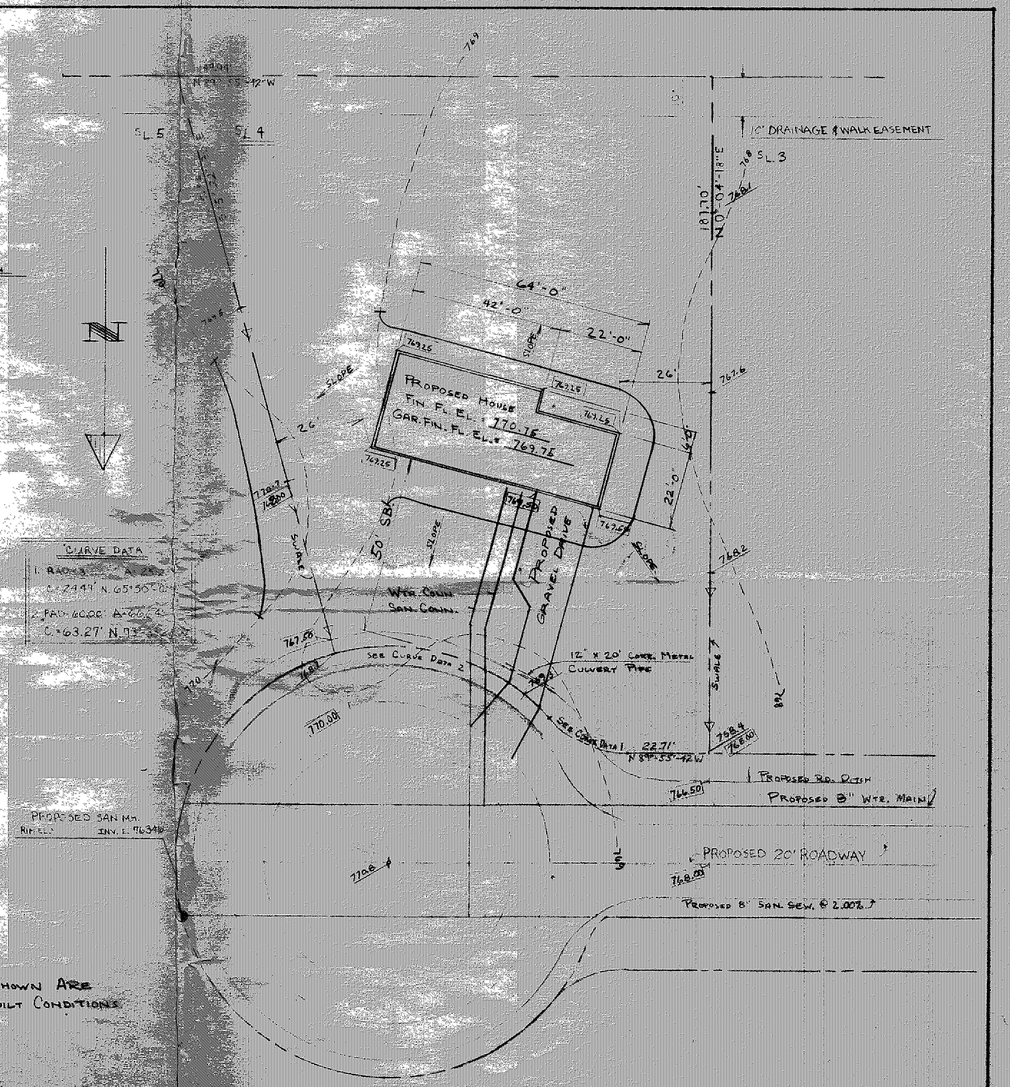

NOTE:
UTILITIES SHOWN ARE
SUBJECT TO AS-BUILT CONDITIONS.

REVISED
Grading Plan Approved
as shown and/or noted
THOMAS P. GILLES, P.E.
Lake County Engineer
By JWK Date 7-29-75