SITE PLAN FOR:

RYAN HOMES
23600 MERCANTILE RD.
BEACHWOOD, OHIO

BEING SUBLOT NO. 13 IN THE VILLA RIO PARK SUBD. LOCATED IN CONCORD TWP., OHIO.

PREPARED BY:

WM. R. GRAY ASSOC. INC.
7547 MENTOR AVE.
MENTOR, OHIO
DATE: JUNE 16, 1975 SCALE: 1" = 20'

Zoning Permit # 2848
issued 6-18-75
[illegible]

CERTIFICATION:

I HEREBY CERTIFY THAT THIS PLAT IS CORRECT TO THE BEST OF MY KNOWLEDGE.

BY: Wm. R. Gray
WM. R. GRAY REG. SURV. # 2752

STATE OF OHIO
WM. R. GRAY
2752
REGISTERED PROFESSIONAL SURVEYOR

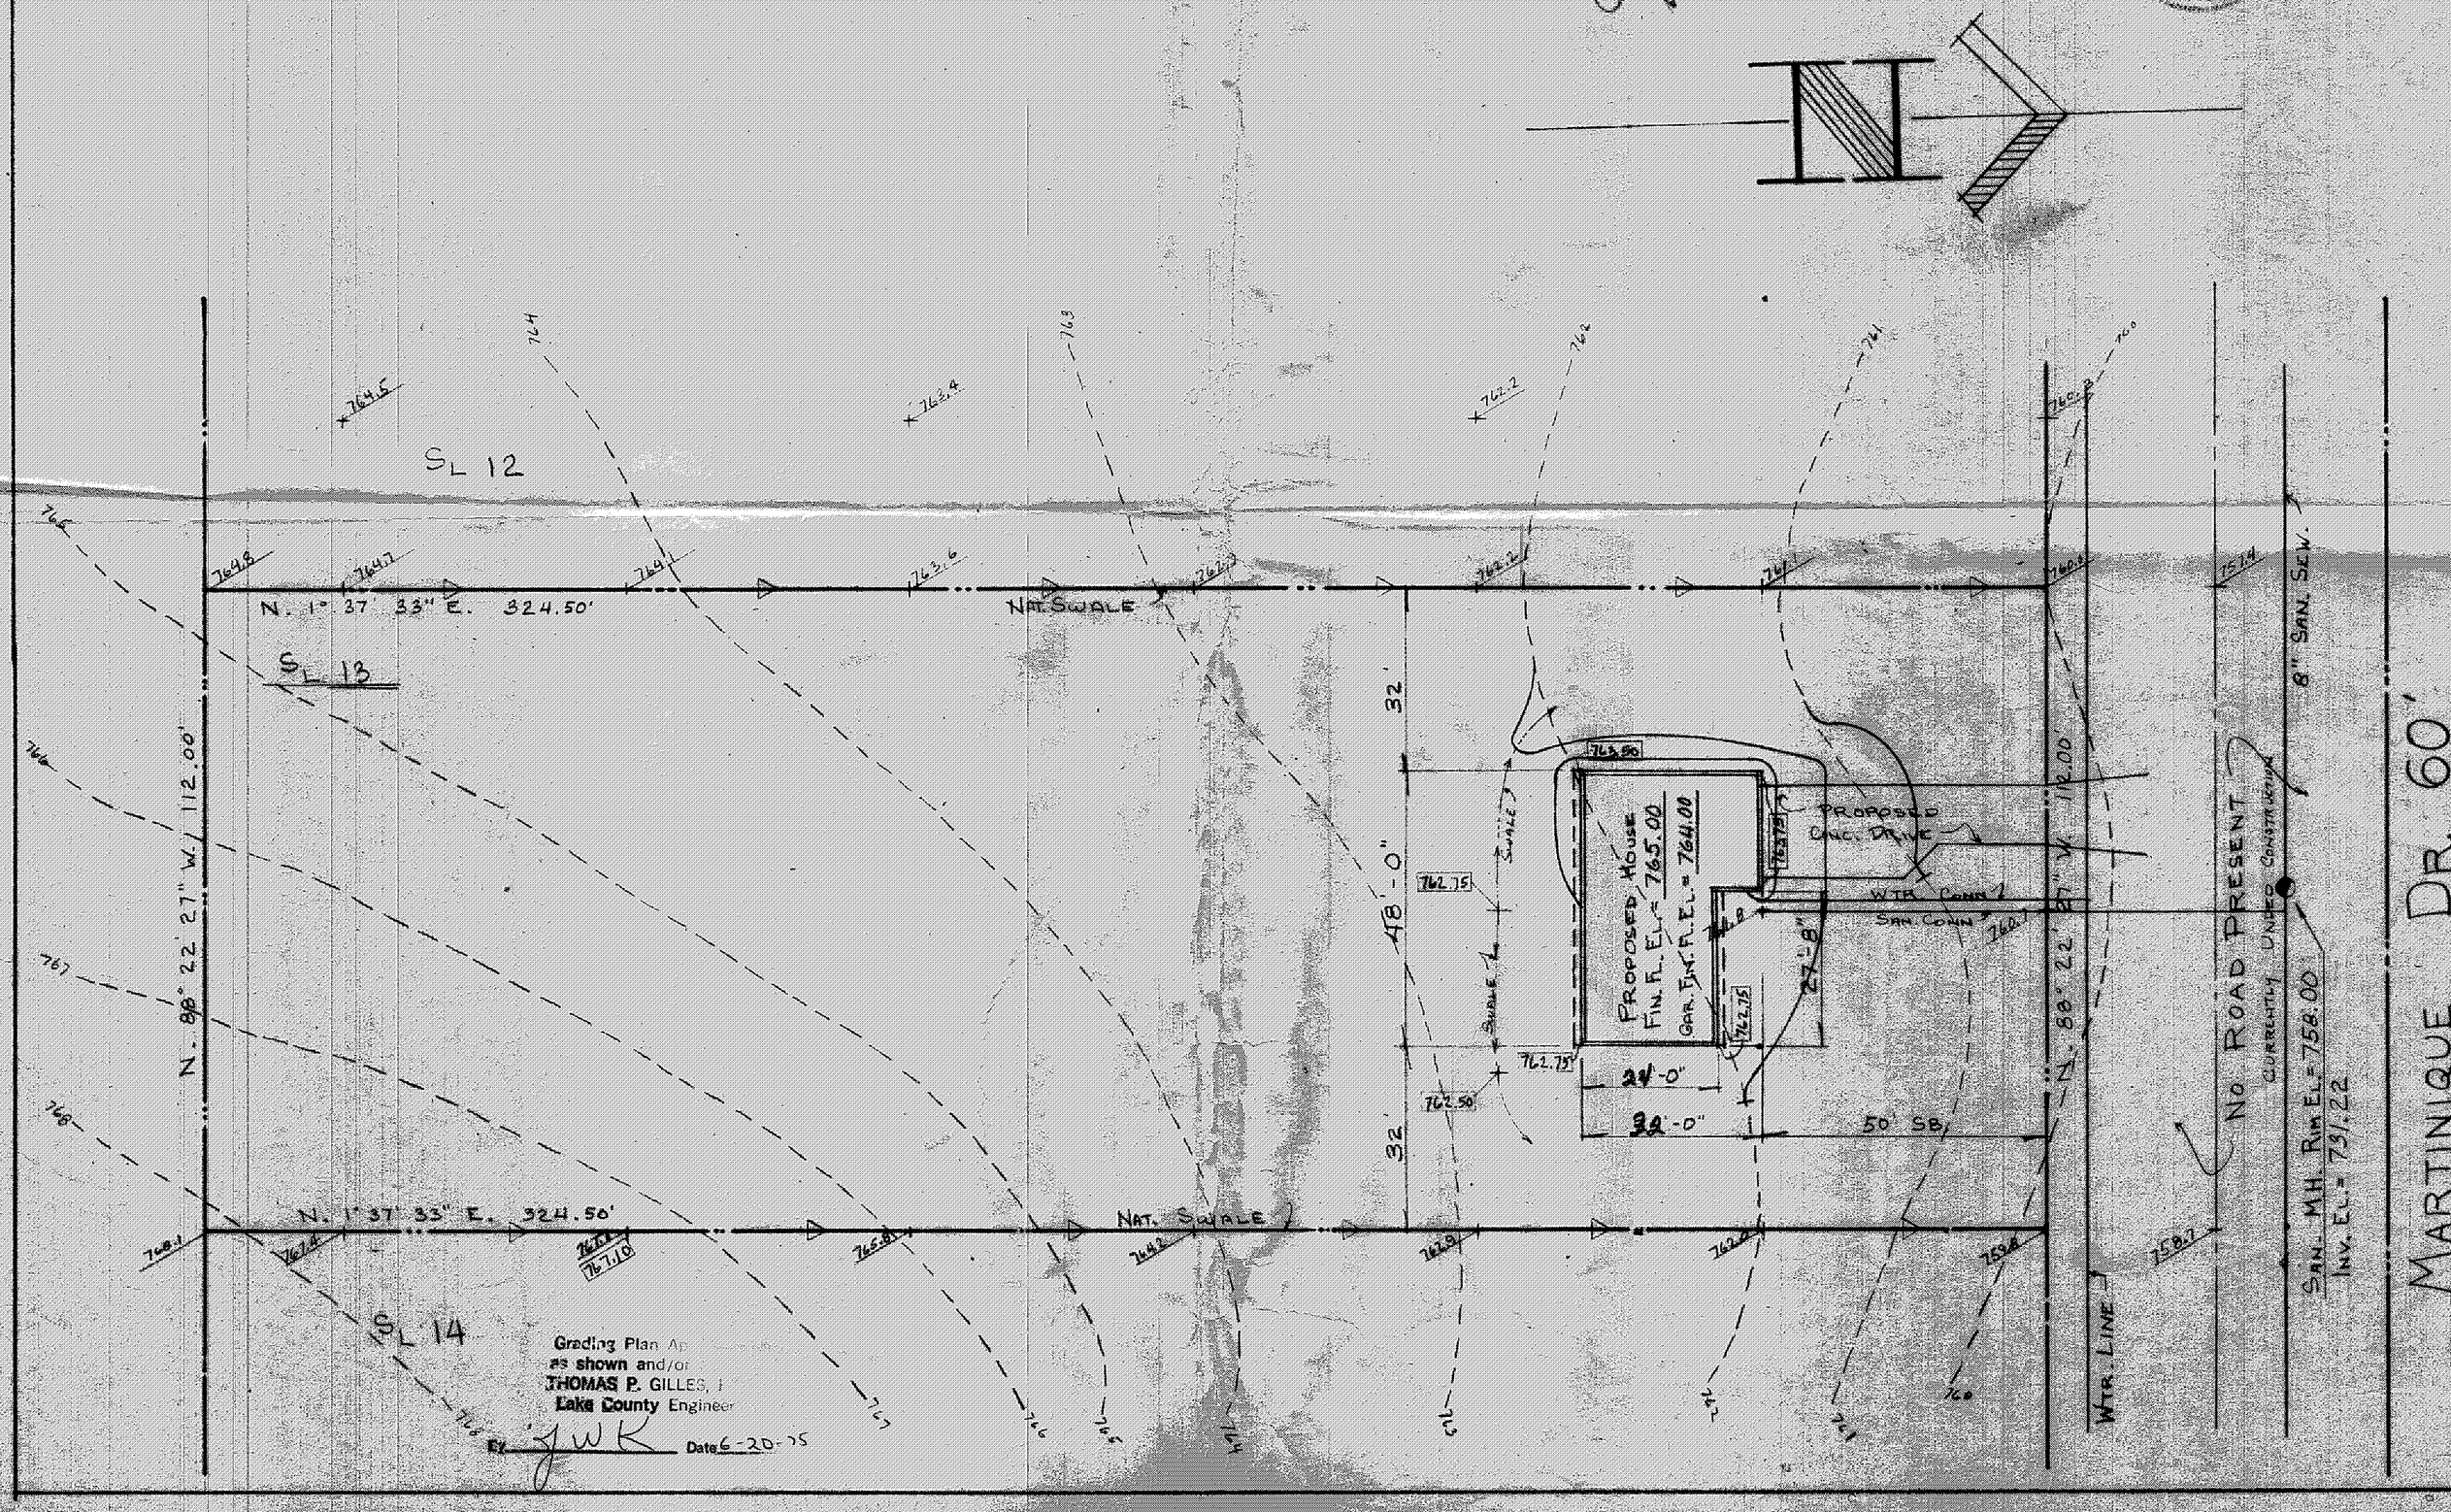

Grading Plan Ap[illegible]
as shown and/or
THOMAS P. GILLES, [illegible]
Lake County Engineer
By JWK Date 6-20-75