SITE PLAN FOR:

RYAN HOMES

23600 MERCANTILE RD.

BEACHWOOD, OHIO

BEING SUBLOT NO. 17 IN THE VILLA RIO PARK SUBDIVISION LOCATED IN CONCORD TWP., OHIO.

PREPARED BY:

WM. R. GRAY ASSOC. INC.

7547 MENTOR AVE.

MENTOR, OHIO

DATE: JULY 7, 1975 SCALE: 1" = 20'

CERTIFICATION:

I HEREBY CERTIFY THAT THIS PLAT IS CORRECT TO THE BEST OF MY KNOWLEDGE.

BY: Wm. R. Gray

WM. R. GRAY REG. SURV. # 2752

STATE OF OHIO WM. R. GRAY 2752 REGISTERED PROFESSIONAL SURVEYOR

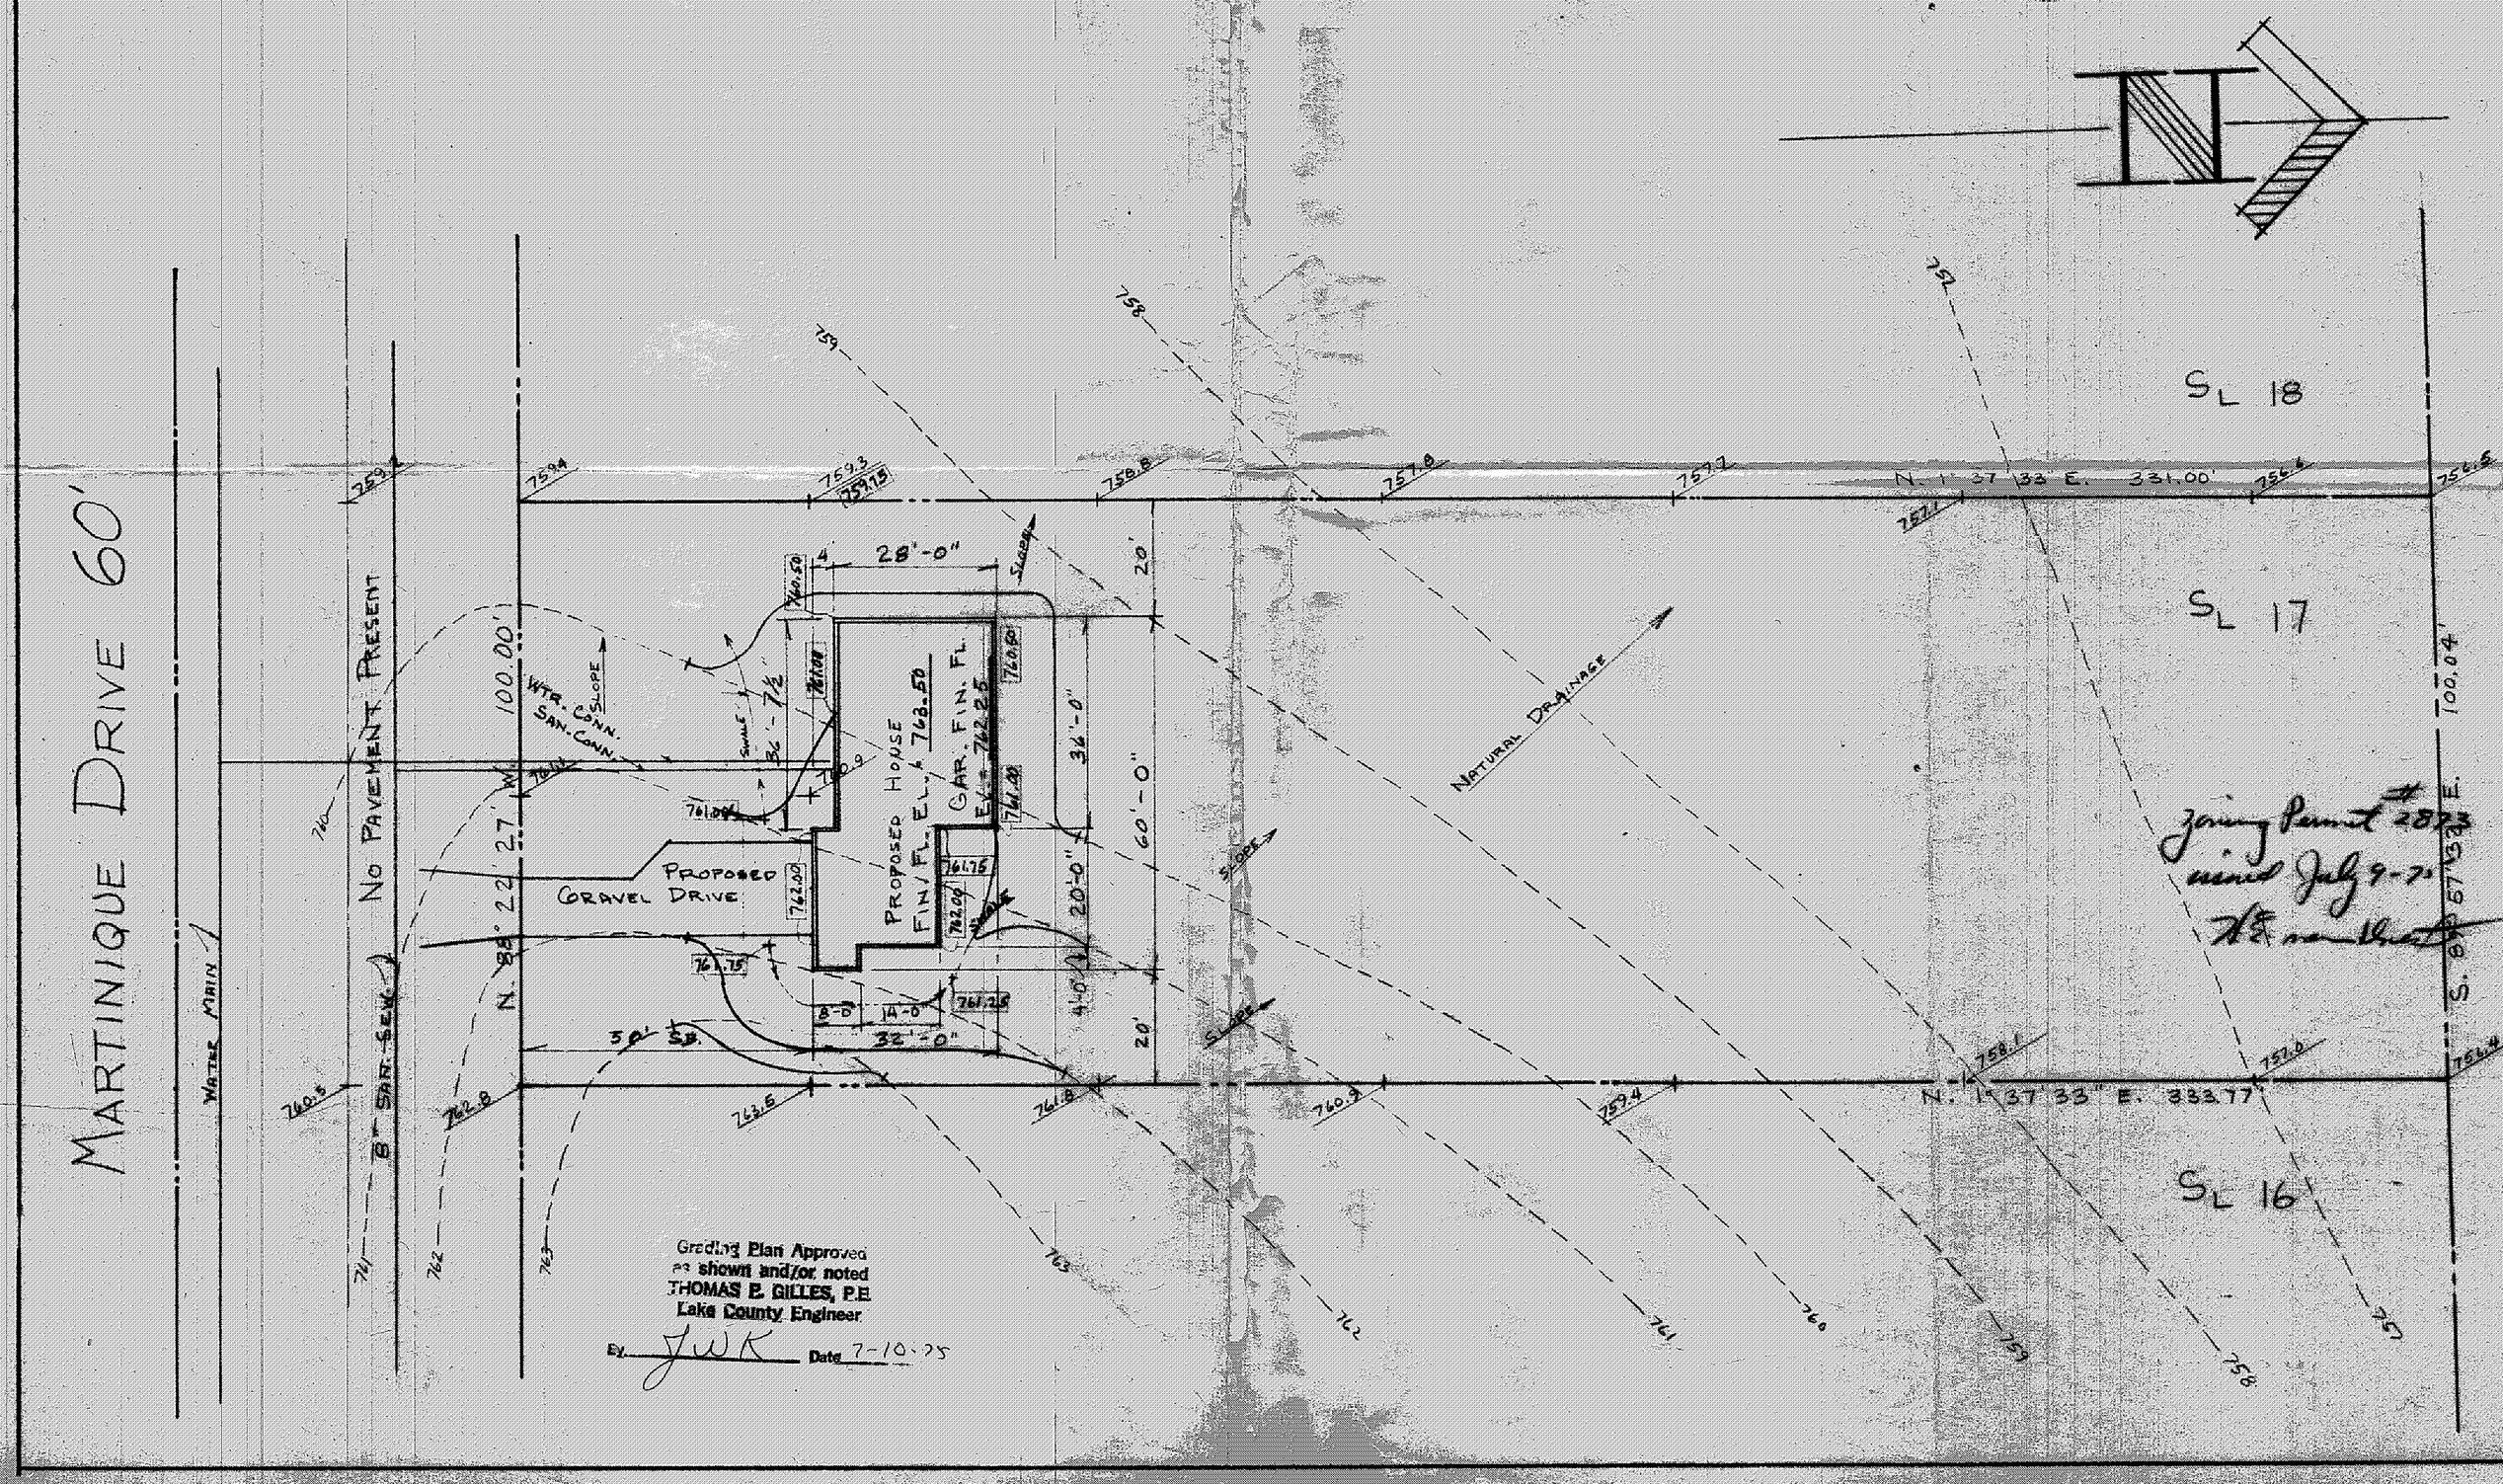

Grading Plan Approved as shown and/or noted
THOMAS E. GILLES, P.E.
Lake County Engineer
By JWK Date 7-10-75