Zoning Permit # 2525
issued 7-19-73
N.E. now Rich. 119-94.

Grading Plan Approved as shown and/or noted
THOMAS P. GILLES, P.E.
Lake County Engineer
D.T.L. 9/14/73

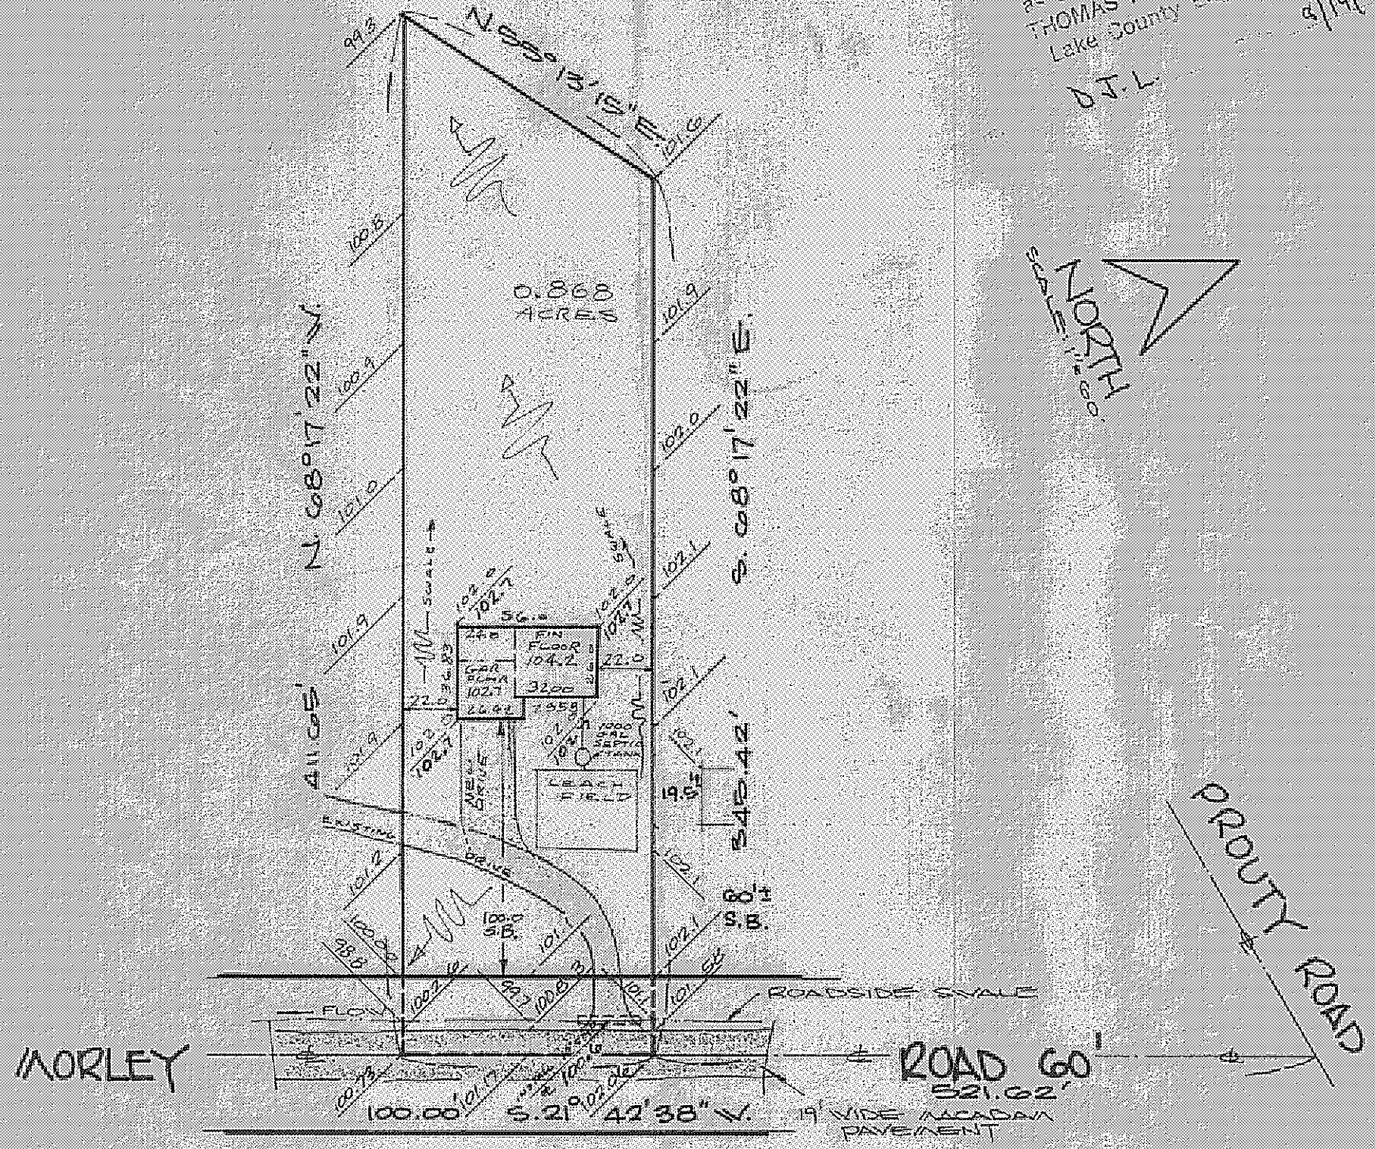

NORTH
SCALE: 1" = 60'

SITE PLAN

CONCORD TOWNSHIP LAKE COUNTY, OHIO

for RICHARD KOVACH
CLIENT OWNER

ADDRESS STREET CITY ZIP

SUBDIVISION — LOT No. 35 — TRACT No. 4
SUBLOT NO. — PARCEL NO. — VOLUME — PAGE
NOT TRANSFERRED
PERM. PARCEL 33
TRACT — STREET
MORLEY RD. STREET

LEGEND

SANITARY MANHOLE
STORM MANHOLE
INLET OR CATCH BASIN
HYDRANT
EXISTING CONTOURS
PROPOSED CONTOURS
EXIST ELEV 100.0 PROP ELEV. 100.0
WATER VALVE (GAS)
WATER METER (GAS)
AS BUILT ELEVATION 100.0
INDICATES DIRECTION OF SURFACE DRAINAGE

REMARKS

ALL BOUNDARY DATA SHOWN WAS OBTAINED FROM (DEEDS RECORDED SUBDIVISION PLAT, OR OTHER PUBLIC RECORDS)

DESIGN CERTIFICATION

THIS PLAT WAS PREPARED BY ME, AND IS CORRECT TO THE BEST OF MY KNOWLEDGE AND BELIEF

Richard Kovach PS #5244
NAME SURVEYOR REGISTRATION NO.

CHECK LIST

DIMENSIONS
BEARINGS
TIE TO NEAREST STREET
SUBLOT NO. PARCEL NO.
SUBDIVISION NO. OWNERS
BLDG DIMENSIONS F.N. GR.
BLDG TIES BLDG GRADES
APRON TYPE WIDTH THICKNESS
SIDEWALK TYPE WIDTH THICKNESS
CULVERT TYPE DIA LENGTH
WATER MAIN SIZE LOCATION
SAN SEWER SIZE % GR LOC.
SAN M.H. CAST ELEV INV. ELEV
SAN CONN SIZE LOC DEPTH
STORM SEWER SIZE % GR LOC
STORM M.H. CAST ELEV INV ELEV
PAVT TYPE GRADE CURBS
GAS LINE SIZE PRESSURE
SEPTIC TANK SIZE LOC
WELL LOCATION

"AS BUILT" CERTIFICATION

I HEREBY CERTIFY THAT THE CIRCLED GRADES ARE EXISTING FINISH GRADES CHECKED IN FIELD ON _____ 19__ BY SURVEYING AND ARE CORRECT TO THE BEST OF MY KNOWLEDGE AND BELIEF

REGISTERED SURVEYOR NO.

REVISIONS		
NO.	DATE	BY
1	6-2-73	RJB
2		
3		
4		
5		

PLAN PREPARED BY:
DEBEVEC-SALO & ASSOC., INC.
NAME
130 E. JACKSON ST. PAINESVILLE, O.
ADDRESS

DRAWN BY AG	SCALE 1" = 60'	
CHK'D RJB	DATE 5/24/73	DRAWING NO. 3939
CREW CHIEF	APP'D	