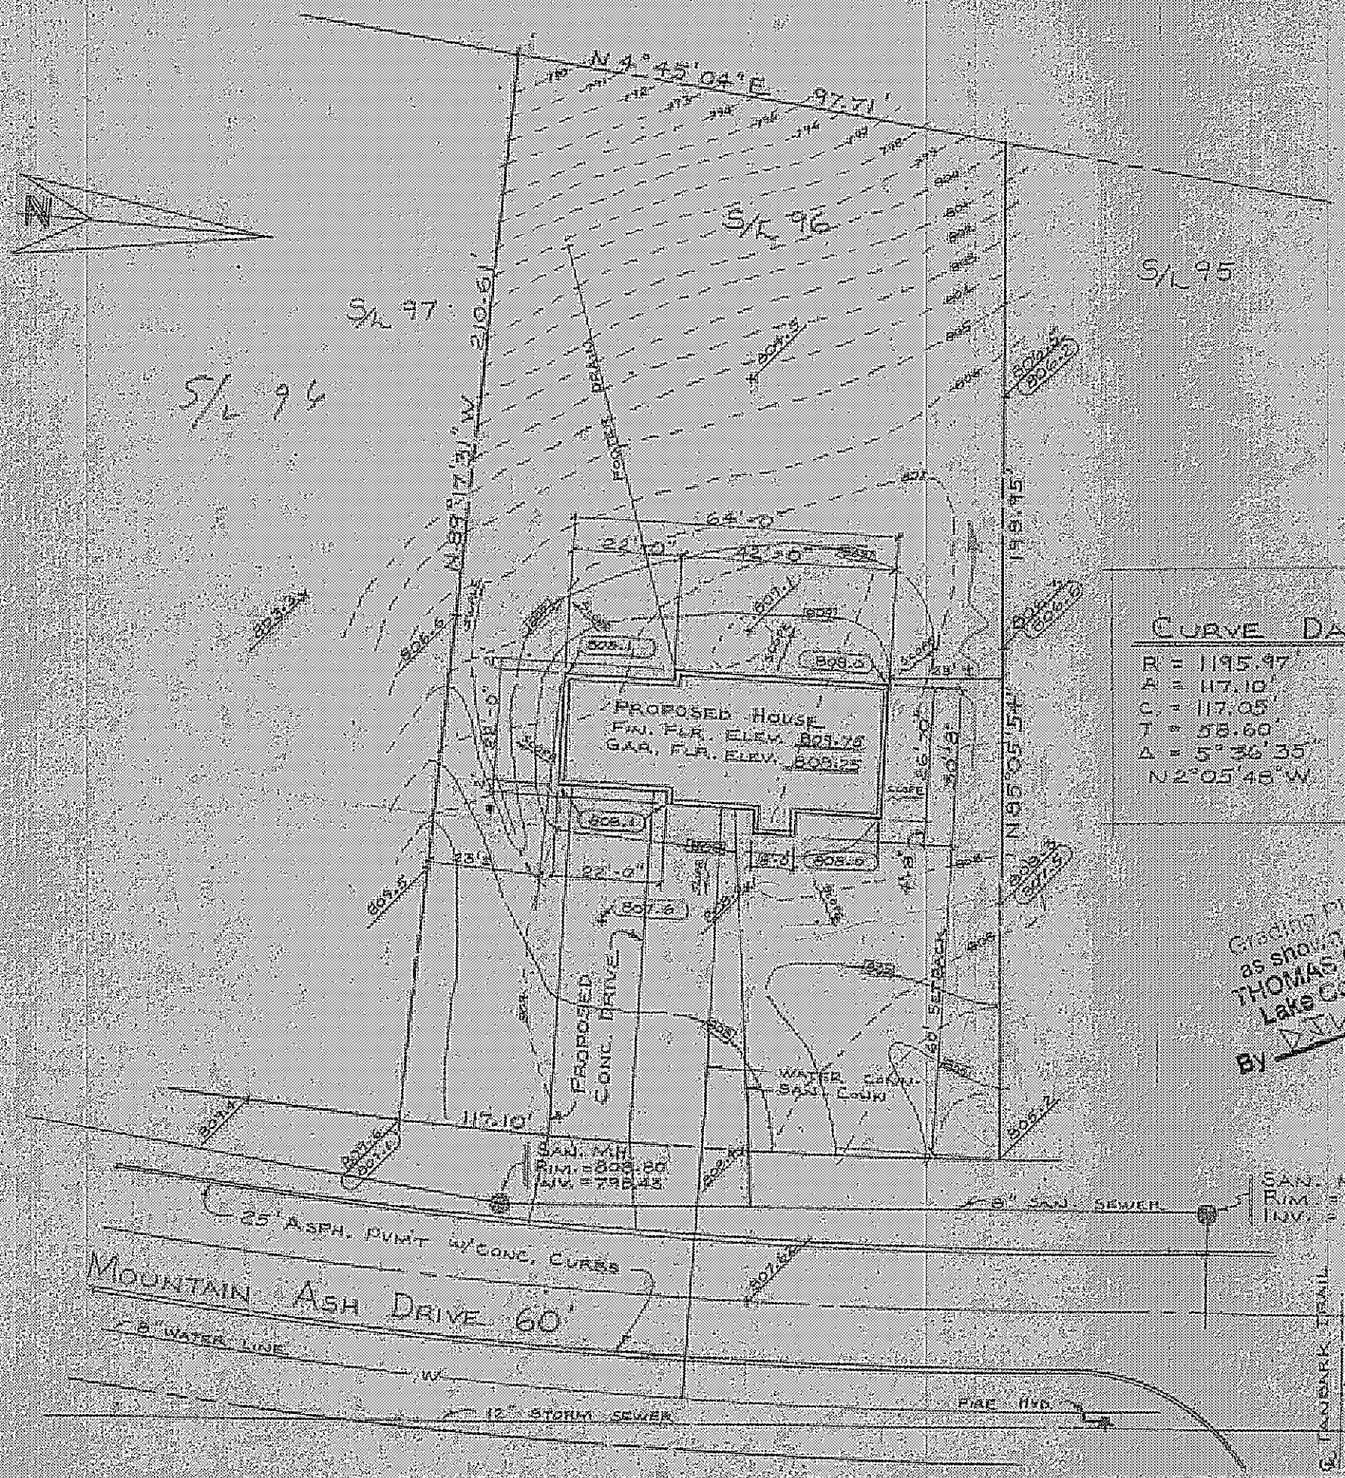

Curve Data

R = 1195.97'
A = 117.10'
C = 117.05'
T = 58.60'
Δ = 5°36'35"
N 2°05'48" W

Grading Plan Approved as shown and/or noted
THOMAS P. GILLES, P.E.
Lake County Engineer
By _____ Date 5/5/77

Site Plan For :

Shandle Construction
8353 Mentor Avenue
Mentor, Ohio

Being Sublot Number 96 In The Morley Hills Estates Subdivision No. 3 In Concord Township, Lake County, Ohio.

Prepared By :

Wm. R. Gray Assoc. Inc.
7547 Mentor Avenue
Mentor, Ohio

Scale : 1" = 30'
Date : May 2, 1977

Certification :

I Hereby Certify That This Plat Is Correct To The Best Of My Knowledge.

By : _____
Wm. R. Gray Reg. Surv. #2752

ZONING PERMIT

A3242

Approved 5-4-77
H.E. na Street