7820 Mountain Ash

SITE PLAN FOR:

SHANDLE CONSTRUCTION
8353 MENTOR AVE
MENTOR, OHIO
BEING SUBLOT No 108 IN THE
MORLEY HILLS ESTATES
SUBDIVISION No 3 IN CONCORD, OHIO

1ST FL 1178
2nd FL 974
GARAGE 484

Grading Plan Approved
as shown and or noted
THOMAS P. MILES, P.E.
Lake County Engineer
By ____ Date 3 MAY 78

PREPARED BY:

WM R GRAY ASSOC. INC.
7547 MENTOR AVE
MENTOR, OHIO
SCALE: 1"=30'
DATE: MAY 8, 1978

CERTIFICATION:

I HEREBY CERTIFY THAT
THIS PLAT IS CORRECT TO THE
BEST OF MY KNOWLEDGE
BY: Wm. R Gray
WM. R GRAY REG SURV #2752
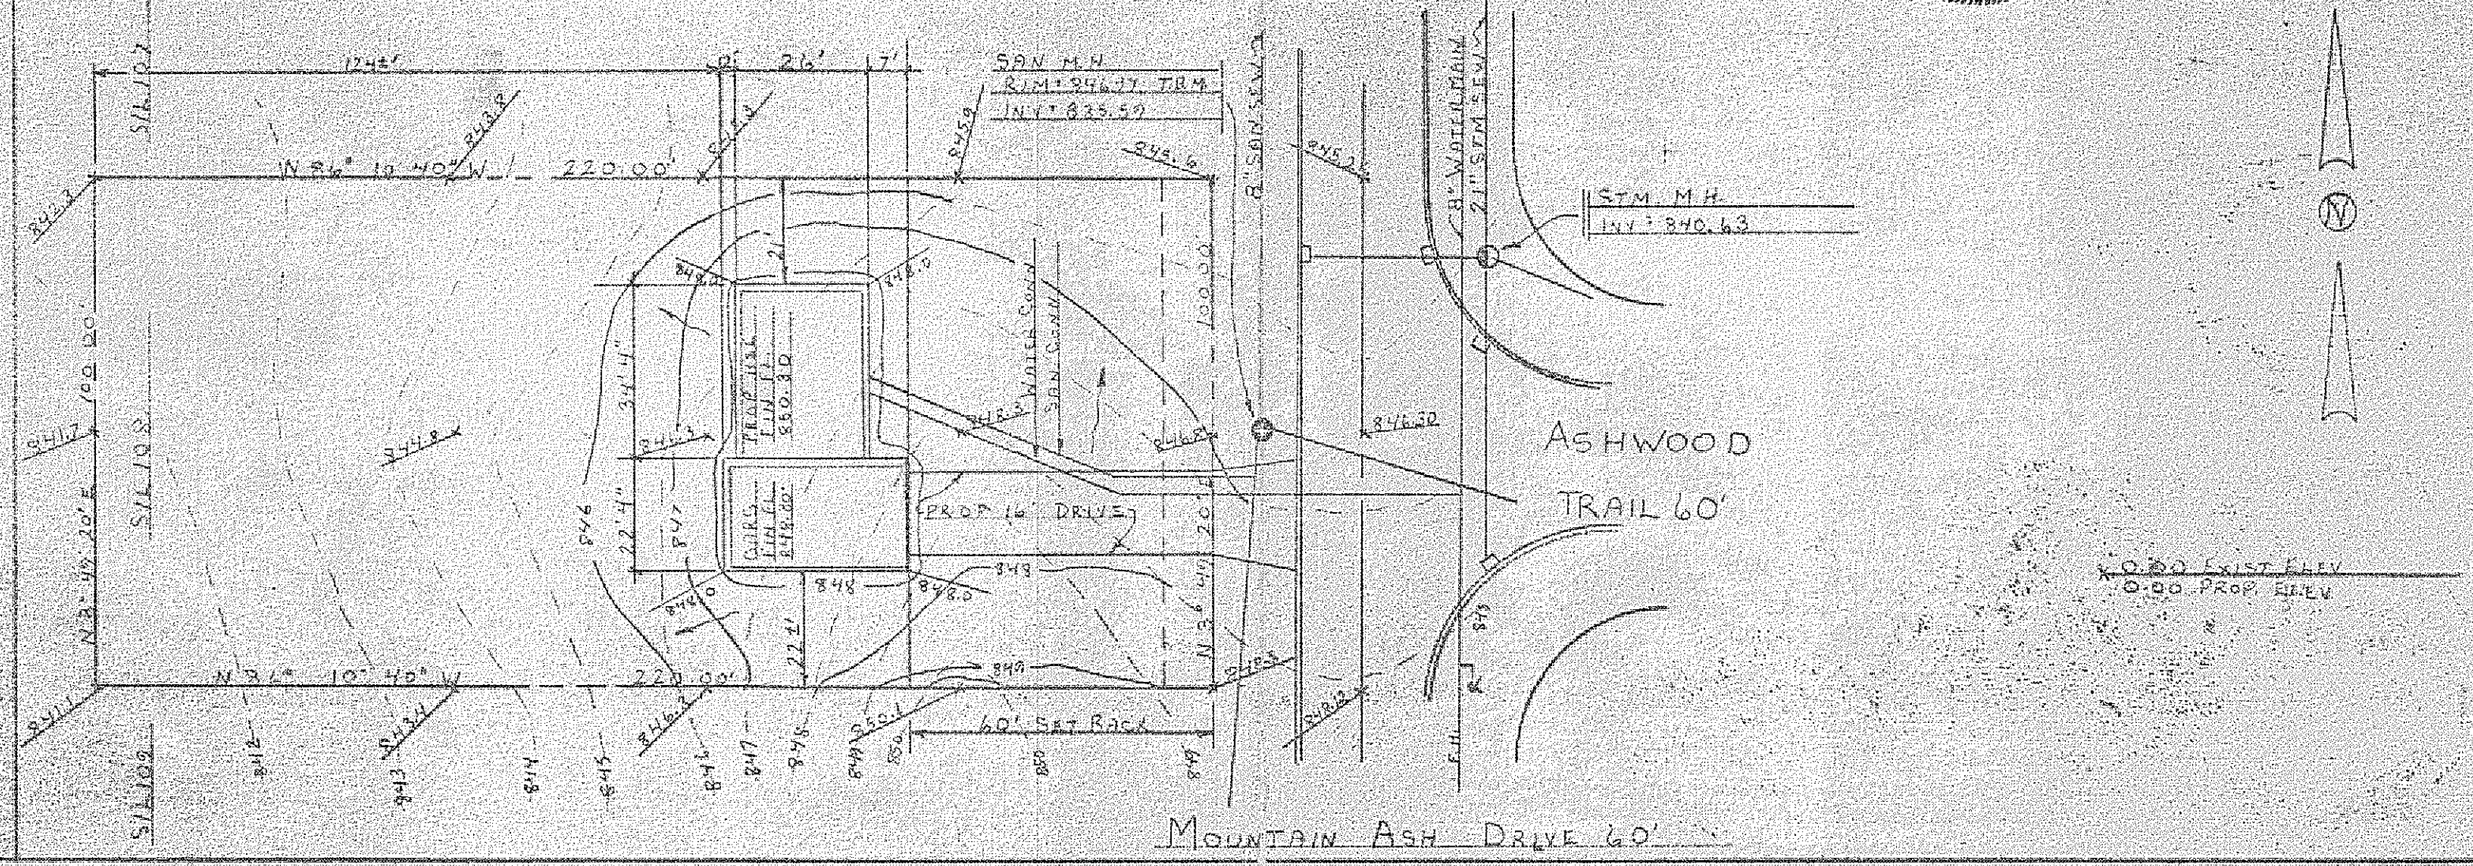
STATE OF OHIO
WM. R. GRAY
2752
REGISTERED
PROFESSIONAL SURVEYOR