SITE PLAN FOR:

SHANDLE CONSTRUCTION
8353 MENTOR AVE
MENTOR, OHIO
BEING SUBLOT No. 156 IN MORLEY HILLS ESTATES SUBDIVISION No. 3
IN CONCORD, OHIO

Grading Plan Approved as shown and/or noted
THOMAS P. GILLES, P.E.
Lake County Engineer
By [signature] Date 10-4-77

PREPARED BY:

WM GRAY ASSOC INC
7547 MENTOR AVE
MENTOR, OHIO
SCALE: 1" = 30'
DATE: AUG. 18, 1977

CERTIFICATION:

I HEREBY CERTIFY THAT THIS PLAT IS CORRECT TO THE BEST OF MY KNOWLEDGE
BY: Wm. R. Gray
WM. R. GRAY REG. SURV. # 2752

STATE OF OHIO
WM. R. GRAY
2752
REGISTERED PROFESSIONAL SURVEYOR

House # 7701

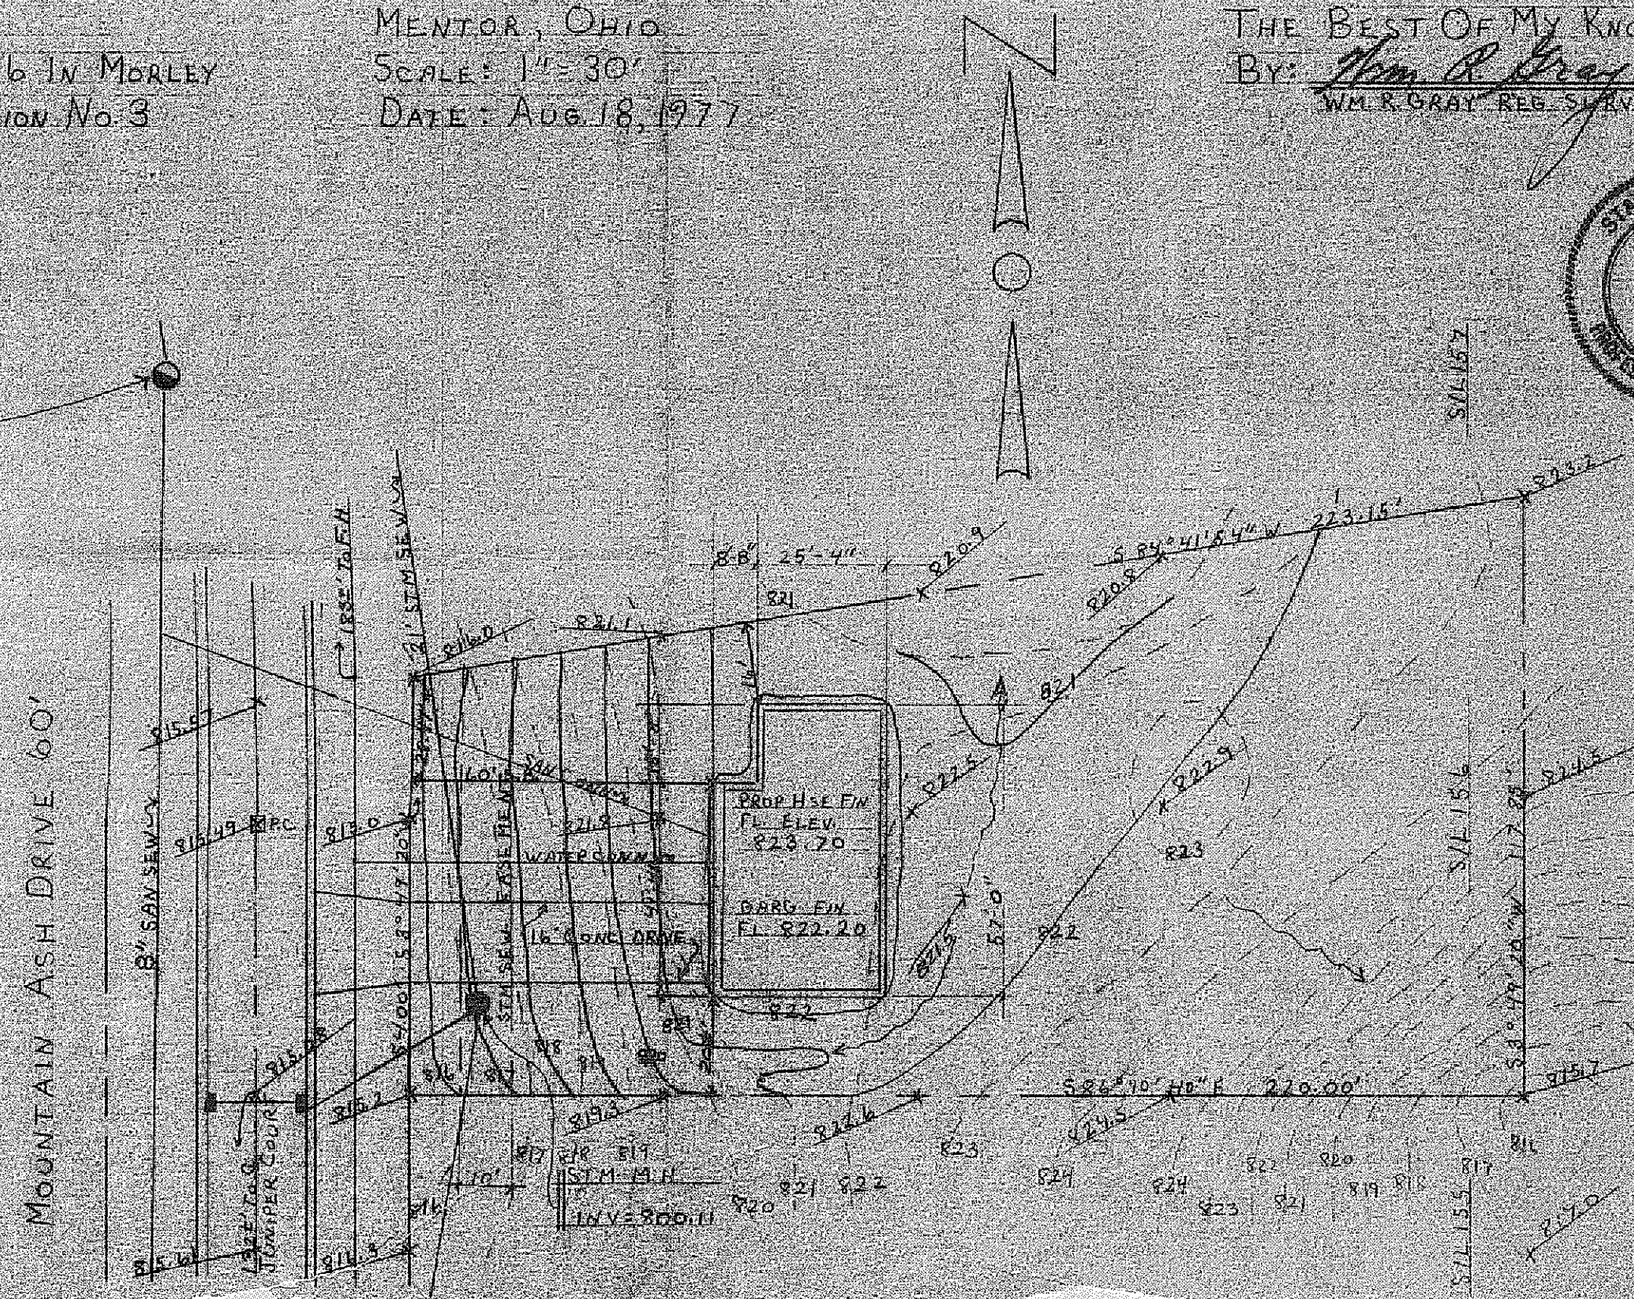

* CURVE DATA
R = 1255.97'
A = 28.47'
C = 28.47'
T = 14.23'
Δ = 1°17'55"
S 3°10'22" W

ZONING PERMIT

3412

Approved 8-31-77
[signature]