PLOT PLAN

for RICHARD PAVLISIN

OF SUBLOT Nº 101 IN MORLEY HILLS ESTATES

SUBDN. Nº 3, VOL. V, PG. 36, IN THE TOWNSHIP OF

SCALE: 1" = 30' CONCORD NOVEMBER, 1977

FRANK A. THOMAS & ASSOC, INC.

CONSULTING ENGINEERS

NOTES:

1. PROP. / EXIST. GROUND GRADES
2. OVERLAND DRAINAGE
3. BENCHMARK: TOP OF HYD. IN FRONT OF SL Nº 104 ELEV. 843.18.

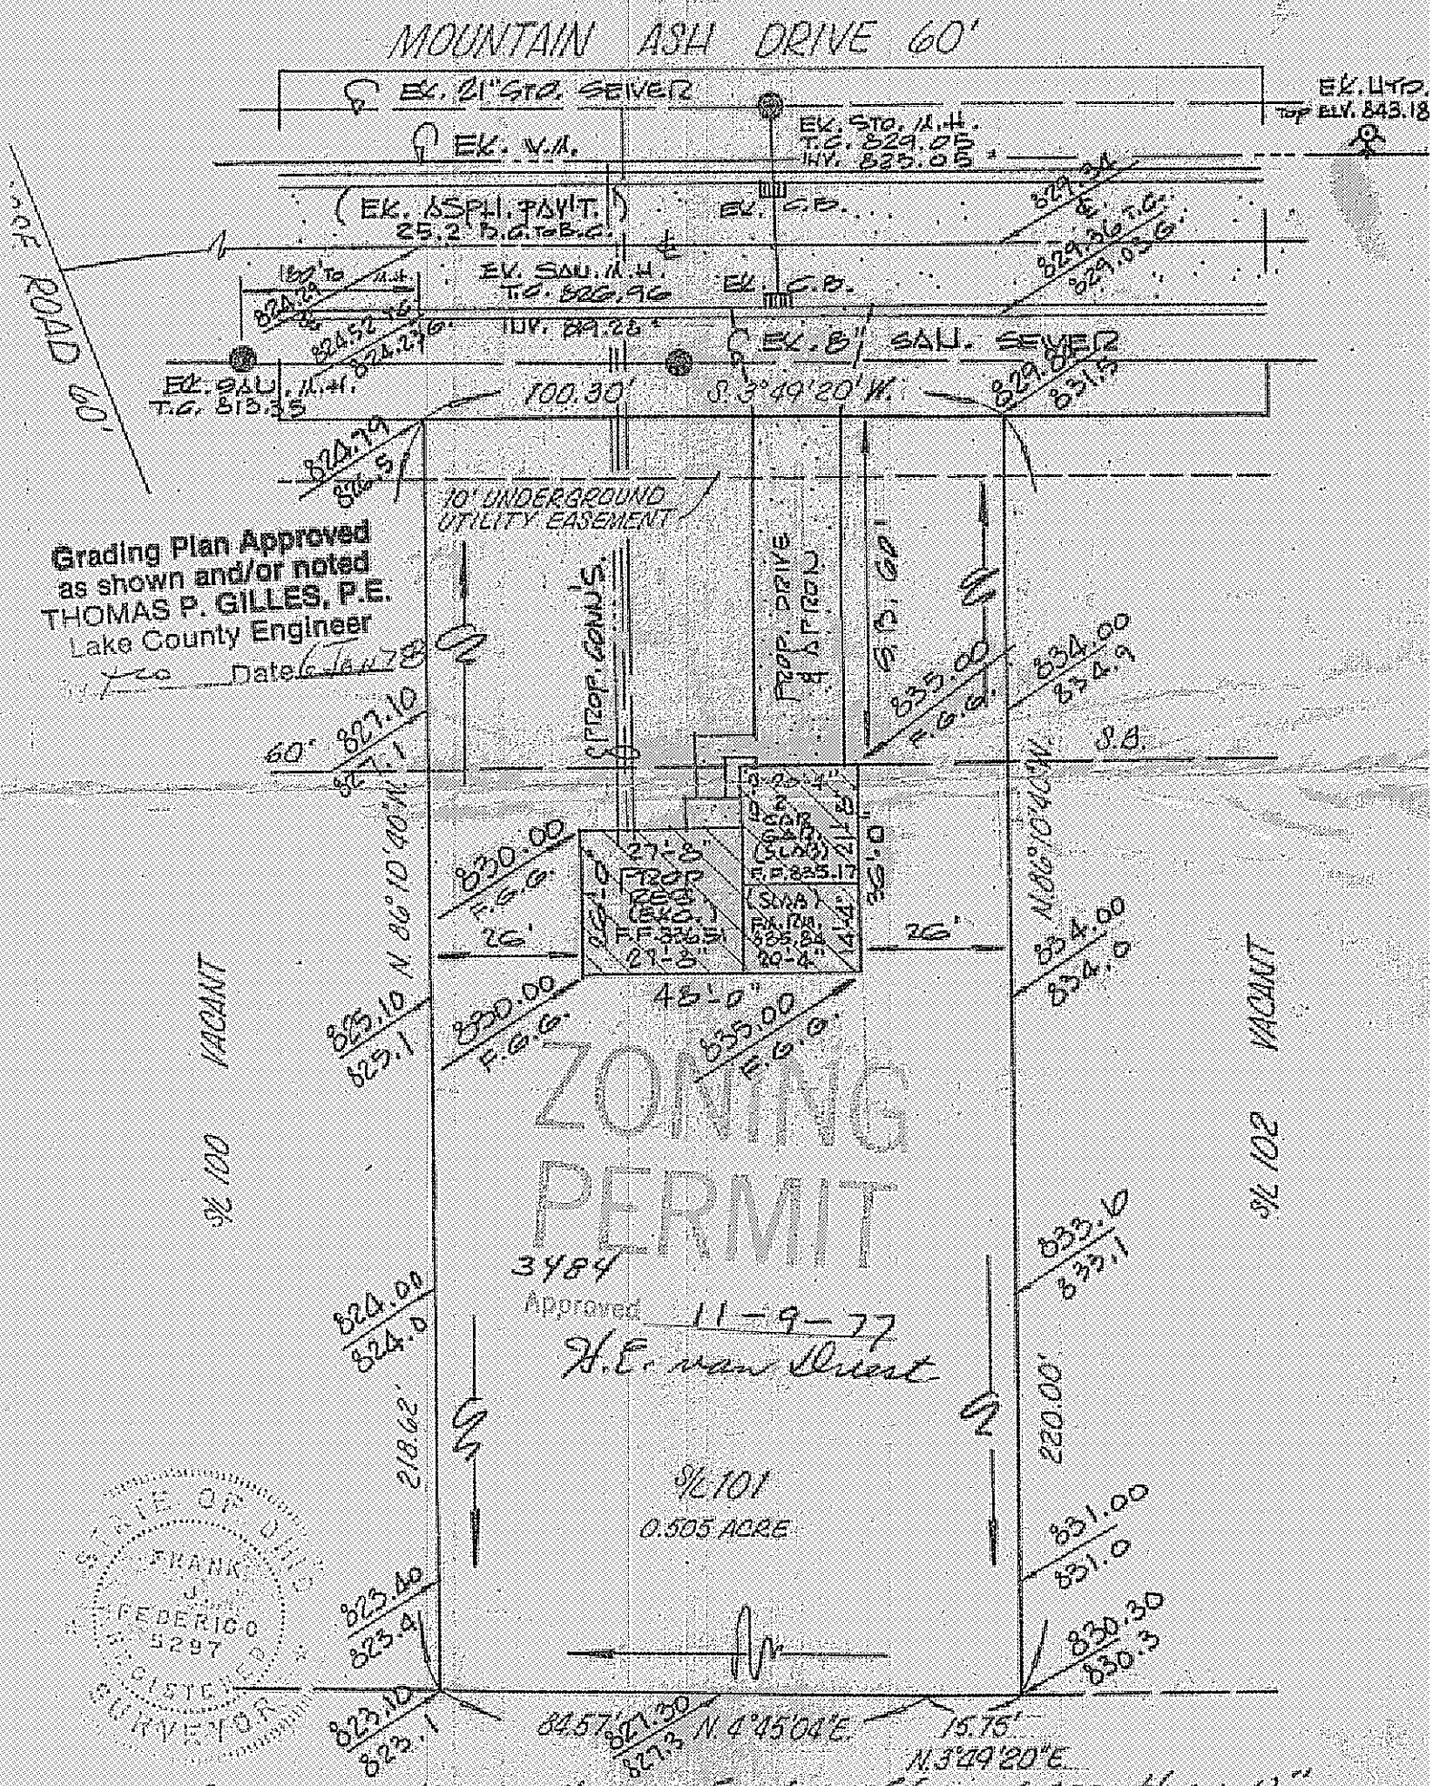

Grading Plan Approved as shown and/or noted
THOMAS P. GILLES, P.E.
Lake County Engineer
By [signature] Date 6 Jan 78

ZONING PERMIT

3484

Approved 11-9-77

H.E. van Duest

STATE OF OHIO FRANK J. FEDERICO 5297 REGISTERED SURVEYOR

IF PROPOSED HOUSE HAS A FOOTER ELEV. LESS THAN 12" ABOVE ℄ OF MOUNTAIN ASH DR. THAN THE FOOTER DRAINS CAN NOT BE TIED INTO EXISTING STM. SEWER.